


BANCROFT ST

57

CONGRESS ST

0.25 foot back from street line

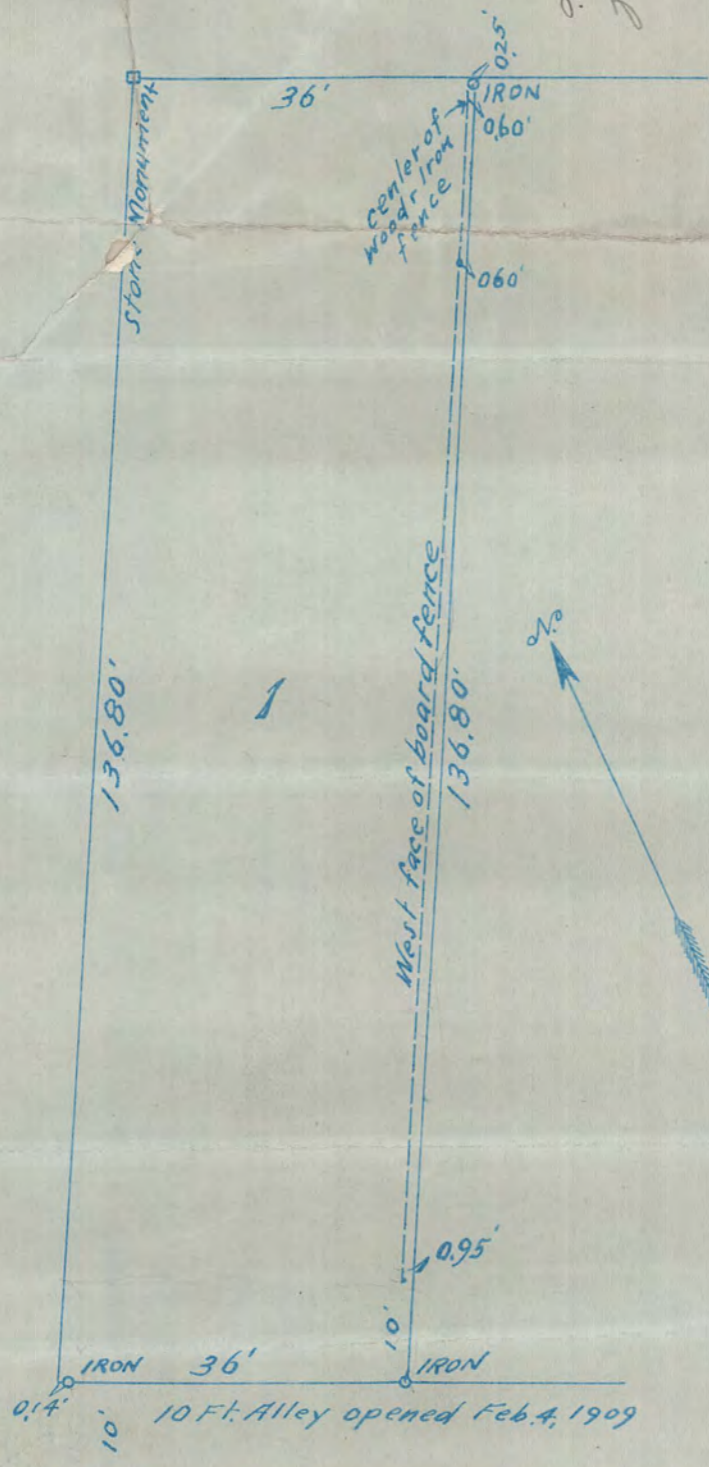

Scale 20 Ft. per Inch

State of Minnesota }
 County of Ramsey } ss T. Milton Fowble being first duly sworn deposes and says that he is a civil engineer and surveyor by profession and that he is a resident of the City of St. Paul Ramsey County, Minnesota.

He further deposes and says that in the month of September 1911 he made a survey of the premises shown on this diagram, being lot 1, of Martin's Rearrangement of part of Lots 1, 2, 3 and 4, Block 13 of Brown and Jackson's Addition to West St. Paul.

He further deposes and says that this diagram correctly and accurately represents the survey made by him of the foregoing described premises and correctly shows the present location of the fence shown hereon.

T. Milton Fowble

Subscribed and sworn to before me this 28th day of September A.D. 1911

James Tracy
 Notary Public, Ramsey Co Minn.
 My Commission expires January 21, 1913