

1312


SURVEY OF
Lots 21 & 22 Block 33.
Except the Southerly 51 1/2 ft of
LYMAN DAYTON ADD.

Scale 20 ft per in

FEB 24 - 1912

E. R. Schafer.
Surveyor.

FOURTH ST.

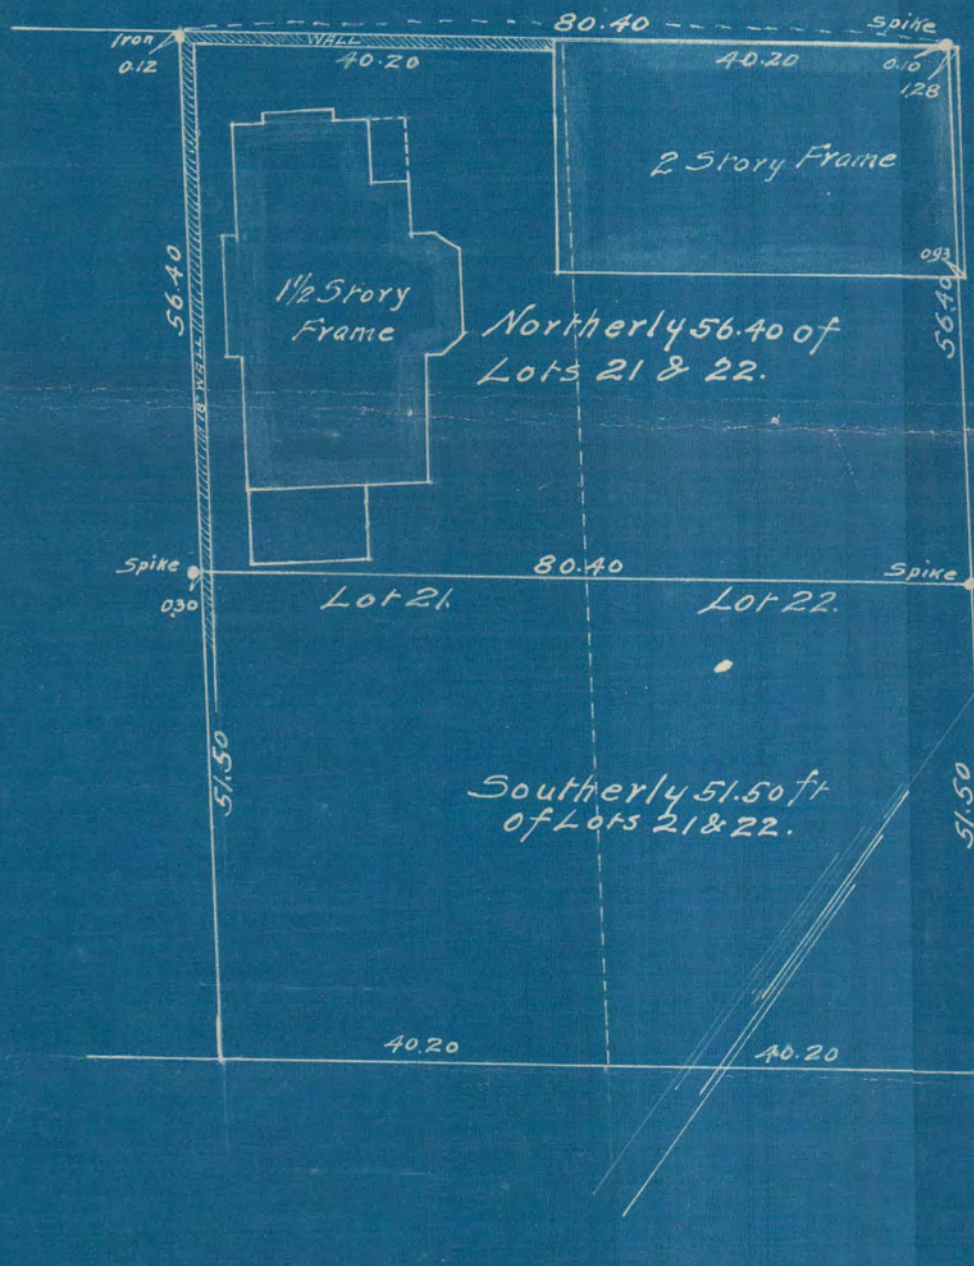

BATES AVE.

BATES

#1312