


E. THIRD

ST

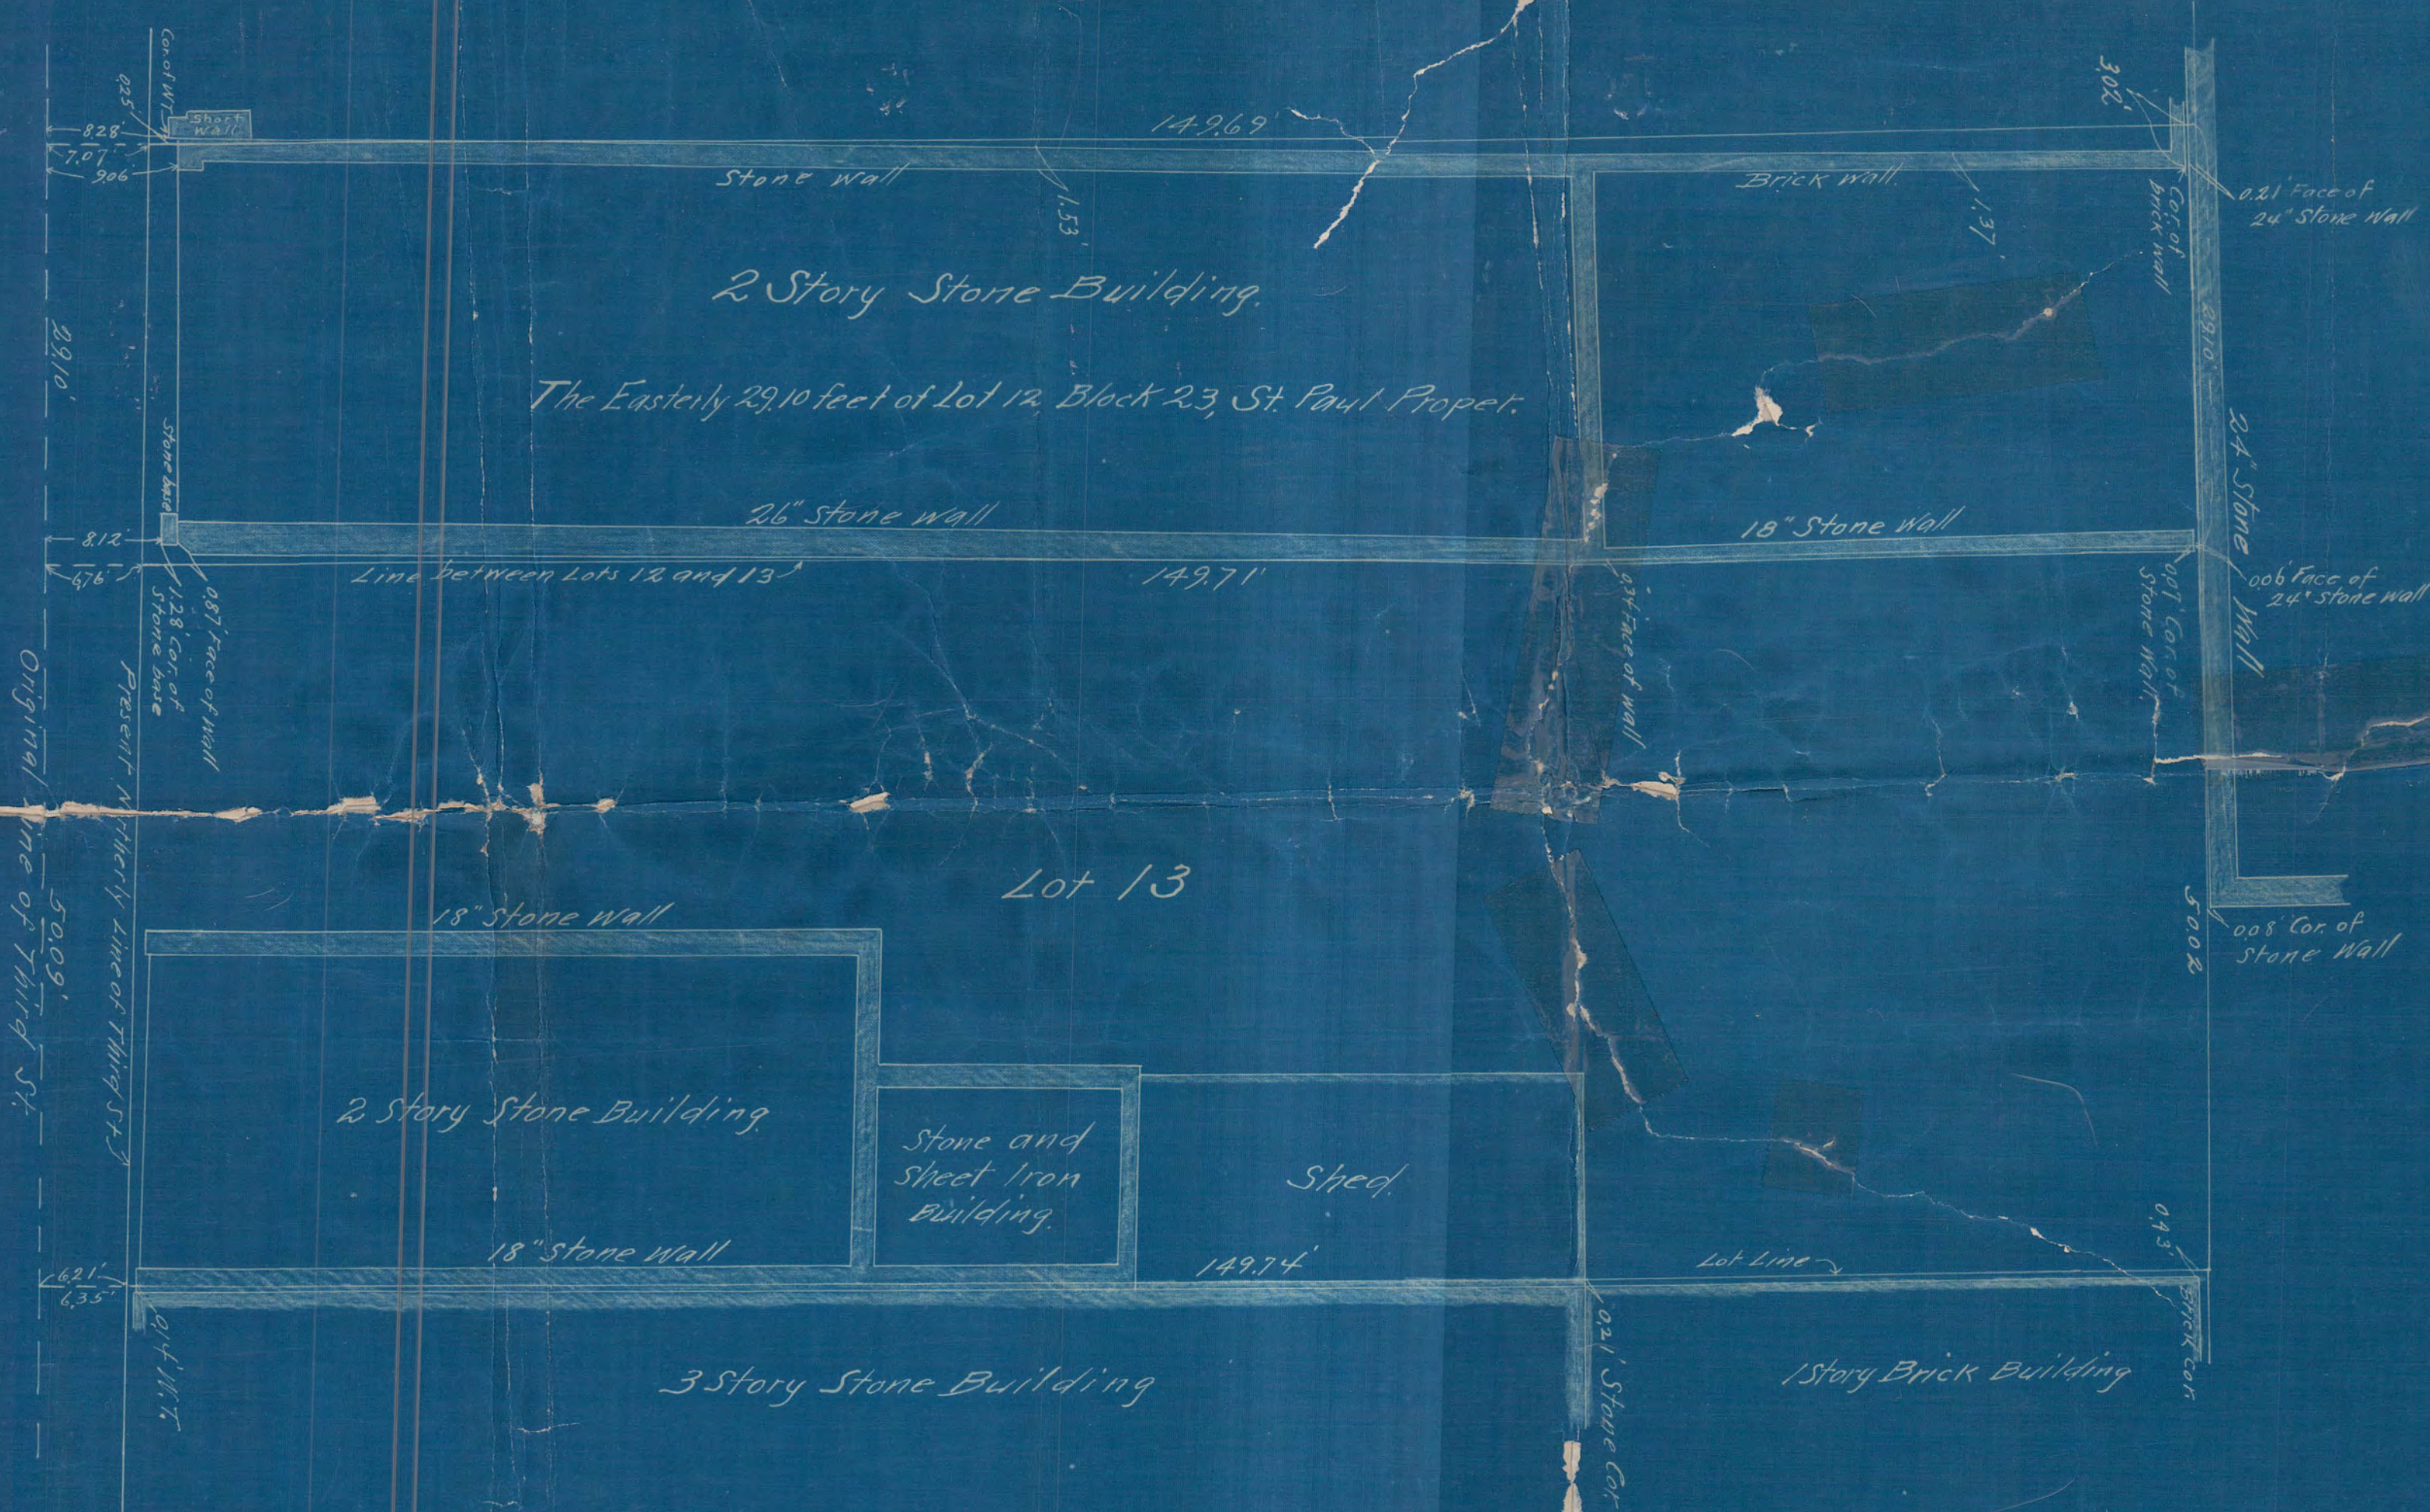

SURVEYED FOR
Wade Hampton Yardley.

Scale: 10 Ft. Per Inch.

We certify this diagram correctly represents
Lot 13 and the Eastern 29.10 feet of Lot 12, Block
23, St. Paul Proper, as surveyed by us in
the month of May 1912.

Jowble & Fitz,
Civil Engineers & Surveyors,
ST. PAUL, MINN.