


1336

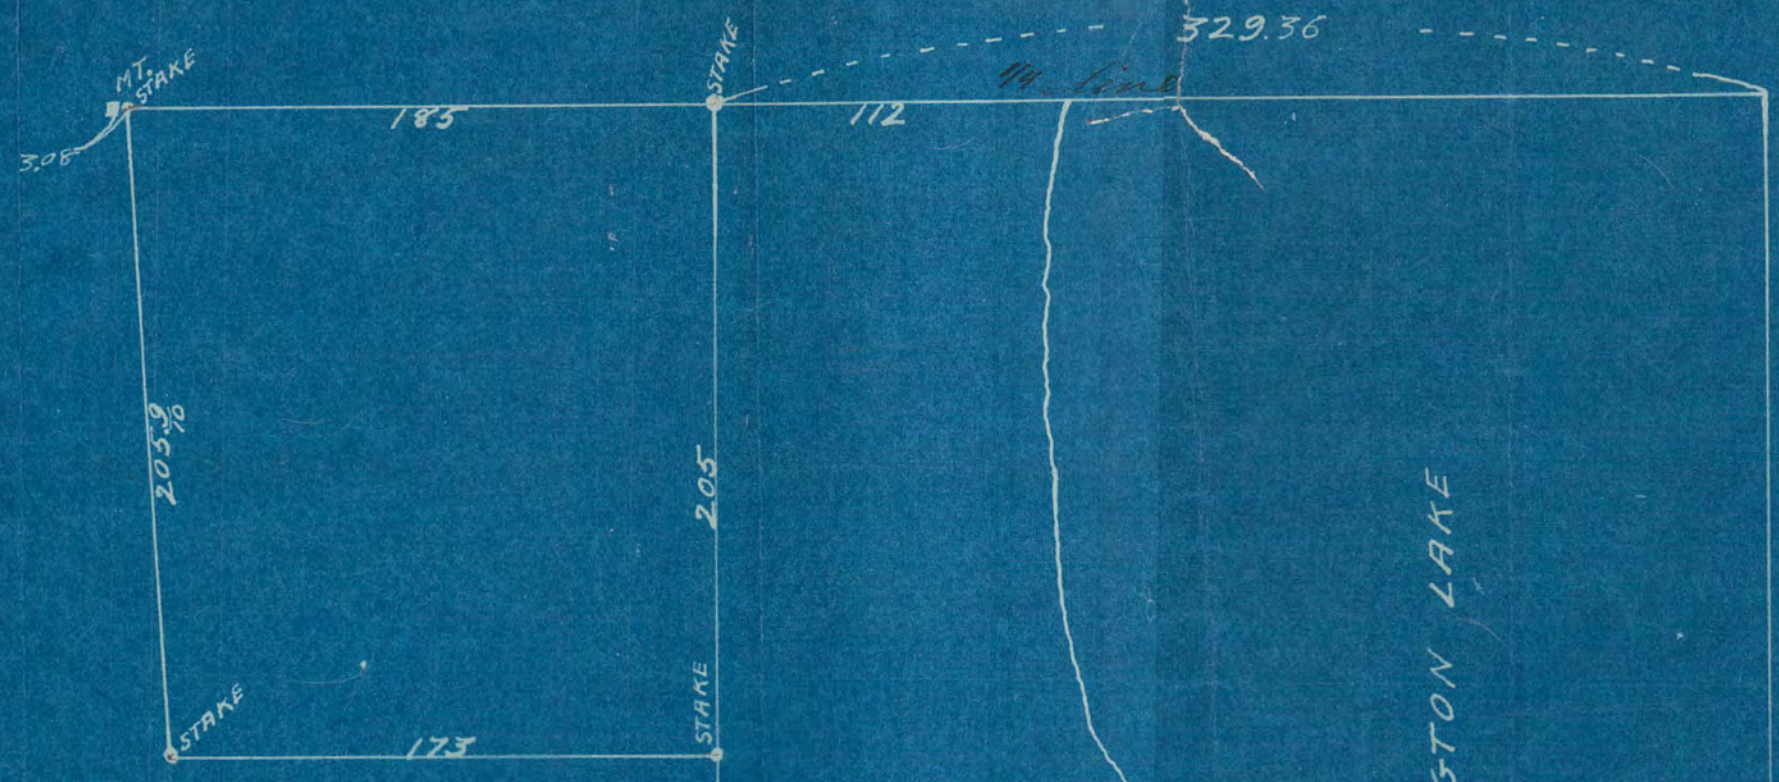

I hereby certify to having surveyed the
 E 1/2 of N.E. 1/4 of N.W. 1/4 of S.W. 1/4 Sec. 4, T. 29 R. 23
 and a trace described as follows. Commencing
 at a point on the West line of the E. 1/2
 of N.E. 1/4 of N.W. 1/4 of S.W. 1/4 Sec. 4, T. 29 R. 23.
 205 feet south of N.W. corner thereof;
 running thence west 173 feet; thence
 north 205.9 feet to the E. and W. 1/4 line
 ; thence east on 1/4 line 185 feet; thence
 south 205 feet to place of beginning

Frank J. Tavernier
 Scale 60 Ft = 1 Inch Surveyor
 509 Court Block
 ST. PAUL, MINN.
 6-24-1912

E. 1/2 OF N.E. 1/4 OF N.W. 1/4 OF S.W. 1/4
 SEC. 4 T. 29 - 23



1336