


DAYTON AND IRVINE'S ADD
 SURVEY OF
 LOT 5 AND PART OF LOTS 4 AND 7. BL 64
 SCALE 20'=1"

1355

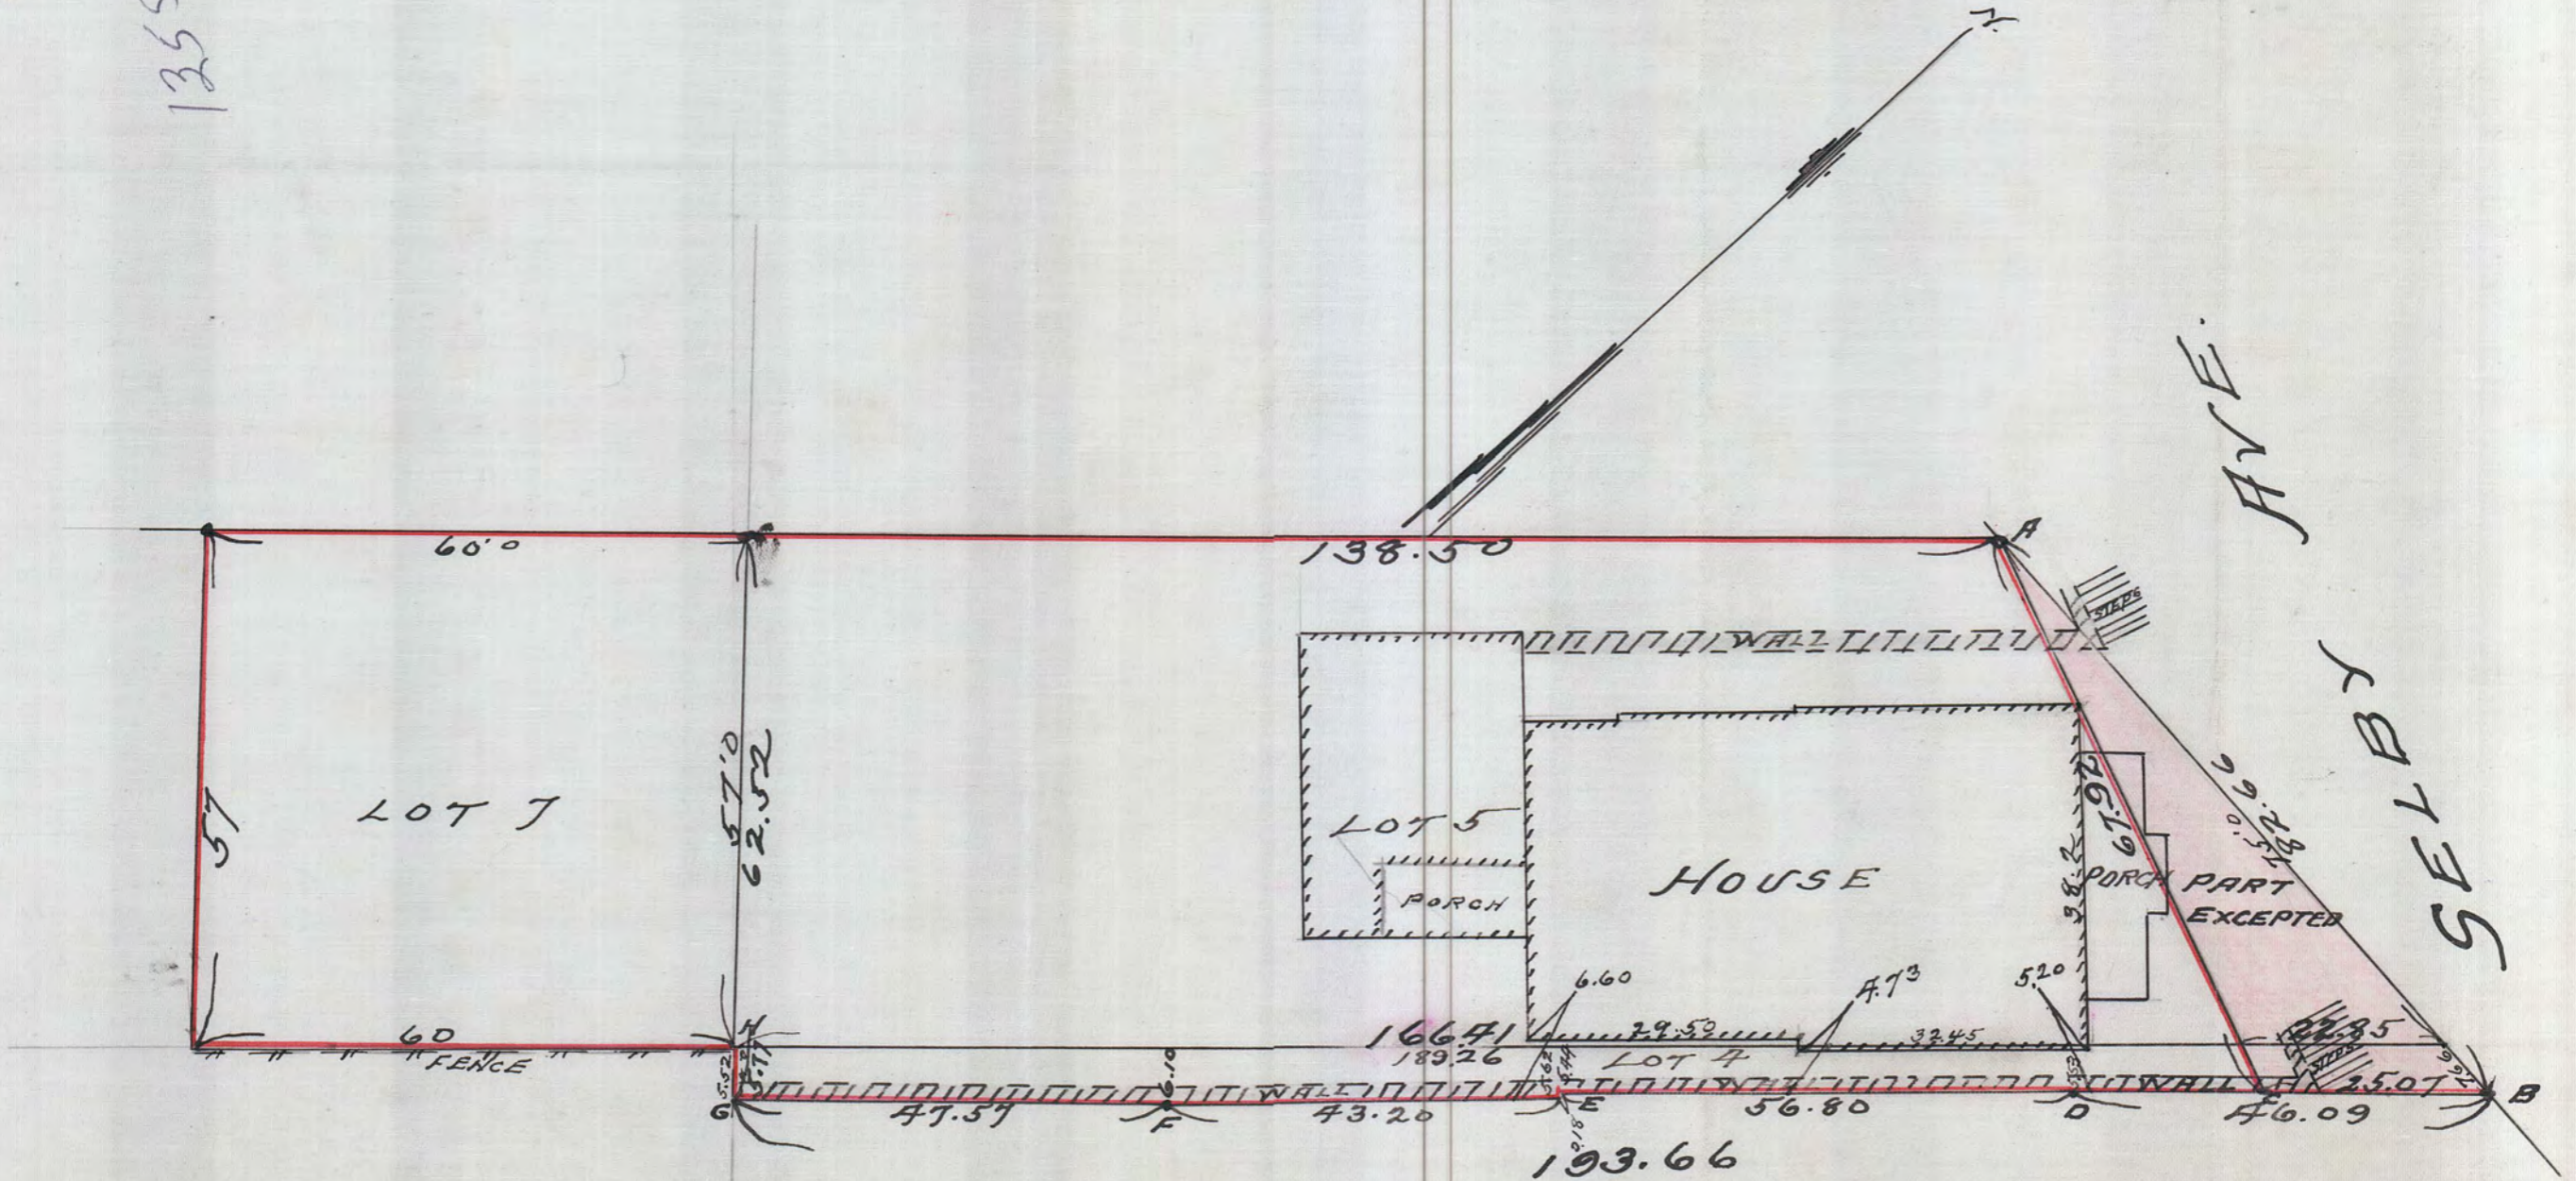

#1355