

1376

SURVEY OF

Lots 9, and 10, ex street, Block 83, Dayton & Irvines Addition. Lot 1, Block 11, Rondo's Addition, ex. part in Chamber's Rearrangement,

Lot 1, Block 11, Chamber's Rearrangement of Block 11, Rondo's Addition, ex. north 10 ft. and west 15 of south 10 ft.

Scale 1" = 30'


July 24, 1912.

Subscribed and sworn to before me

this 7th day of August, A.D. 1912. *Robert Holterhoff*

James Schaeffer *R. Holterhoff*

Notary Public, Ramsey County, Minnesota
Commission expires Oct. 17, 1913.

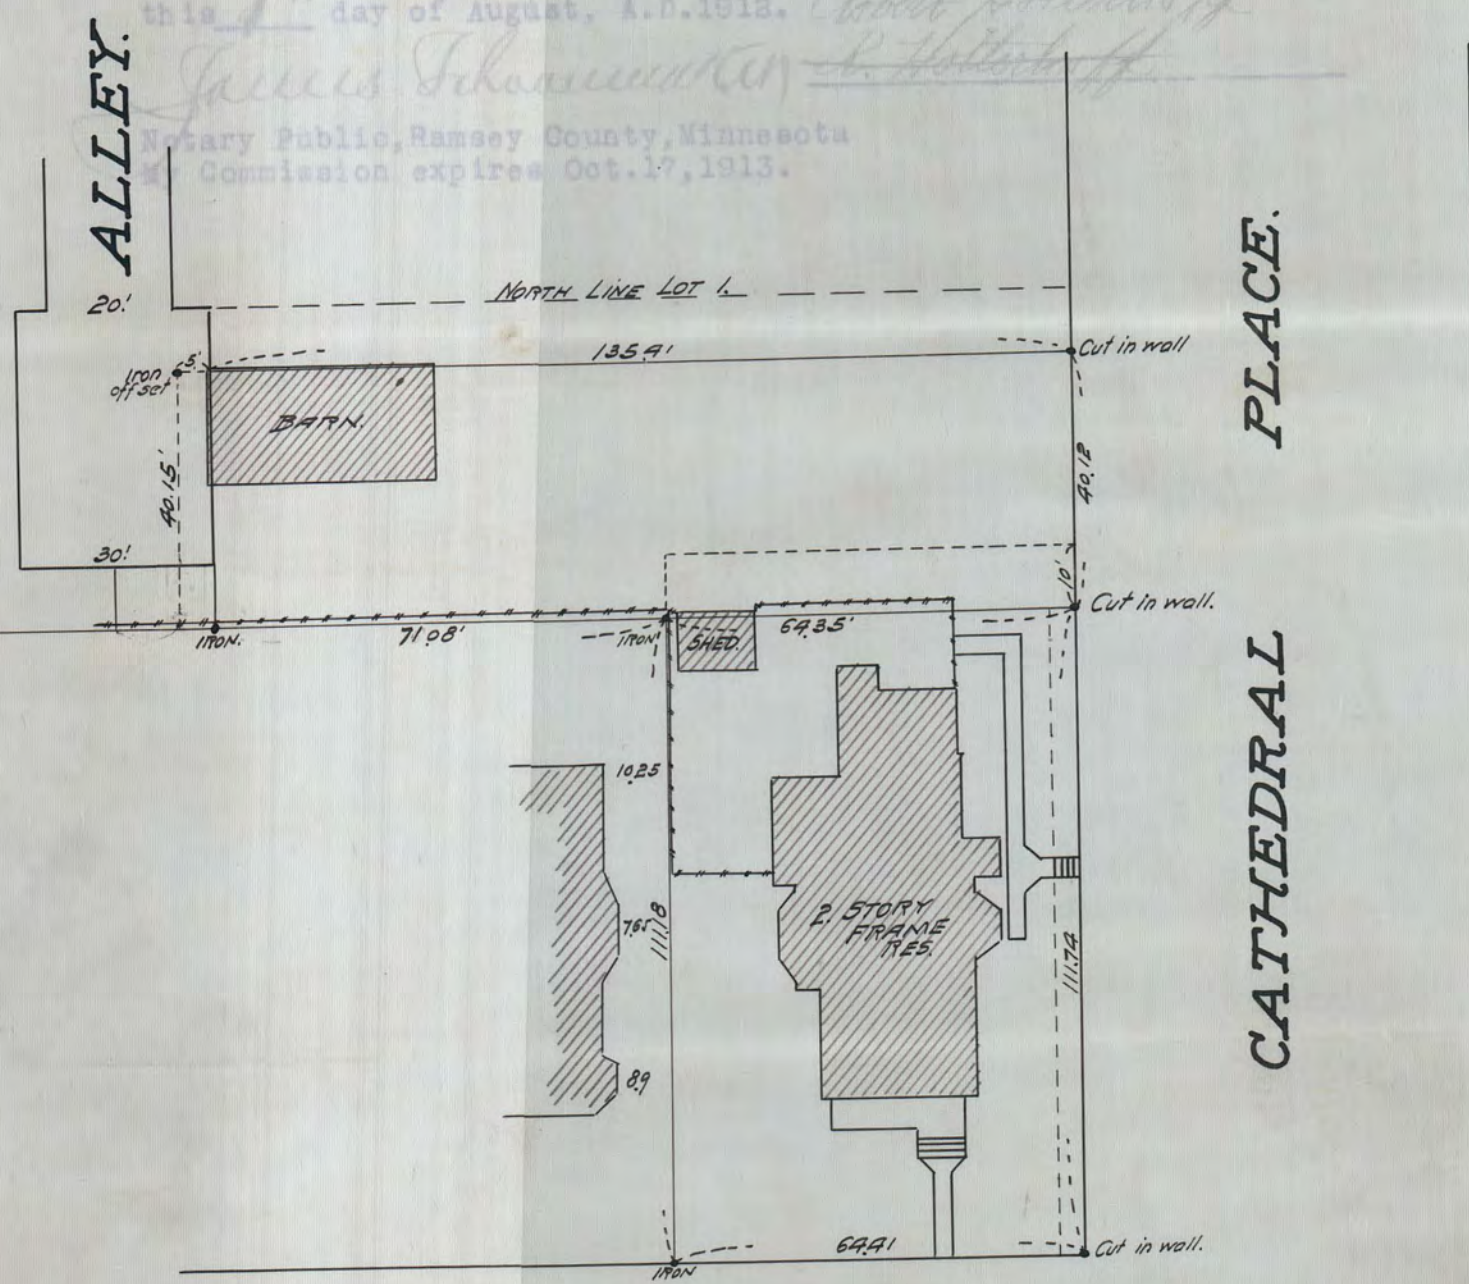

NELSON AVE.

1376