


OCT 1912

SCALE 10' = 1"

158.4

John G. E.

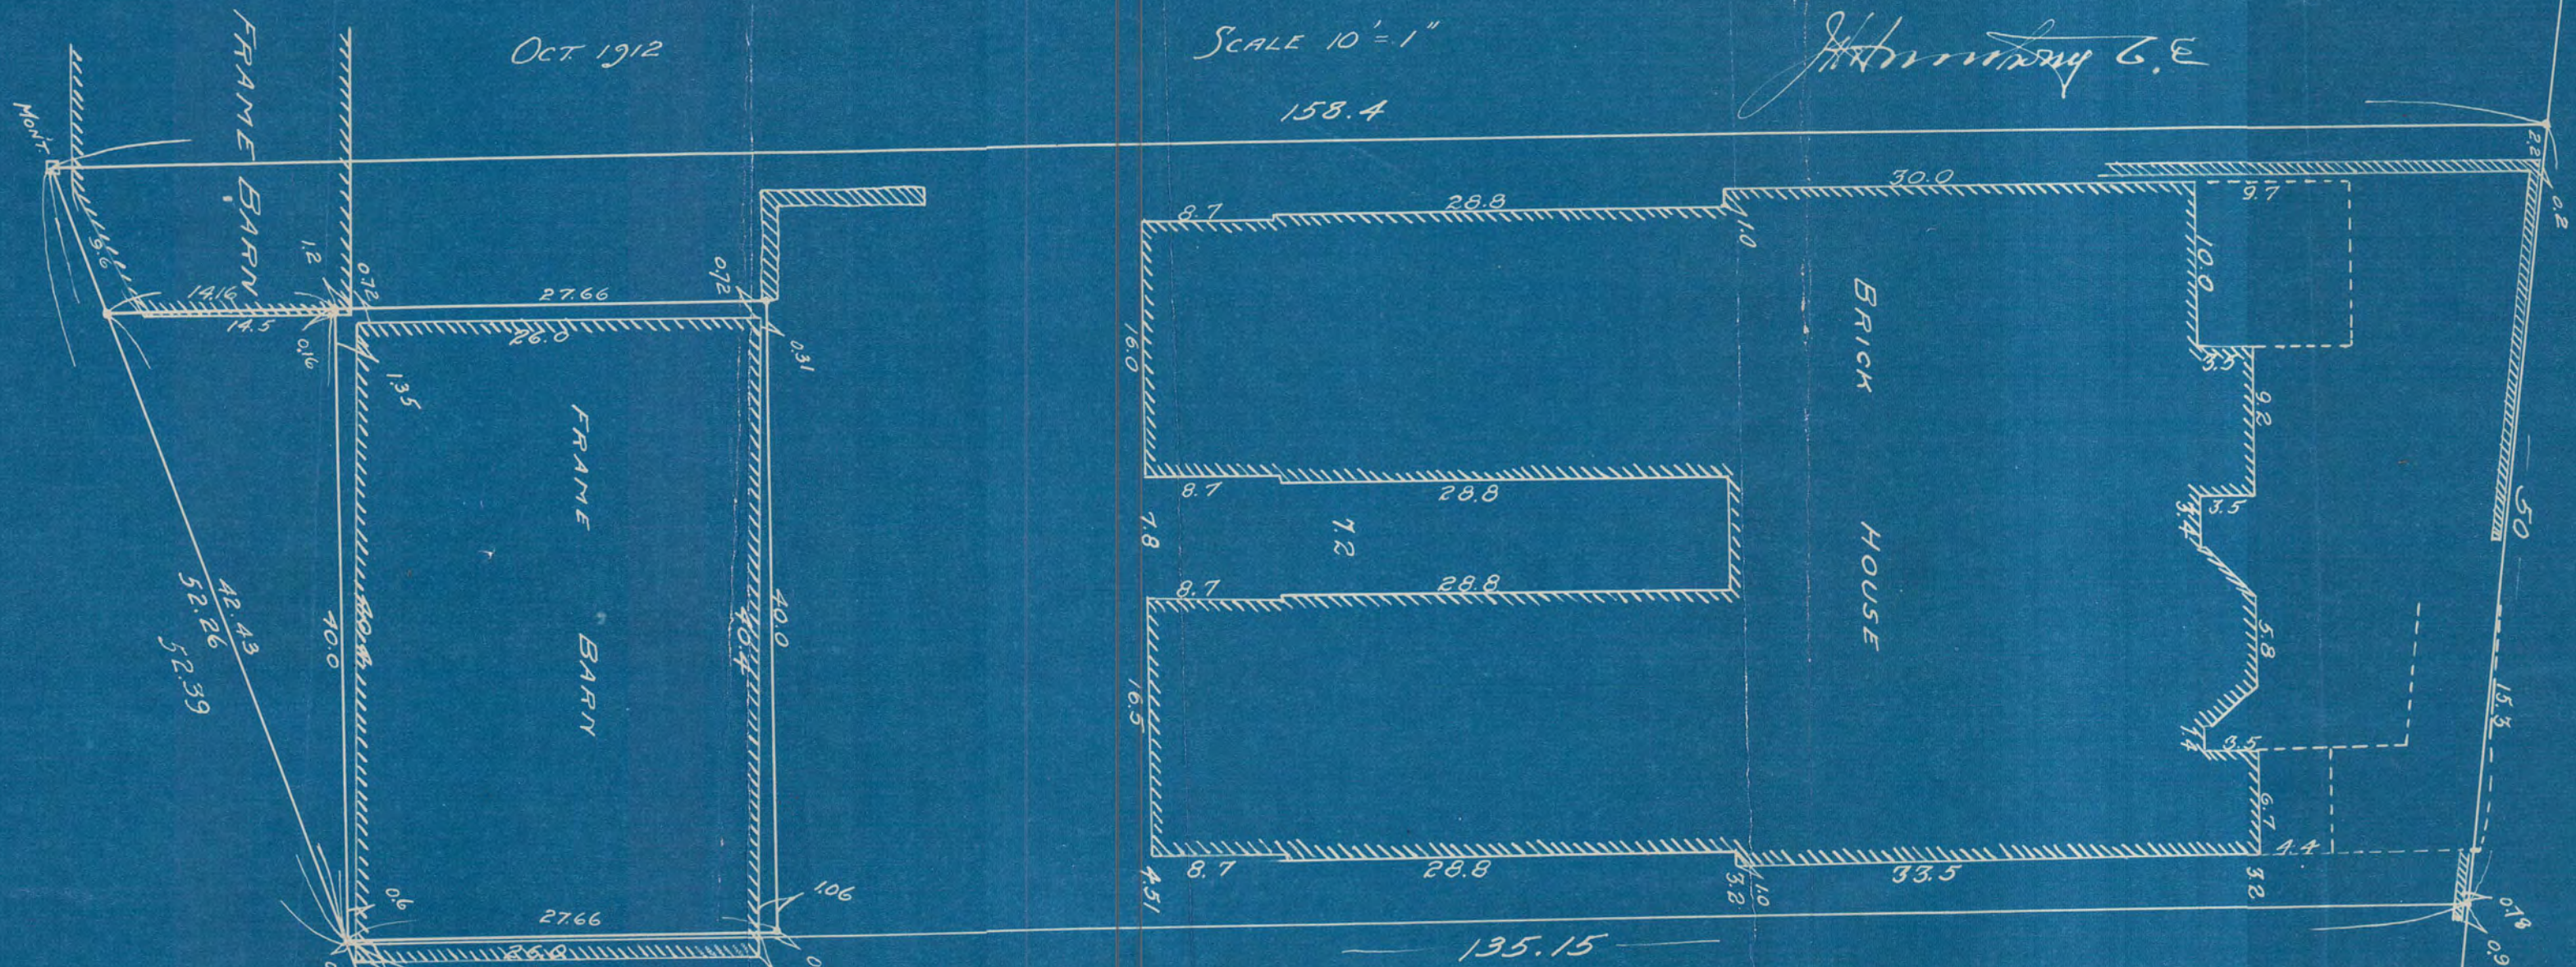

SUMMIT AVE.

SURVEY OF THAT PART OF BLOCK 1 BUTMAN'S ADDN TO ST. PAUL DESCRIBED AS FOLLOWS;  
 COMMENCING AT THE N<sup>W</sup> 1/4 CORNER OF SAID BLOCK 1, THENCE E<sup>1/4</sup> ALONG THE SOUTH LINE OF SUMMIT AVE. 50.0 FT.,  
 THENCE S E<sup>1/4</sup> PARALLEL WITH THE W<sup>1/4</sup> LINE OF SAID BLOCK 1 135.15 FT. TO THE S<sup>1/4</sup> LINE OF SAID BLOCK 1, THENCE  
 S<sup>1/4</sup> W<sup>1/4</sup> ALONG THE S<sup>1/4</sup> LINE OF SAID BLOCK 1, 52.39 FT. TO THE W<sup>1/4</sup> LINE SAID BLOCK 1, THENCE N<sup>1/4</sup> ALONG THE  
 W<sup>1/4</sup> LINE SAID BLOCK 1, 158.4 FT. TO THE PLACE OF BEGINNING EXCEPTING THEREFROM THE FOLLOWING DESCRIBED TRACT  
 COMMENCING AT THE S<sup>W</sup> 1/4 CORNER SAID BLOCK 1, THENCE N<sup>1/4</sup> ALONG THE S<sup>1/4</sup> LINE SAID BLOCK 1, 52.26 FT, THENCE N<sup>W</sup> 1/4  
 PARALLEL WITH THE W<sup>1/4</sup> LINE SAID BLOCK 1, 27.66 FT, THENCE S<sup>W</sup> 1/4 AT RIGHT ANGLES WITH THE W<sup>1/4</sup> LINE SAID BLOCK 1  
 40.0 FT, THENCE S E<sup>1/4</sup> PARALLEL WITH SAID W<sup>1/4</sup> LINE BLOCK 1 27.66 FT, THENCE E<sup>1/4</sup> AT RIGHT ANGLES TO PLACE OF BEGINNING.  
 ALSO EXCEPTING THEREFROM THE FOLLOWING DESCRIBED TRACT IN SAID BLOCK 1: COMMENCING AT THE S<sup>W</sup> 1/4 CORNER OF  
 SAID BLOCK 1 THENCE N<sup>1/4</sup> ALONG THE S<sup>1/4</sup> LINE SAID BLOCK 1, 52.26 FT, TO THE PLACE OF BEGINNING OF THE FOLLOWING  
 DESCRIBED TRACT, THENCE S<sup>W</sup> 1/4 AT RIGHT ANGLES WITH THE W<sup>1/4</sup> LINE SAID BLOCK 1, 40.0 FT, THENCE S<sup>1/4</sup> W<sup>1/4</sup> PARALLEL  
 WITH SAID W<sup>1/4</sup> LINE BLOCK 1, 14.5 FT. TO THE S<sup>1/4</sup> LINE SAID BLOCK 1, THENCE N<sup>1/4</sup> ALONG SAID S<sup>1/4</sup> LINE 14.5 FT. TO PLACE  
 OF BEGINNING.

# 1389