1404

IRVINES ADD

SURVEY OF

LOTS 10. 11 AND 12 BL 193

AUG-1912

JENS PEDERSEN SURV.

SCALE 10'=1"

Exhibit A.

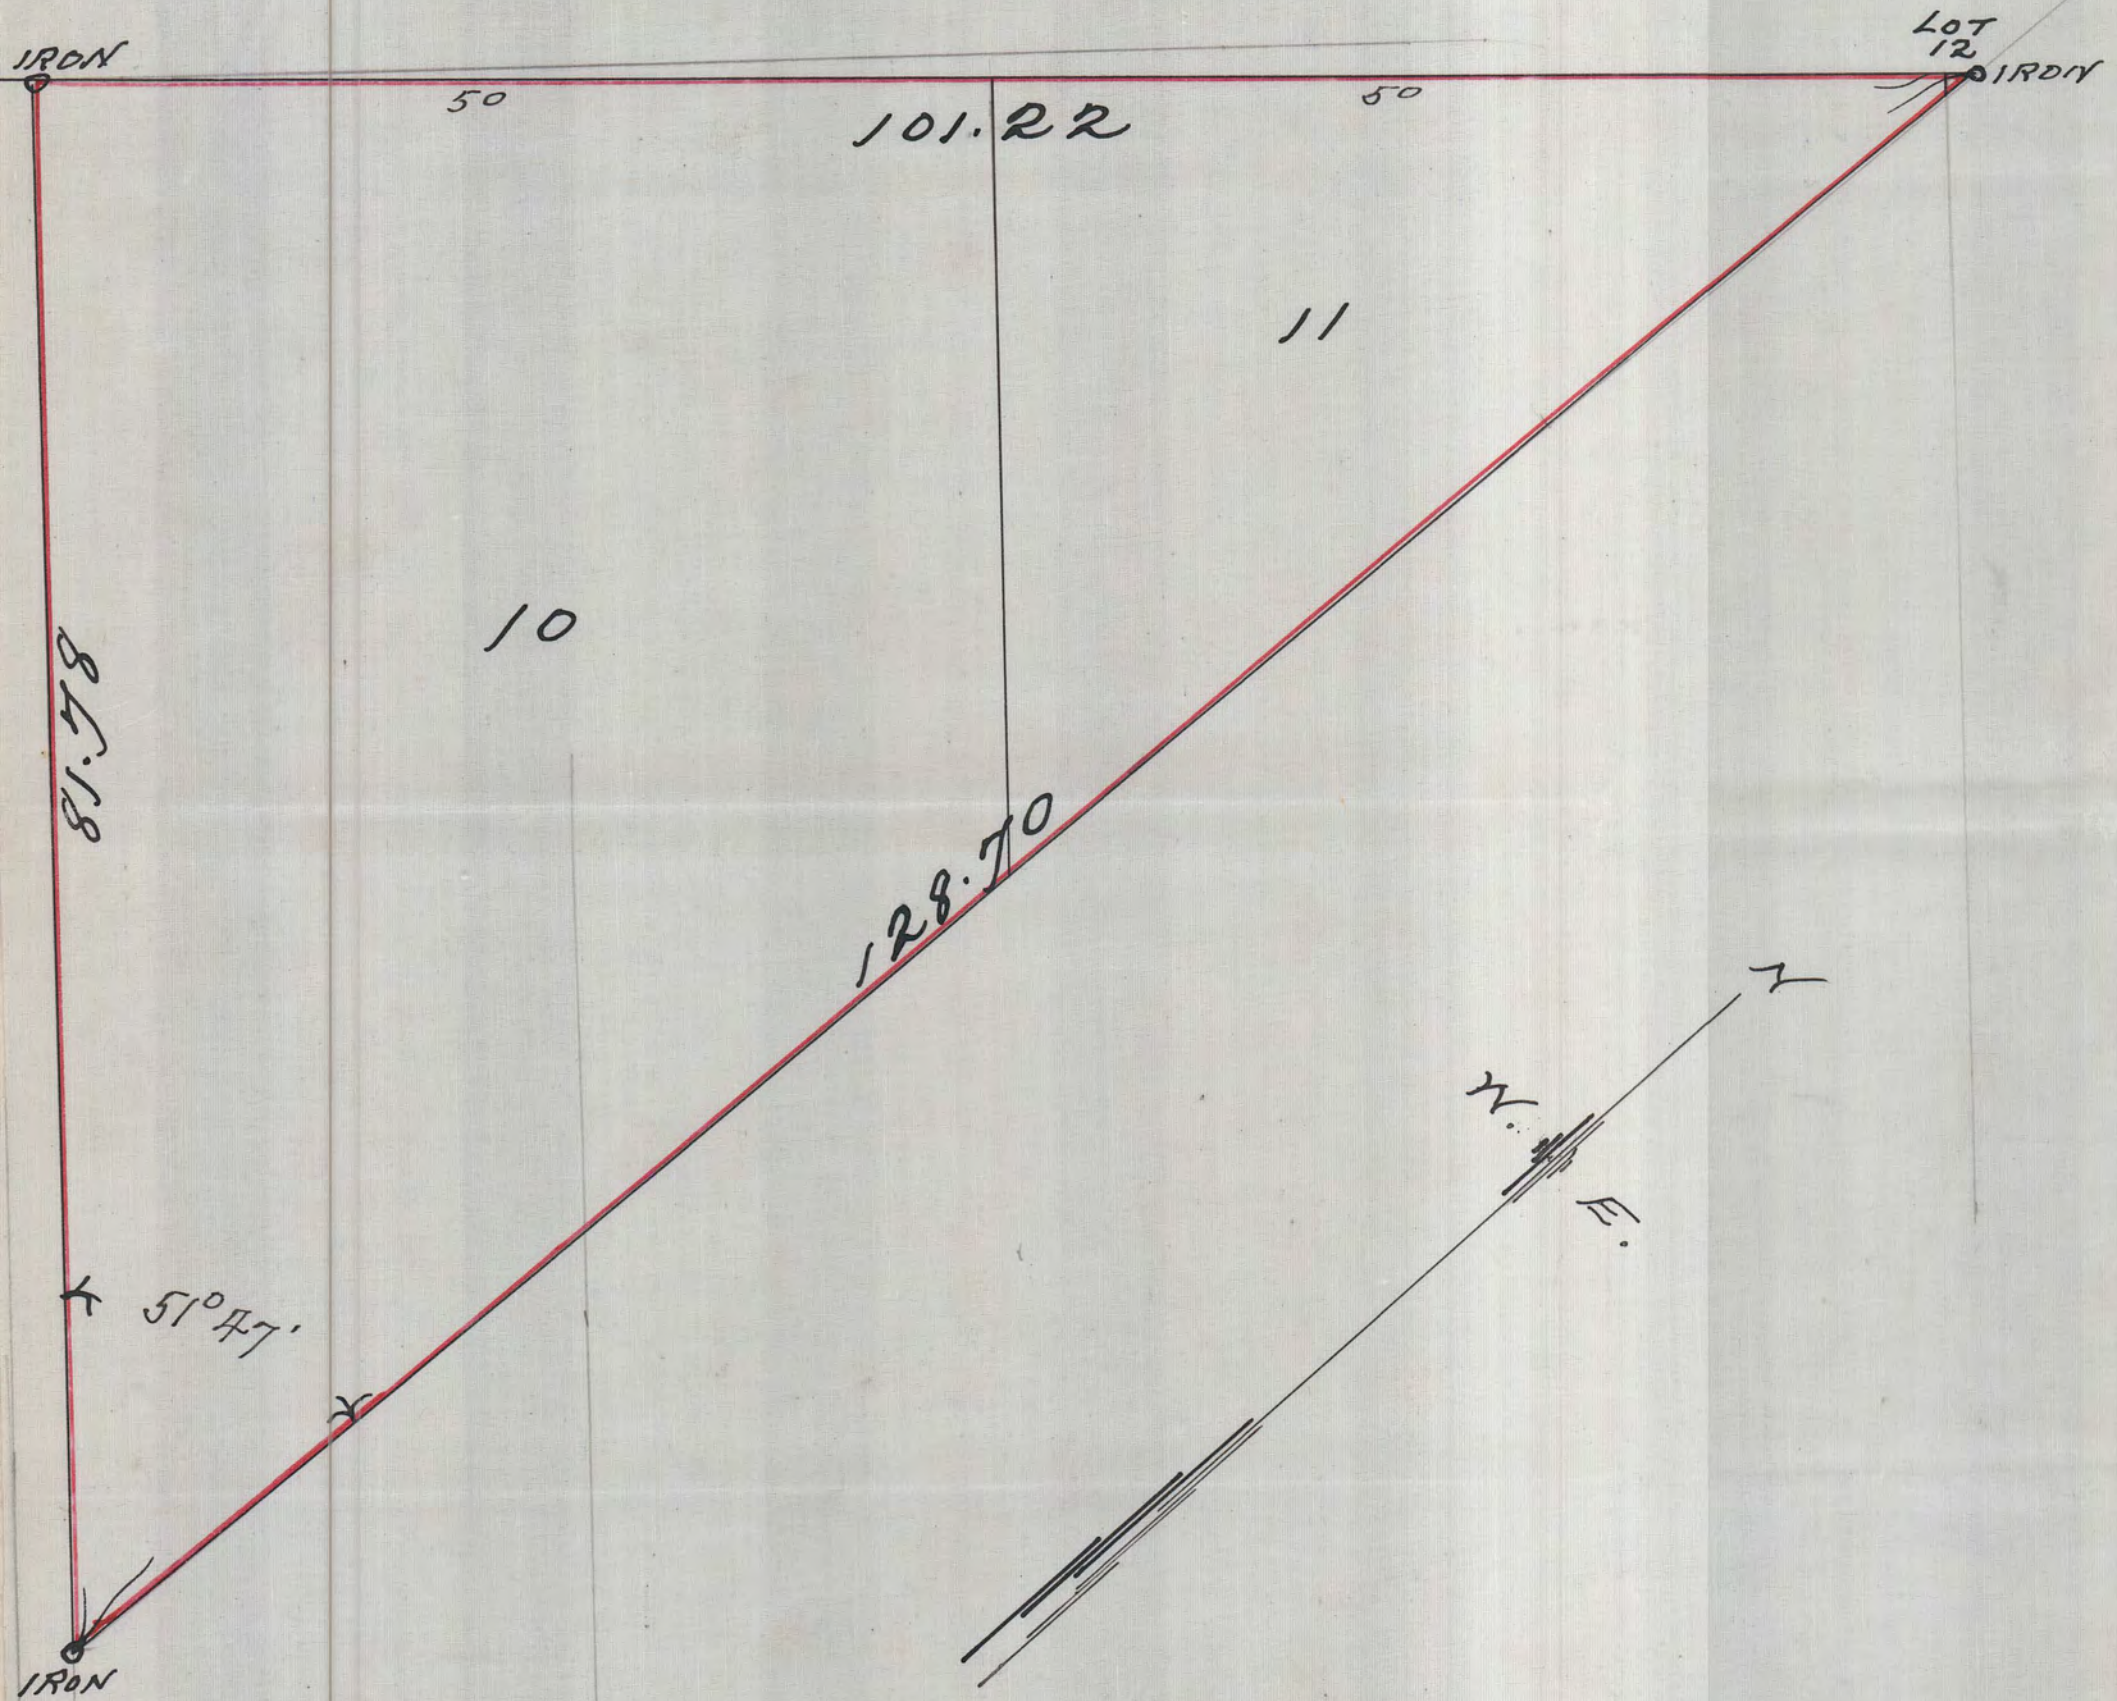

INDIANA AVE.

#1404