


State of Minnesota, County of Ramsey, ss.

Robert R. Godfrey on oath says he is a Civil Engineer and surveyor, and has been such for more than nine years last past, at the City of St. Paul, Minnesota; that on December 5th 1912 he located upon the ground the lots and blocks indicated upon the accompanying plat and described as follows: those tracts or parcels of land situated in Ramsey County, Minnesota, known as: Lots 1, 2, 3, 4, 5 and 6 in Block 63; Lots 10, 11 and 12 in Block 65; Lot 13 in Block 67; Lots 1, 21 and 22 in Block 69; Lots 2 and 3 in Block 70; Lots 9, 10, 11, 12, 14, 15 and 16, in block 71; Lots 7, 8, 22, 23 and 24, in Block 72; Lots 2, 3, 4, 13, 14, 17, 18, 19 and 20 in Block 73; Block 74; Block 75; and Block 76; All in the West St. Paul Real Estate and Improvement Syndicate Addition No. 6; also lots 6 and 7 in Block 6 of Smith's Subdivision of Block 6 of Brown and Jackson's Addition to West St. Paul; all according to the recorded plats of said additions on file and of record in the office of the register of deeds in and for said County and found the same and each and all thereof wholly vacant and unoccupied, and not in the possession or occupancy of any person or persons whatsoever.

Robert R. Godfrey
Civil Eng^r & Surveyor.

Subscribed and sworn to before me
this 13 day of December, A.D. 1912.

M. Nelson
Notary Public, Ramsey County, Minnesota,
My Commission Expires Dec 4/1914

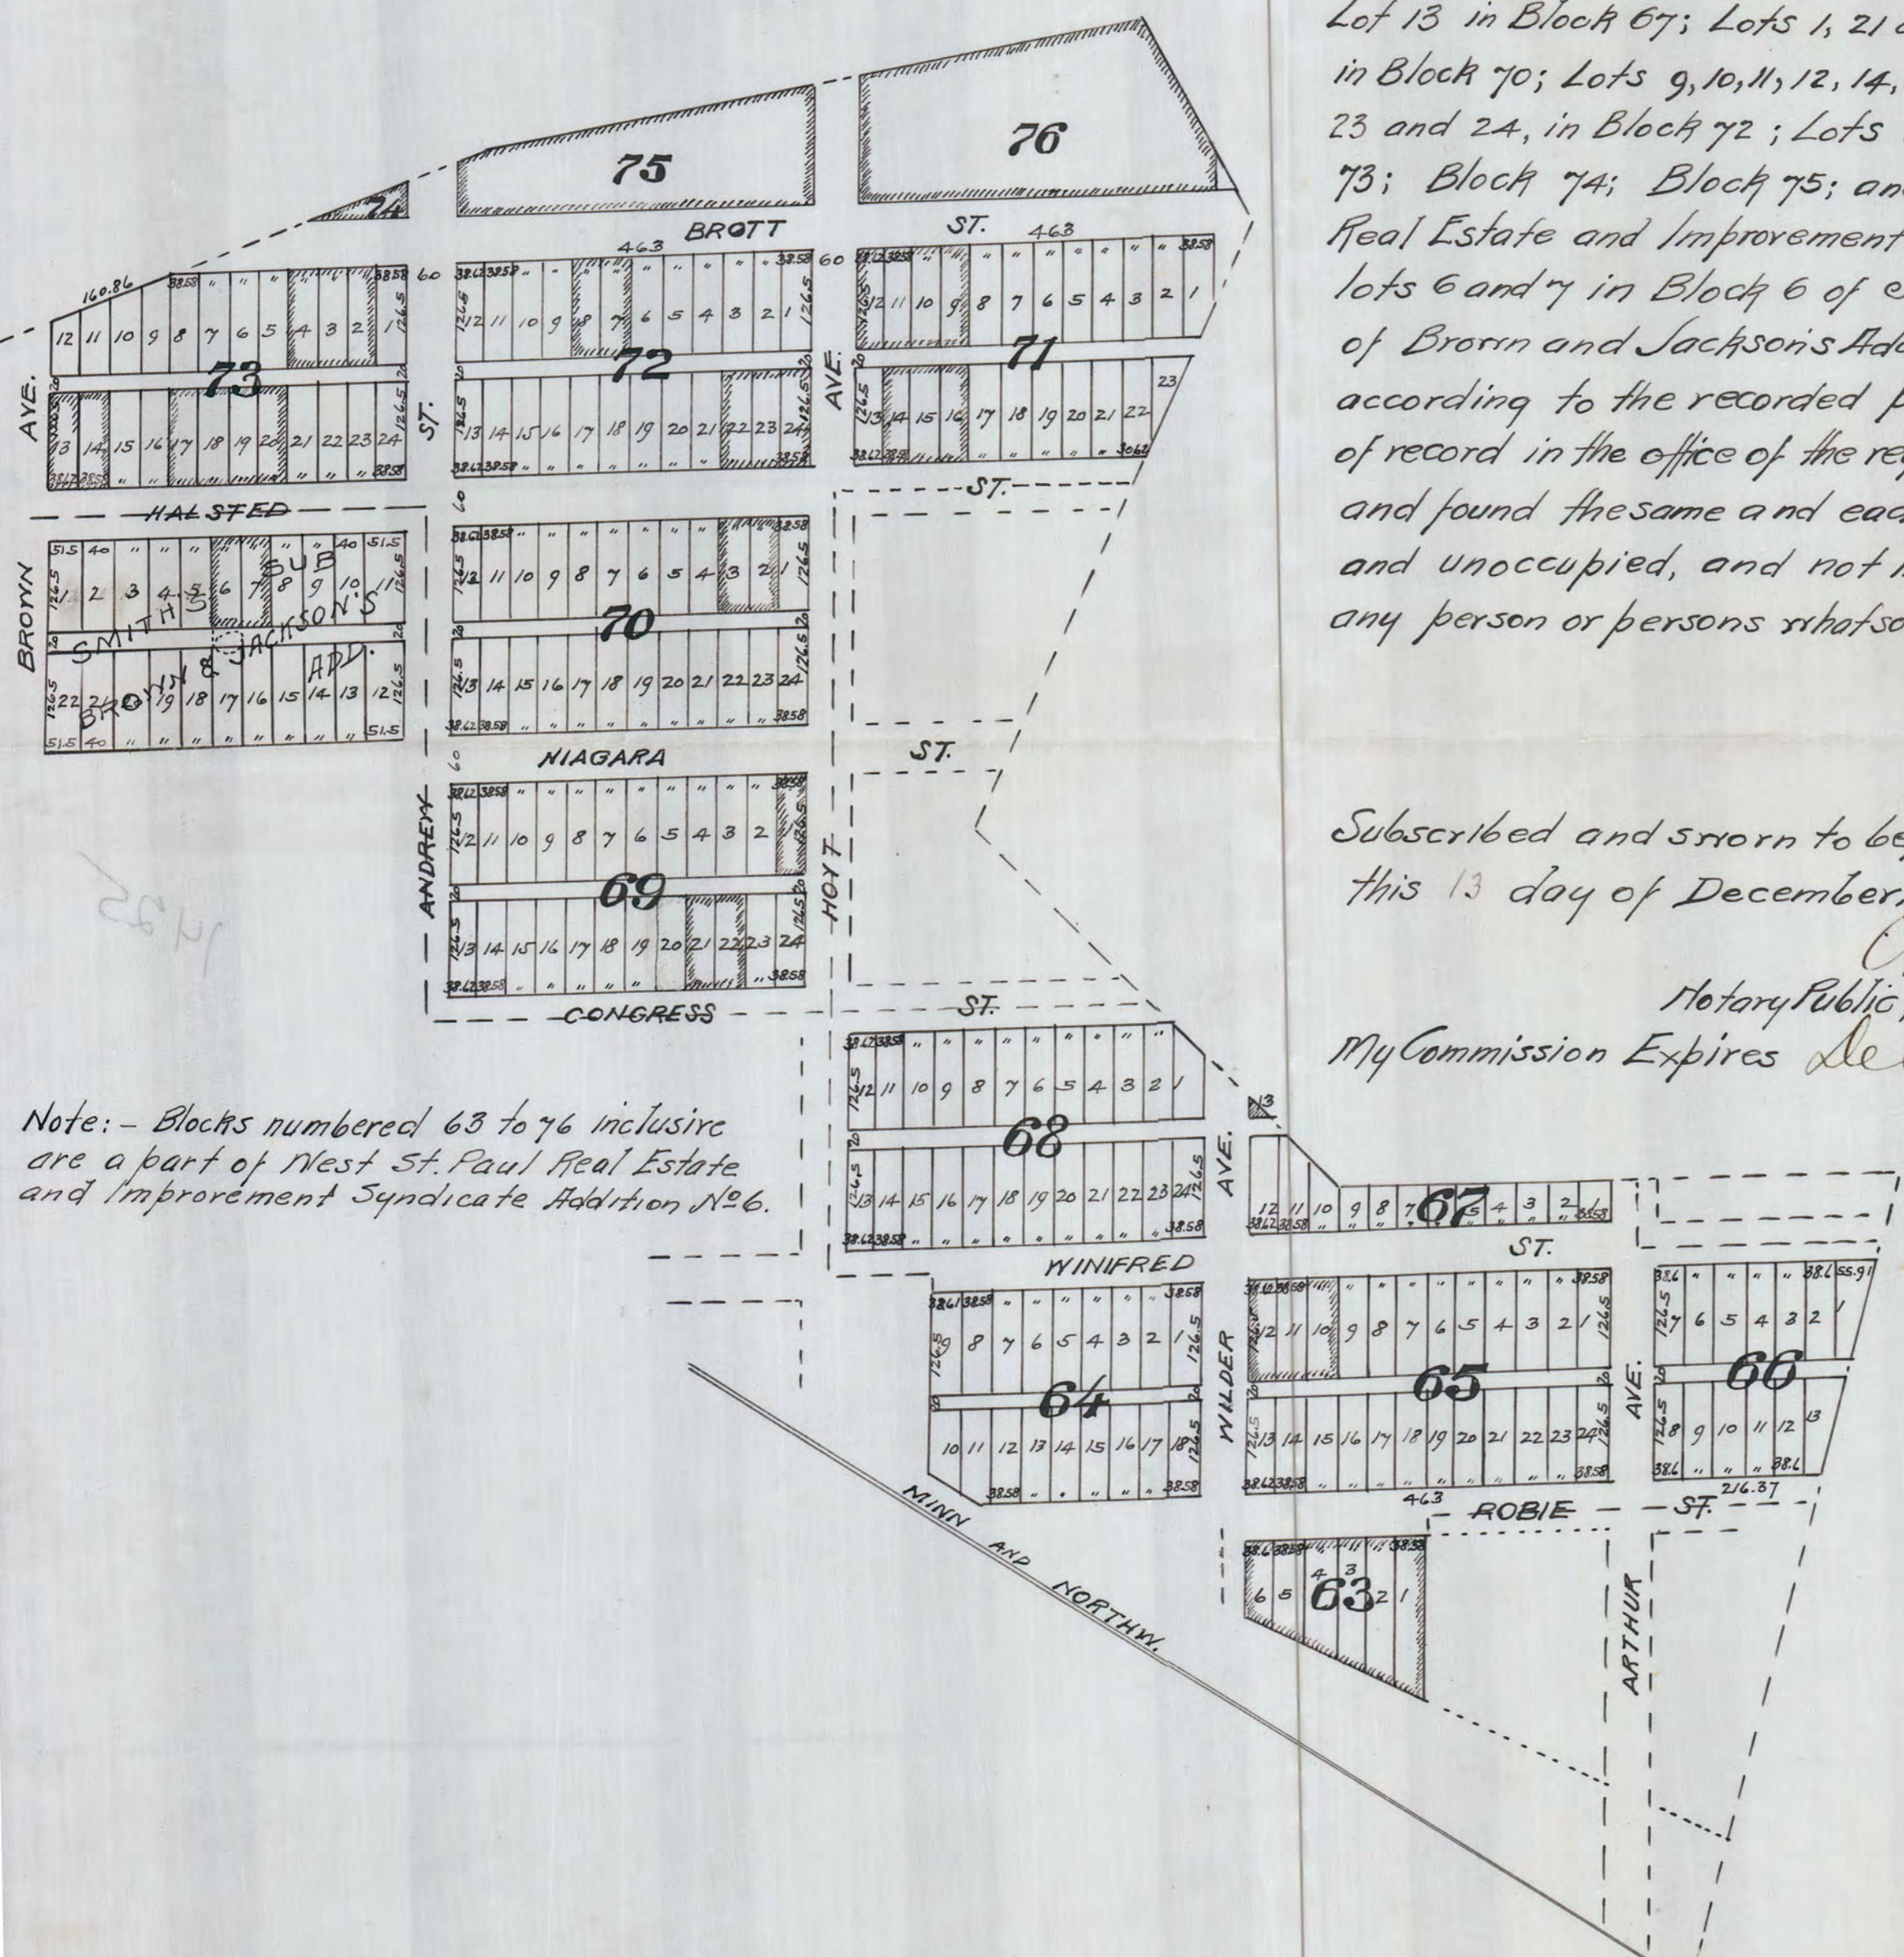

Note: - Blocks numbered 63 to 76 inclusive are a part of West St. Paul Real Estate and Improvement Syndicate Addition No. 6.

1425