

SELBY


AVE.

AVE.

WESTERN

"THE ANGUS"

1435

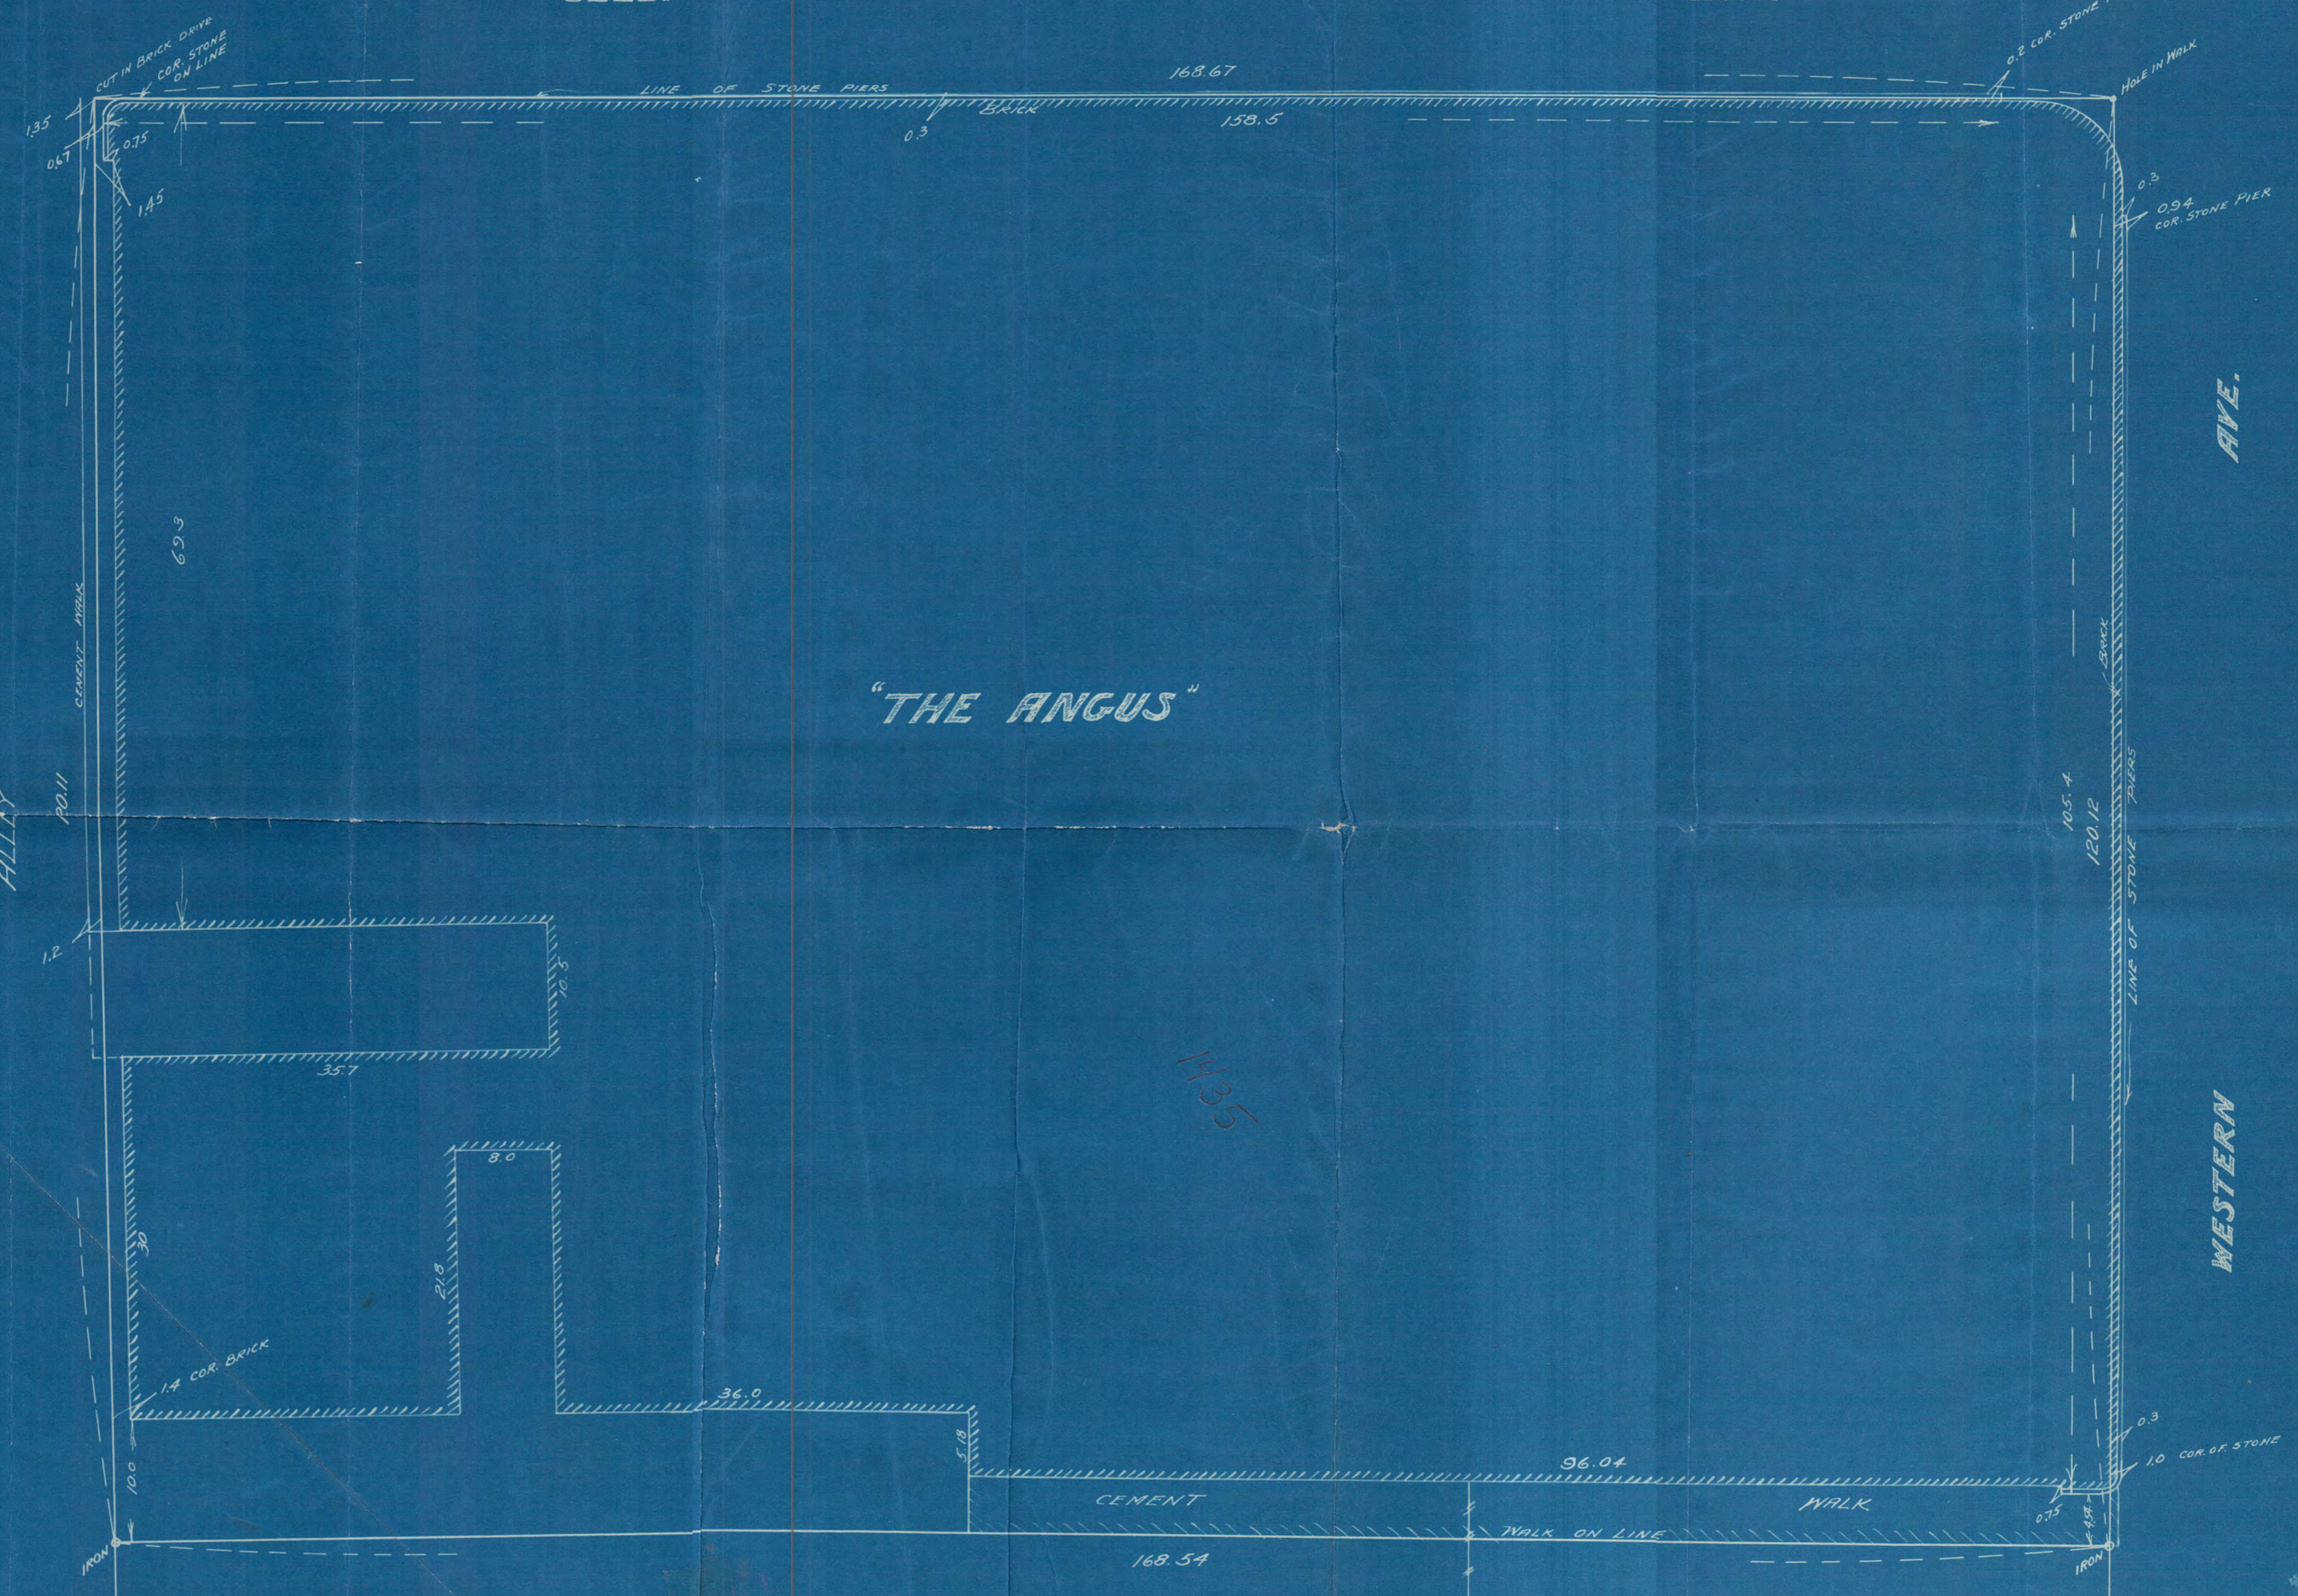

SURVEY OF LOT 1 COCHRAN'S SUB. OF BLOCK 11 WOODLAND PARK ADD'N.
 Nov. 12

SCALE 10' = 1"

Armstrong SURVEYOR

1435