

COLLEGE PLACE TAILORS DIV.

SURVEY OF

LOT 13

BLK 1

JAN 22-1913


JENS PEDERSEN

SURV

210 GLOBE BLDG

WALKER AVE.
SCALE 20' = 1"

WALKER AVE.

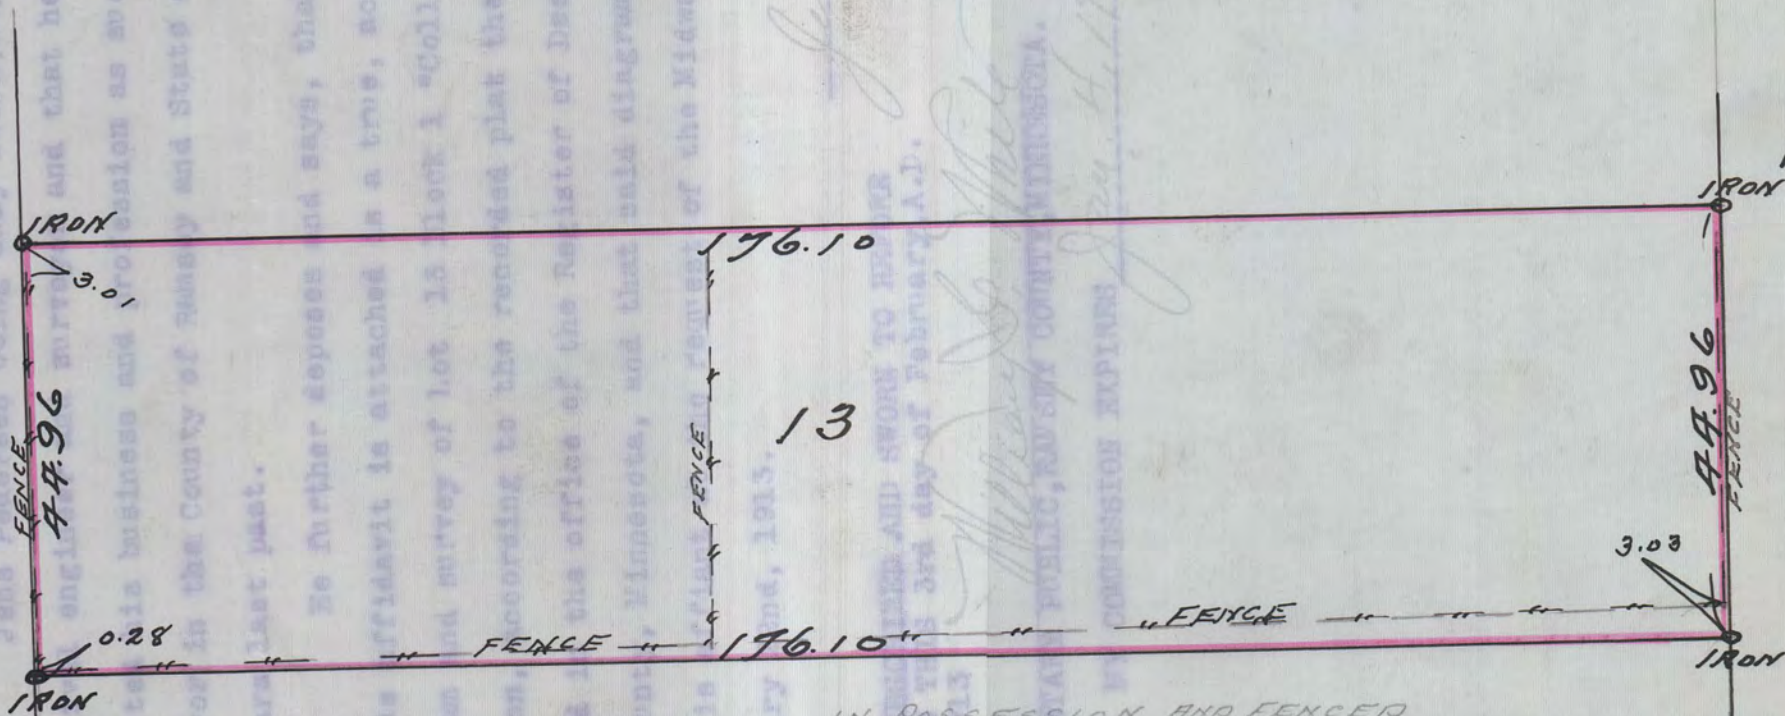

IN POSSESSION AND FENCED
BY CHAS OLSON
912 WALKER AVE

#1449