


MISSISSIPPI RIVER

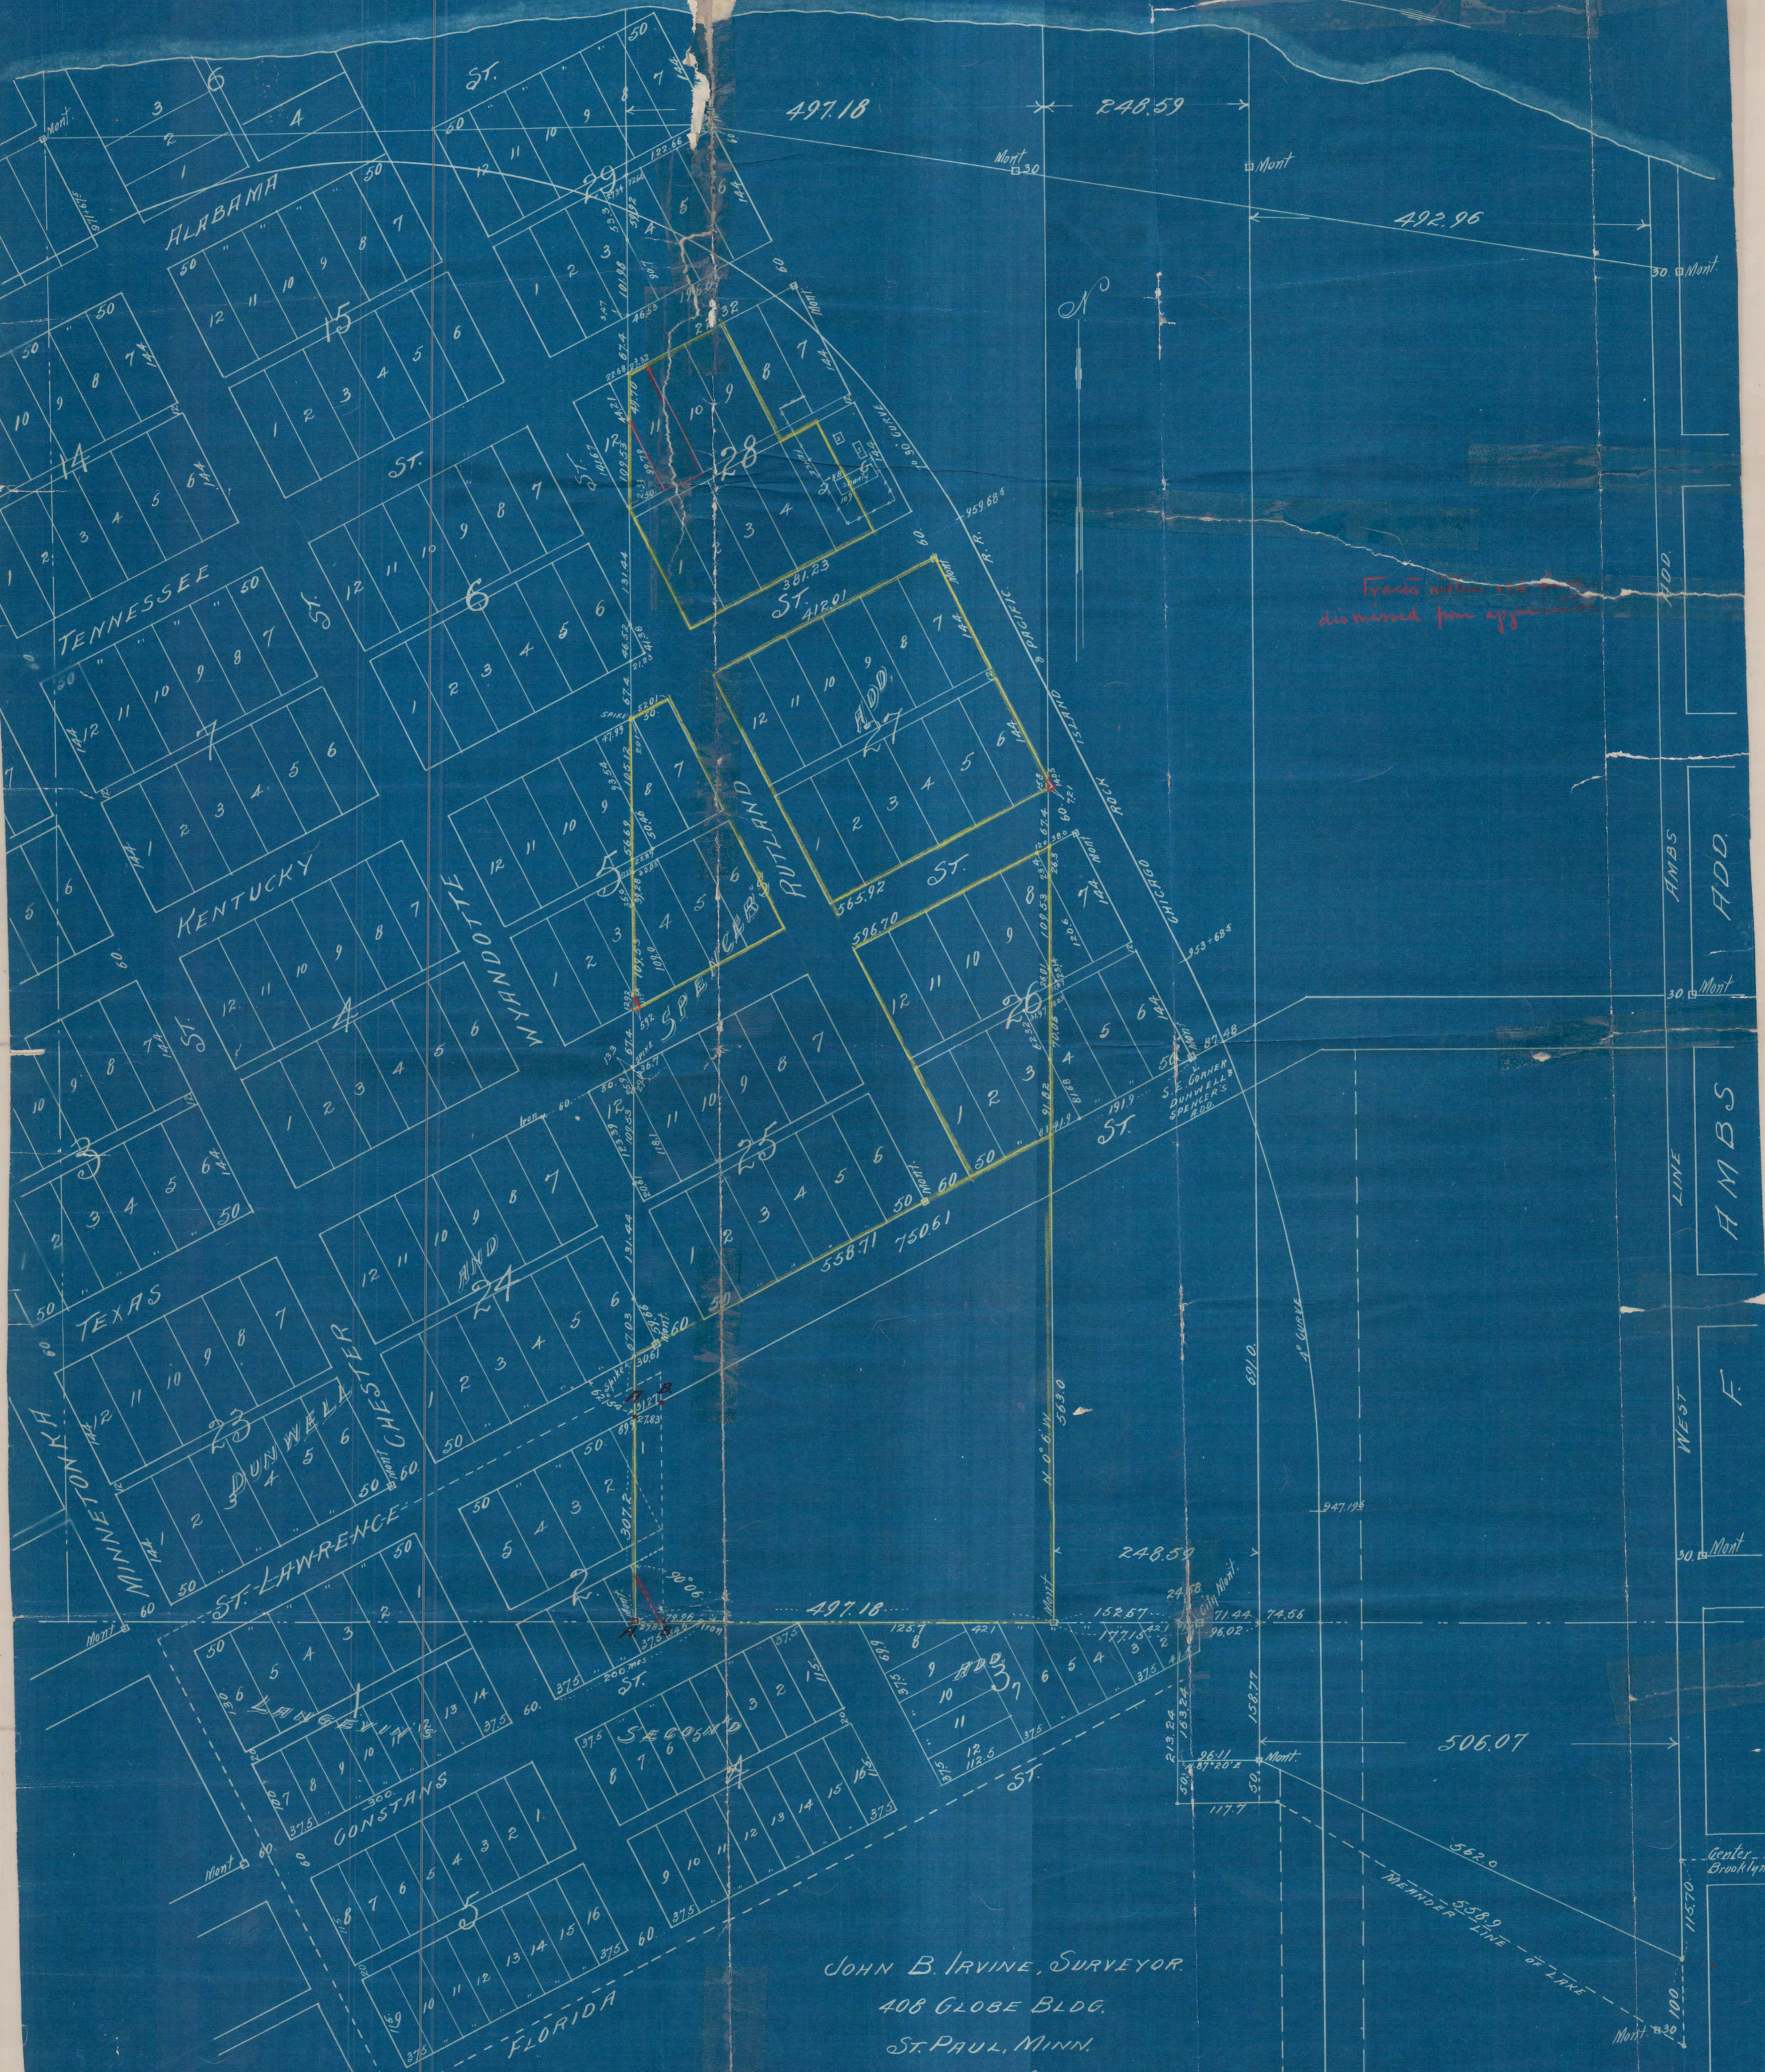

Trails within this block
dismissed from appraisals

JOHN B. IRVINE, SURVEYOR.
408 GLOBE BLDG.
ST. PAUL, MINN.
SCALE 100 ft. per inch.
FEB. 21-1913

1452