

1456

BAZIL AND ROBERTS ADD.

SURVEY OF

LOT 1A.

BL 1

SCALE 20' = 1"

JENS PEDERSEN SURV.


210 GLOBE BLDG N

ST. PAUL, MARCH 1913

I HEREBY CERTIFY TO HAVING SURVEYED LOT 1A BL 1 BAZIL AND ROBERTS ADD AND HAVE PLACED IRON MONUMENTS AT THE CORNERS AND ALL DISTANCES AS HEREON SHOWN ARE CORRECT

Jens Pedersen SURV.

SCALE 20' = 1"

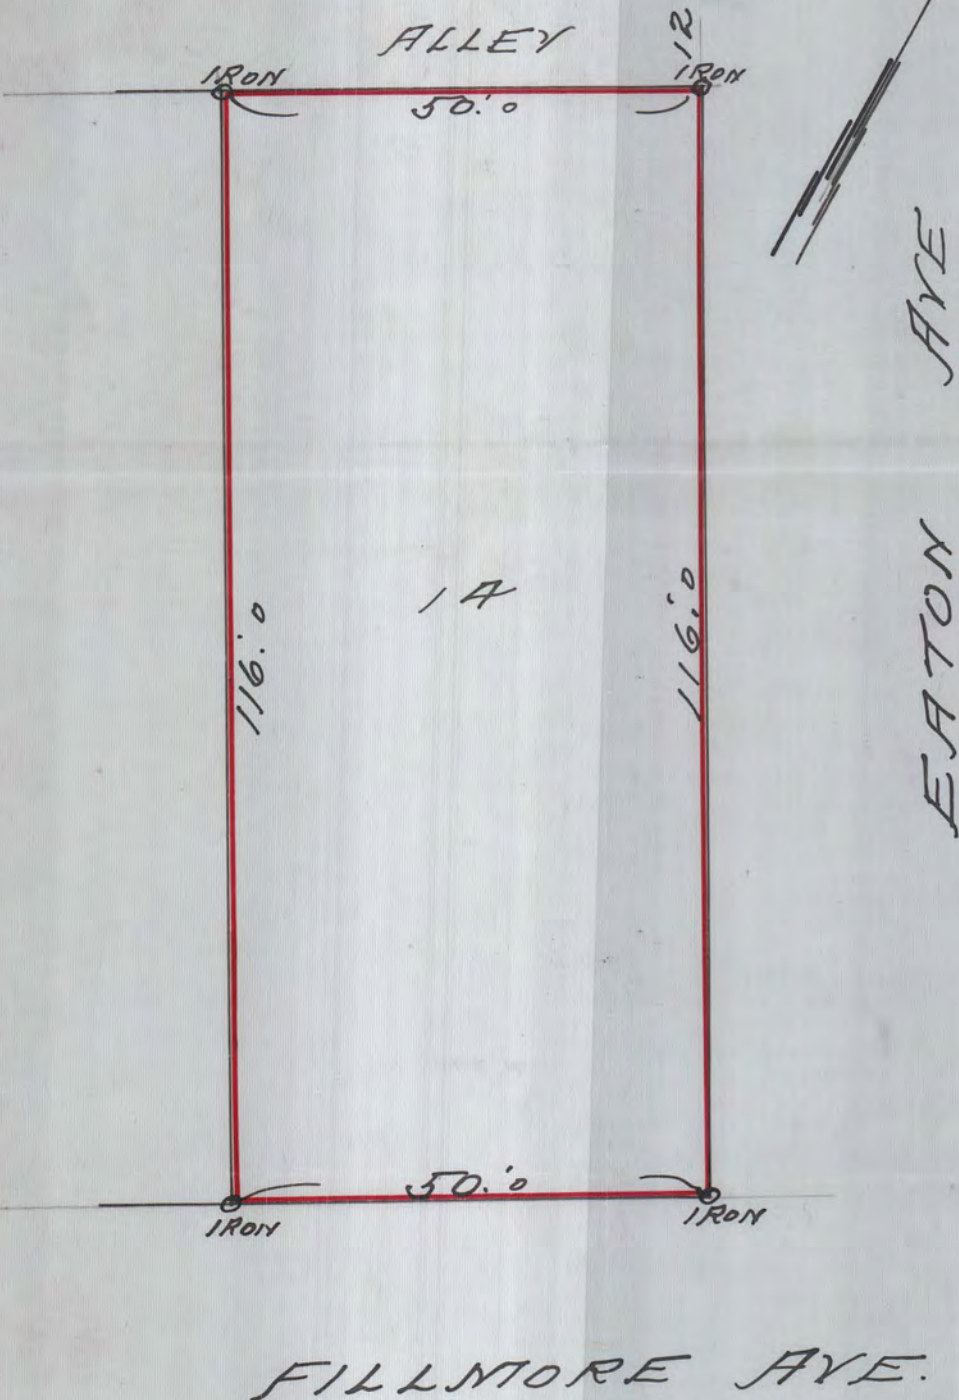

1456