

# BORUP ADD

SURVEY OF  
LOT 7

EXCEPT SLY 18'10"

JAN 24-1913


JENS PEDERSEN  
SURV.

SCALE 10' = 1"

SPRUCE ST.

SIDEWALK.

SIBLEY ST.

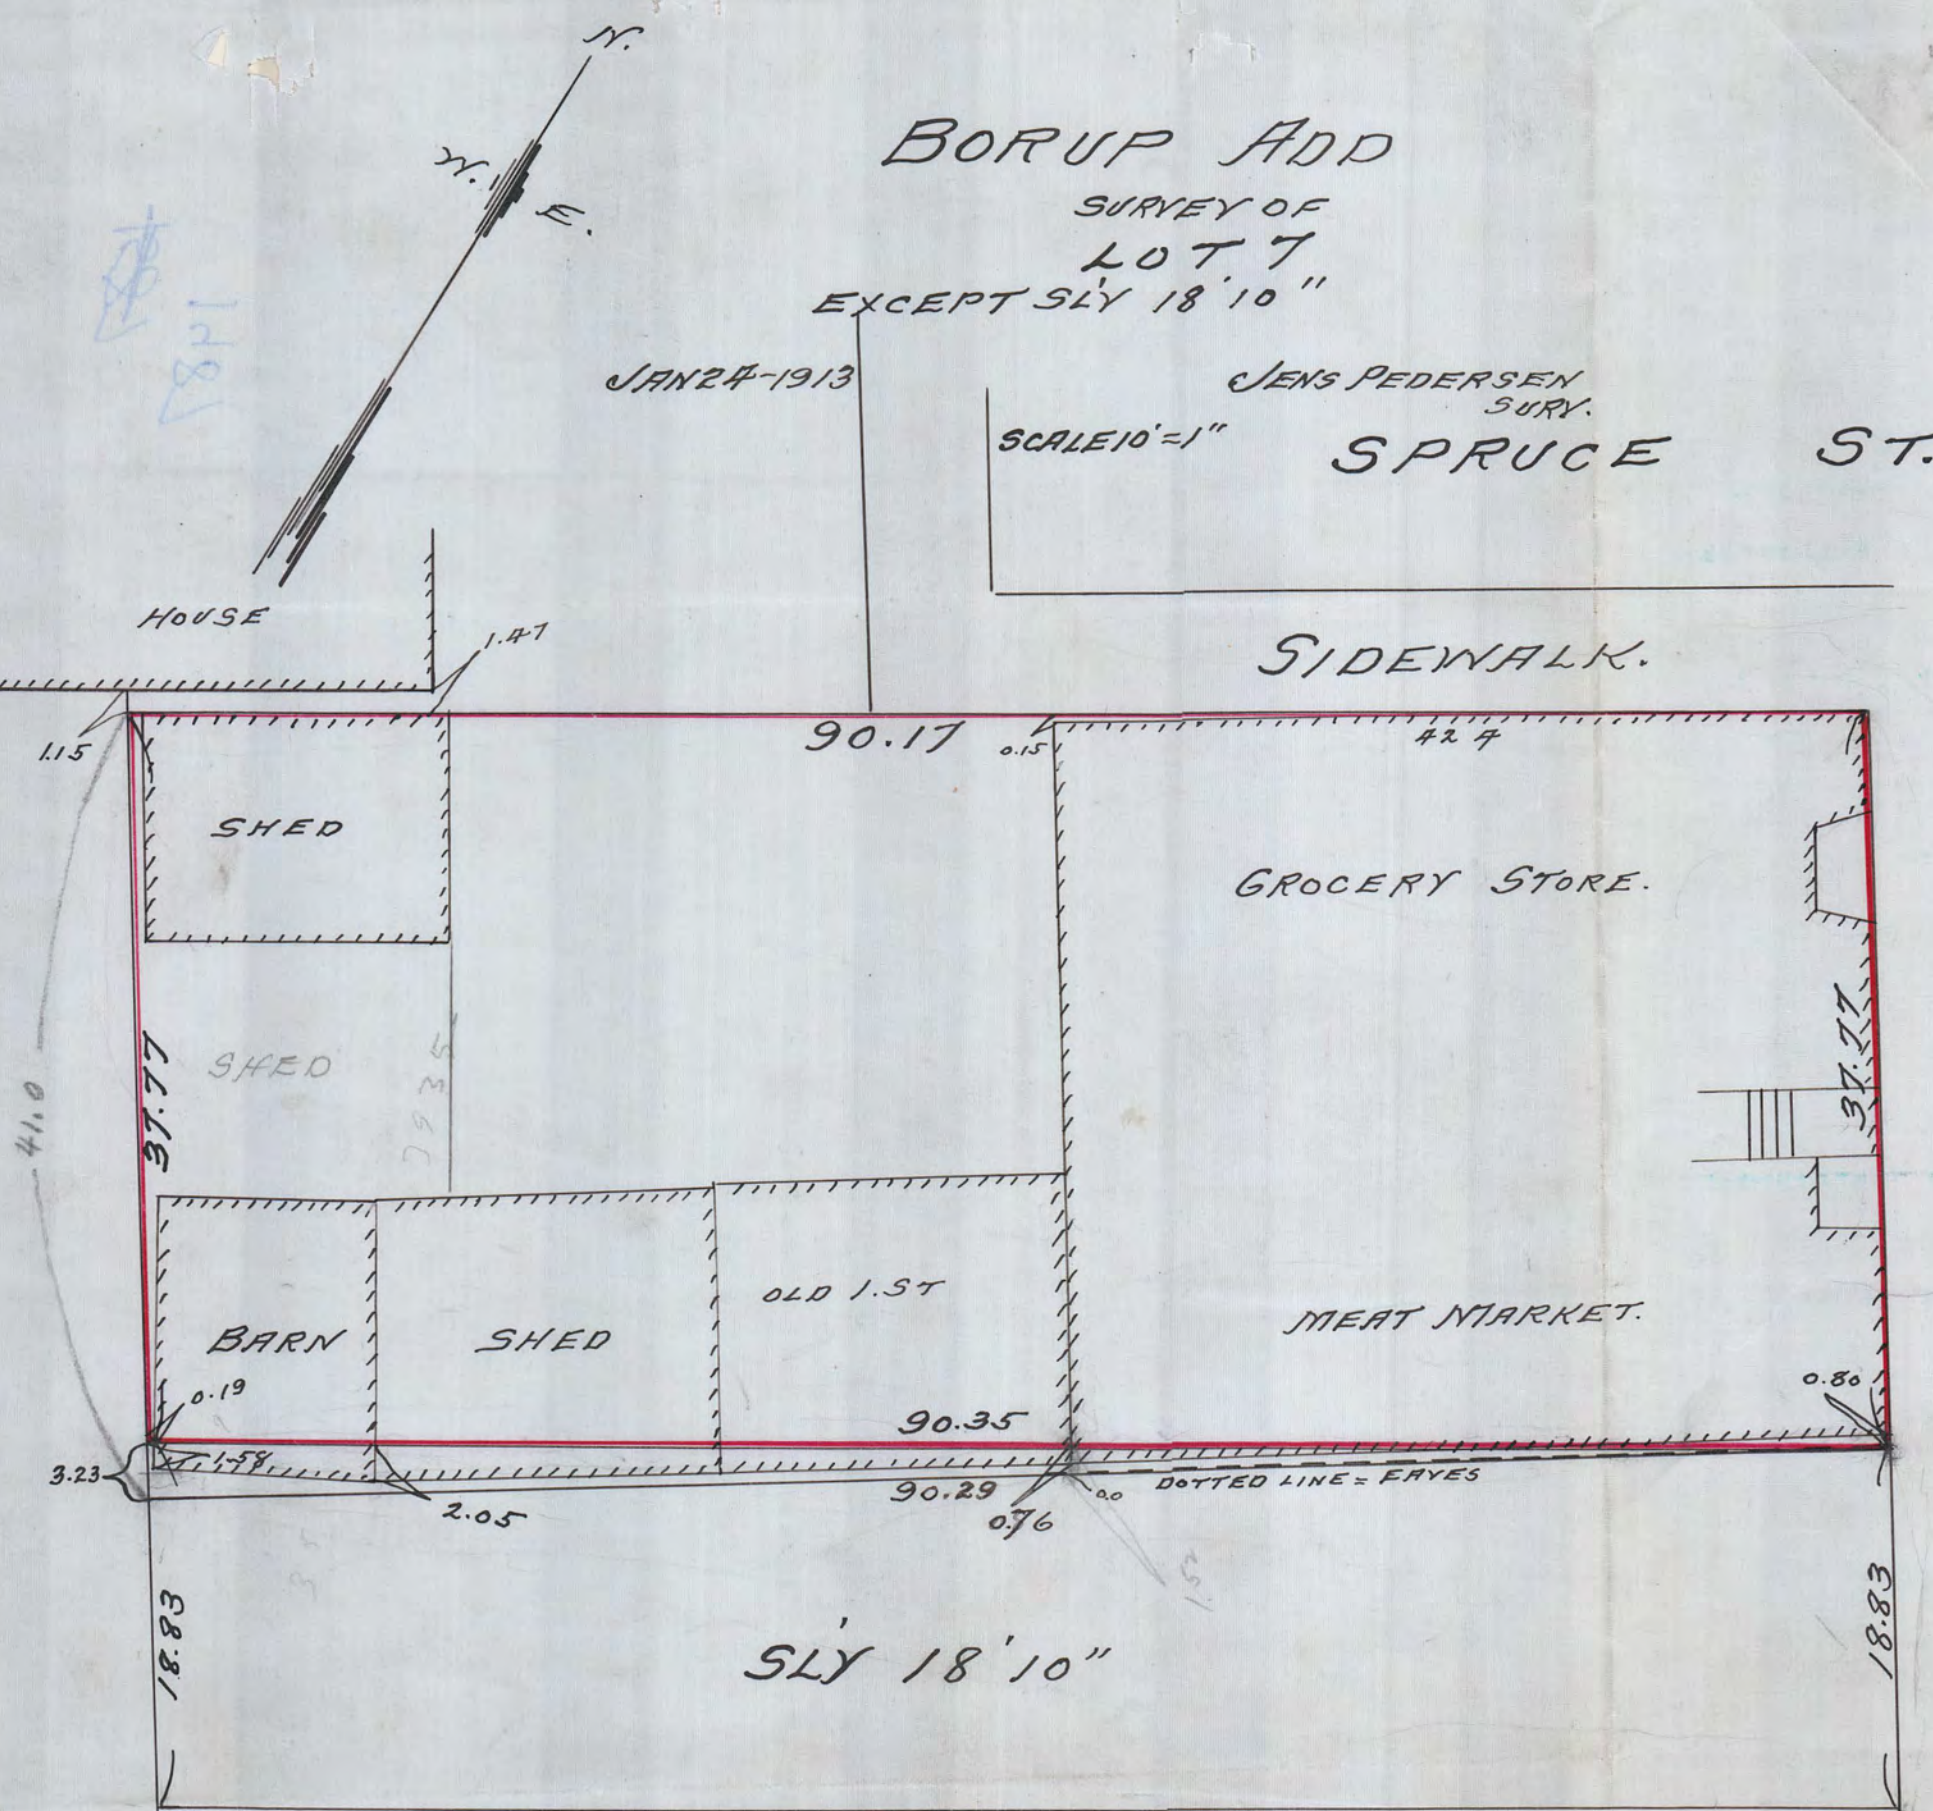

SLY 18'10"

49.50

# 1487