

BREWSTER'S ADD.

SURVEY OF

WLY 2/3 LOT 6 BL 13
SEPT 3-1913 JENS PEDERSEN



SURV
SCALE 1" = 210 GLOBE BLDG.

1534

WINTER ST.

WLY 2/3 LOT 6

HOUSE.

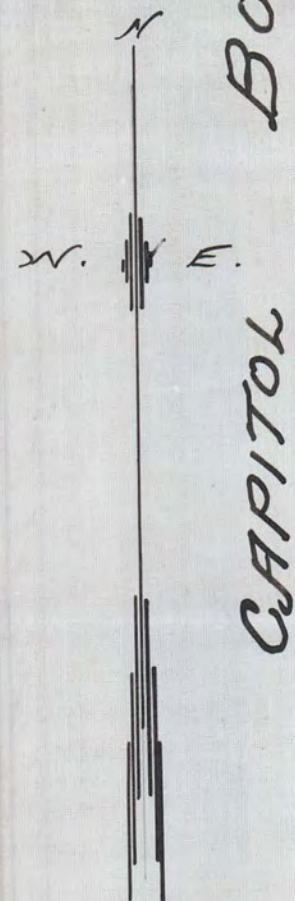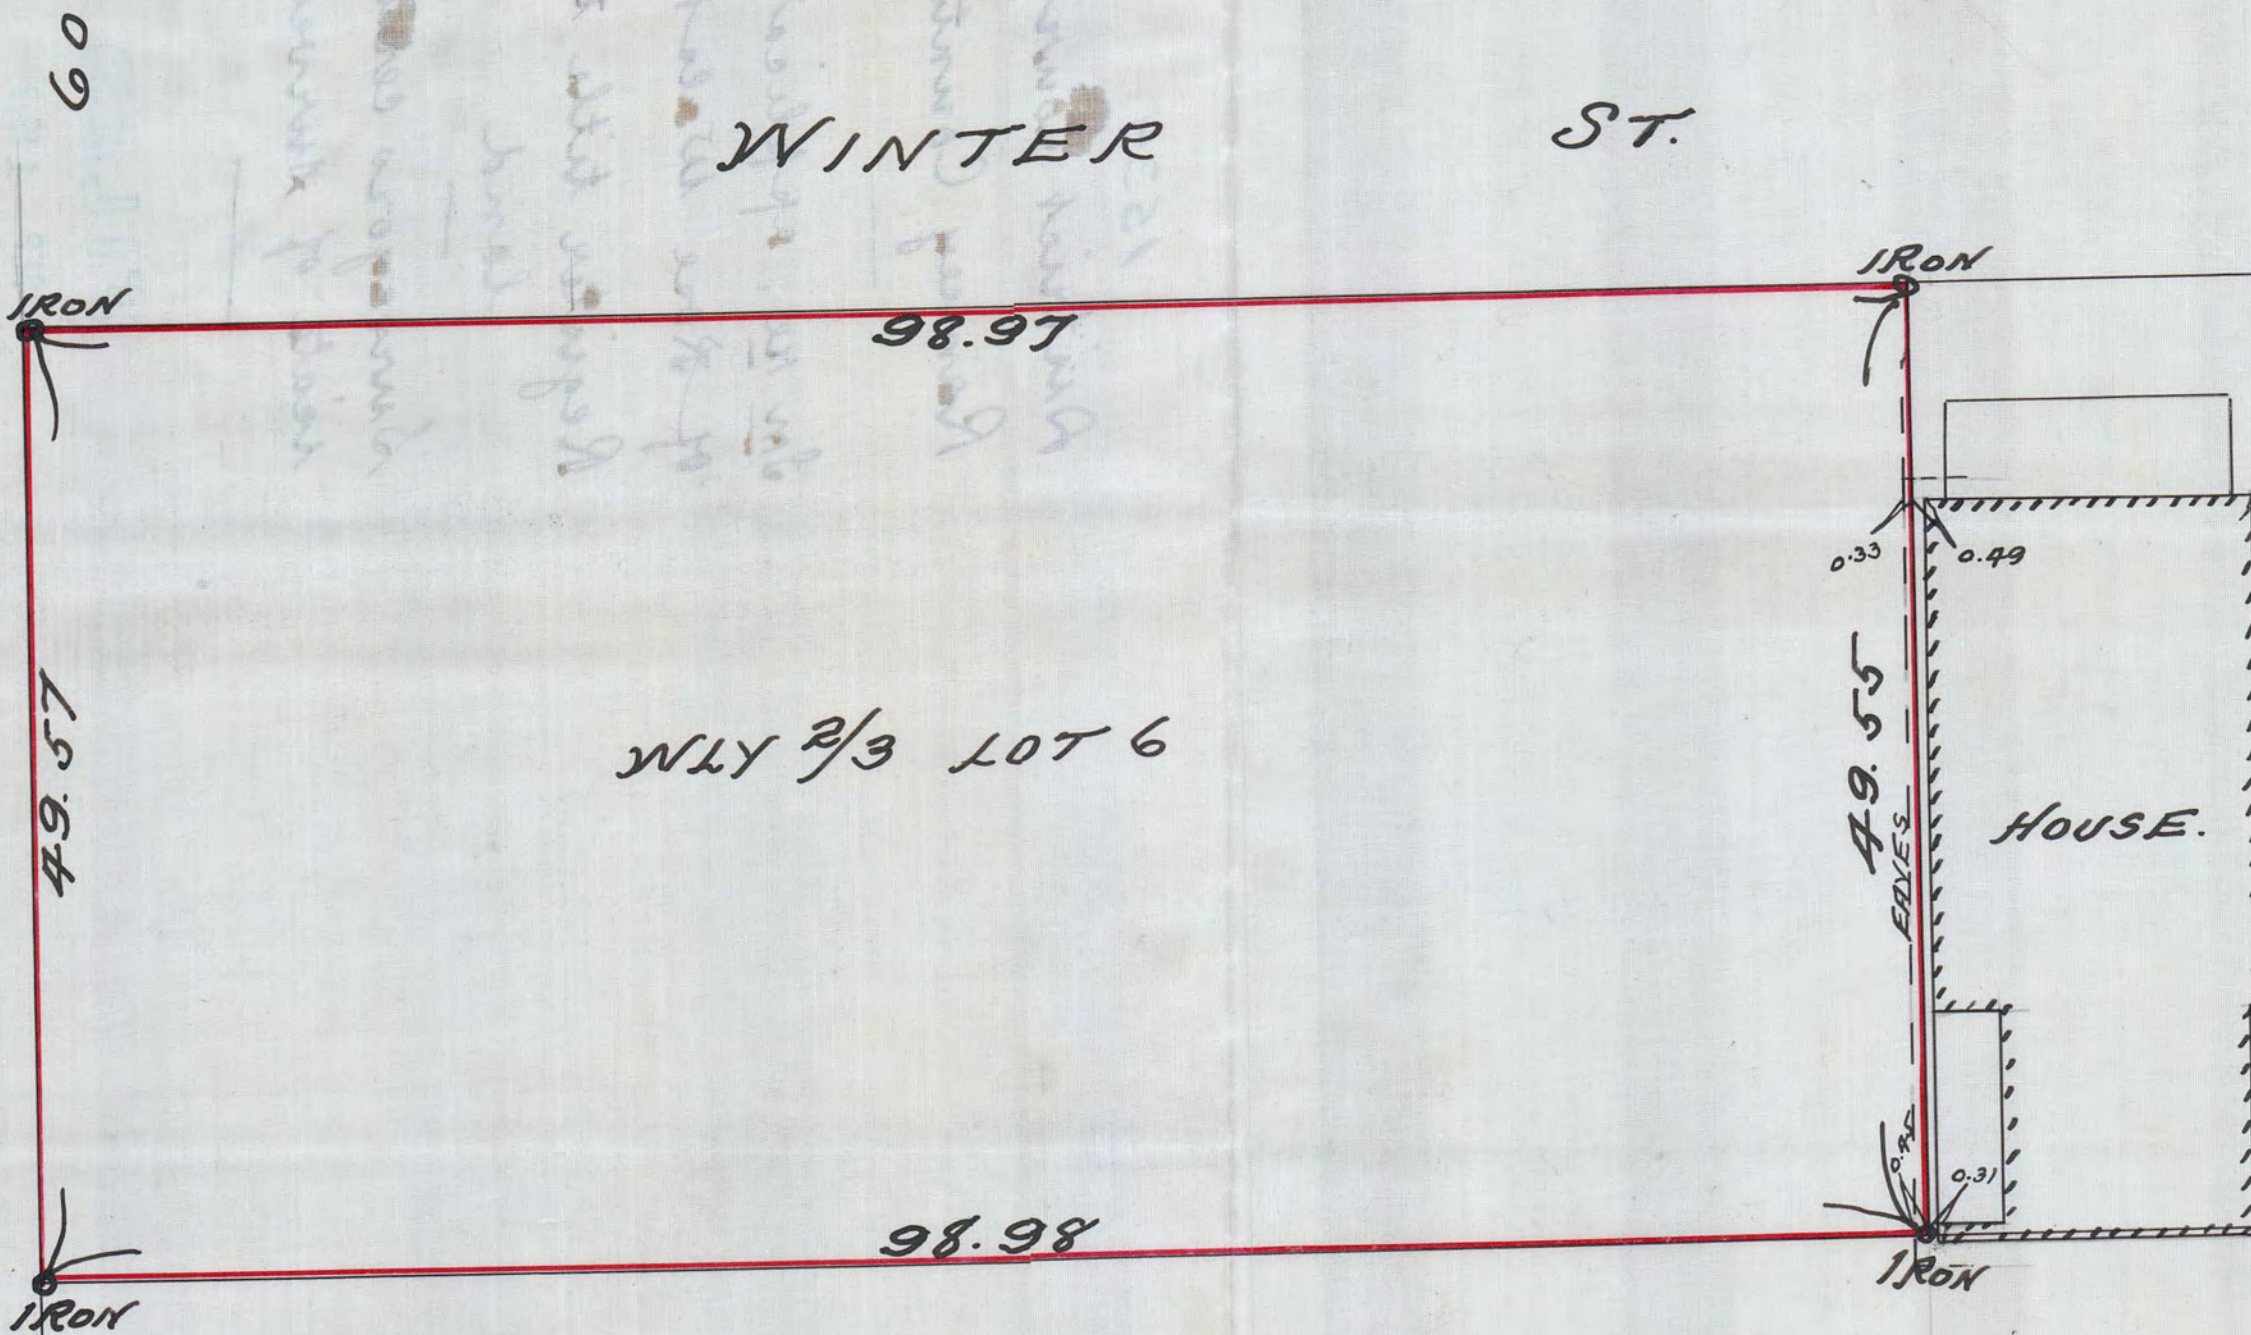

#1534