


WEIDES REAR
OF
LOTS 76 TO 80 WILKIN AND HEYWARDS

OUT LOTS
SURVEY OF
LOTS 8.9.10.11.12 AND 13 BLOCK 2
AUG 9-1913 JENS PEDERSEN
SURVY 210 GLOBE BLDG.

HATCH ST.

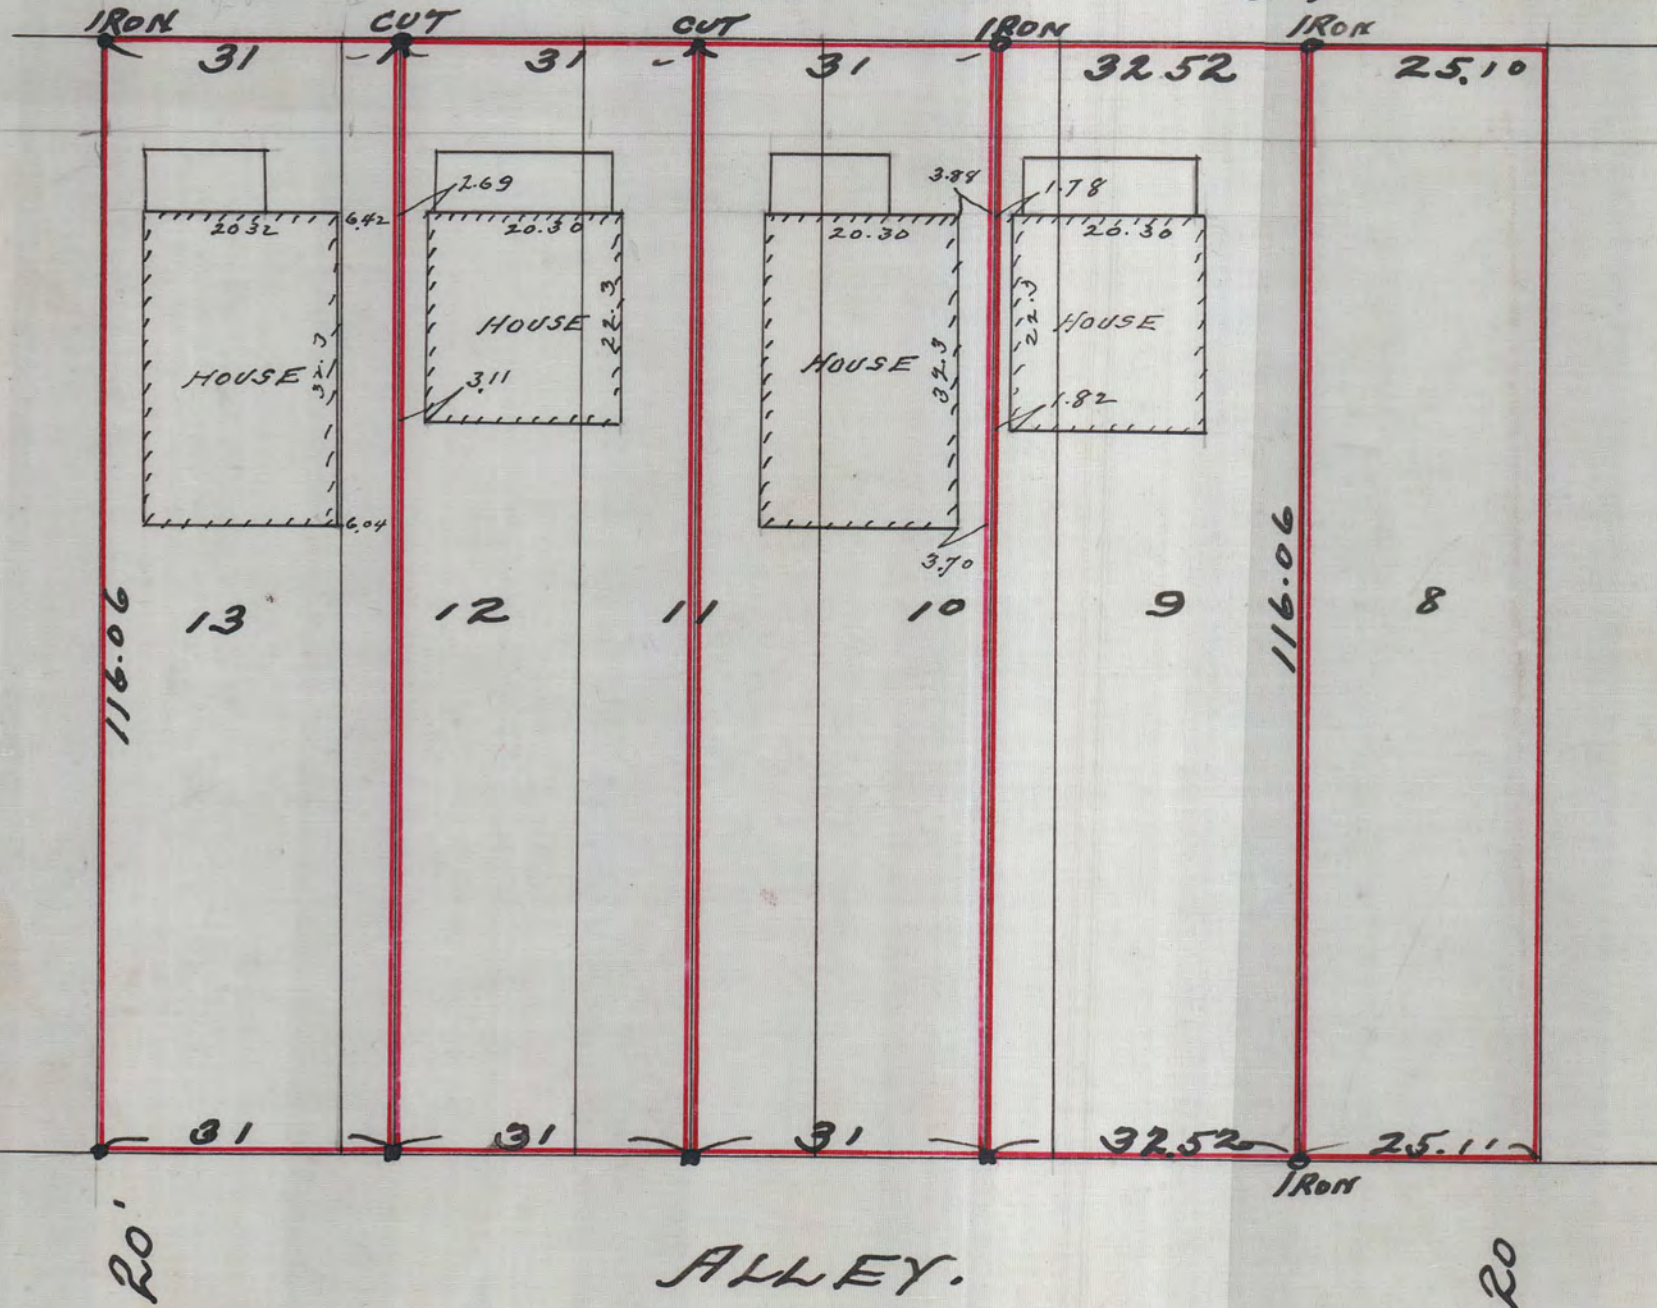

1551

#1550