

LOTS 4 TO 27 INCLUSIVE BLOCK 15
 FIFTH ADD. TO NORTH ST. PAUL.

JOHN B. IRVINE, SURVEYOR.

DEC. 23-1913.

scale 40 ft. per inch.


60. KIMBALL ST.

ST.

60.

* Original Iron.

33.

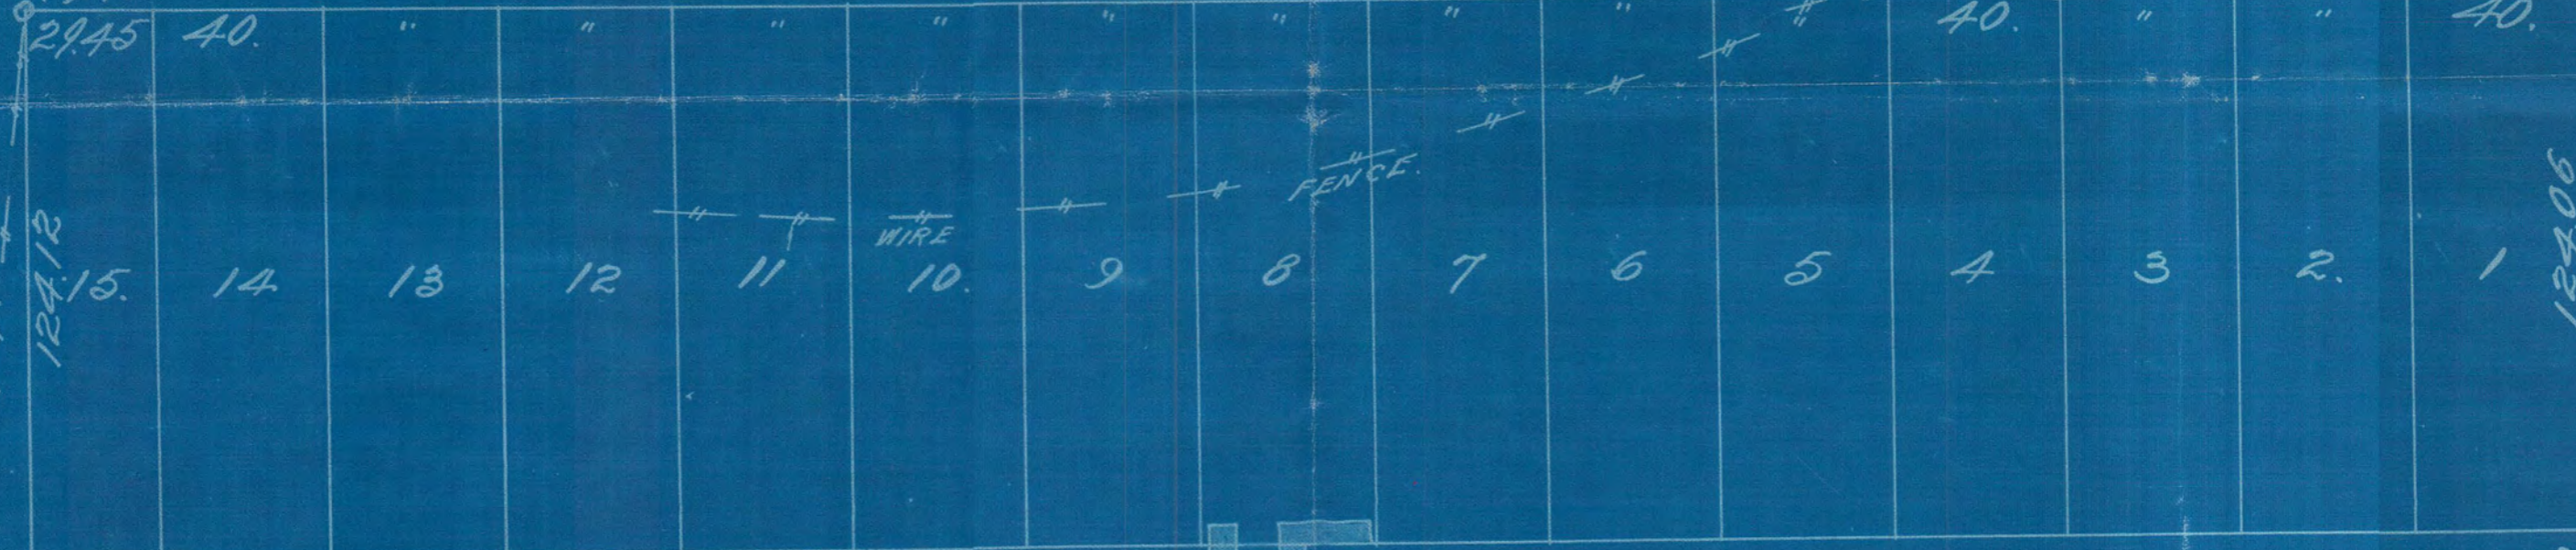


60
 AVE



15

20.

20

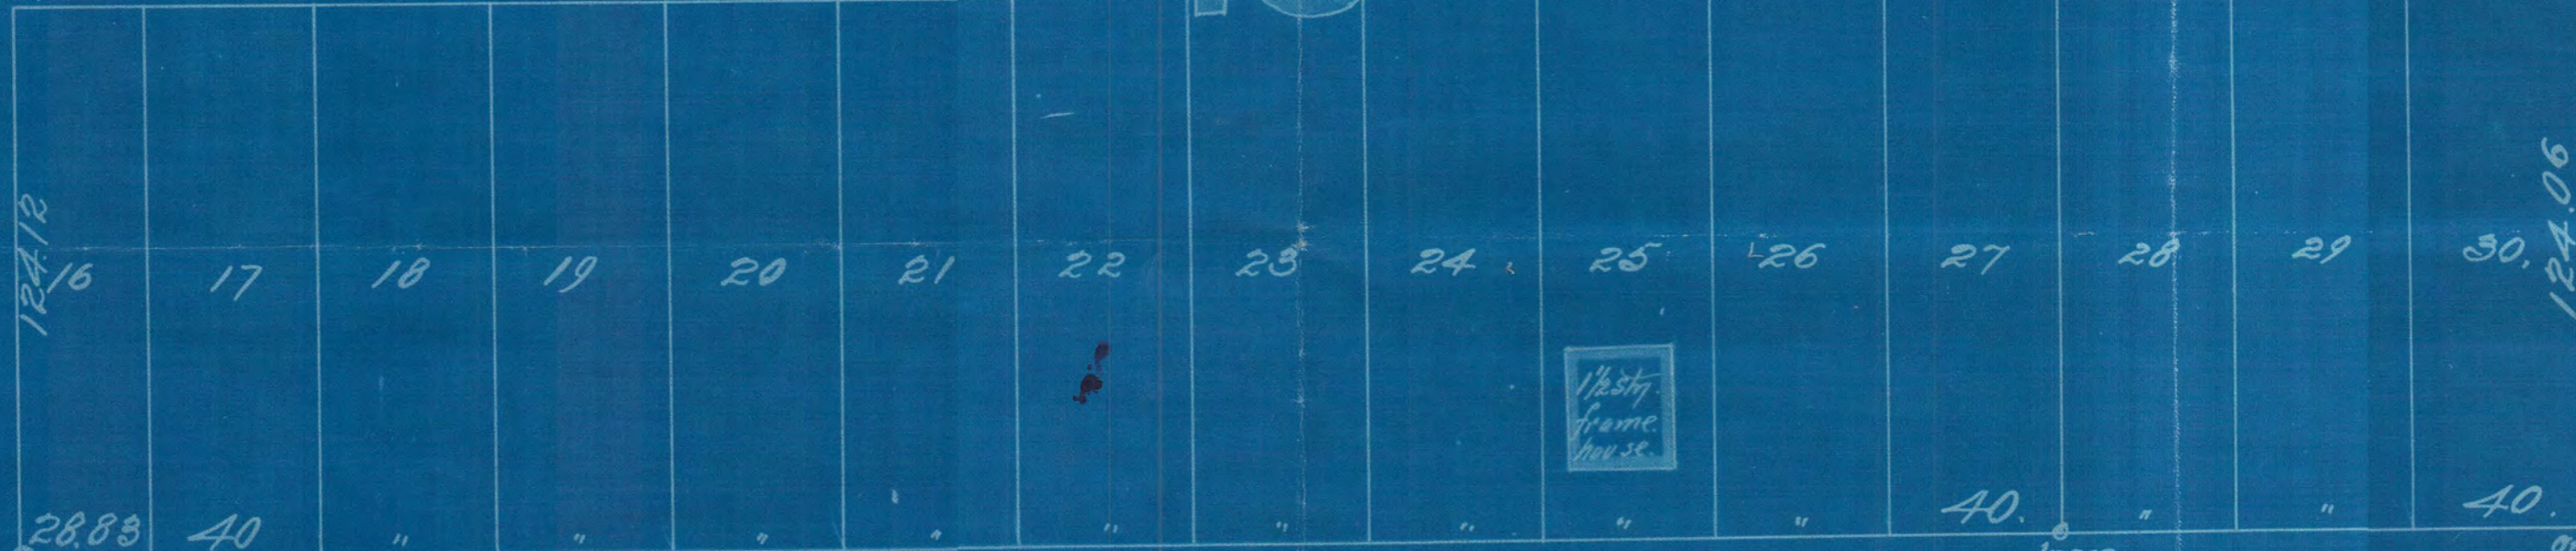

MORRIS AVE

60.

Original Iron.

60. ALLEN ST.

ST.

Exhibit A

1586