


MAP SHOWING LOCATION OF TRACK THROUGH LOT'S 12-13 & 14 AUDITOR'S SUB. NO. 39

APRIL 1914


J. H. Morrison L.E. Scale: 1" = 40'

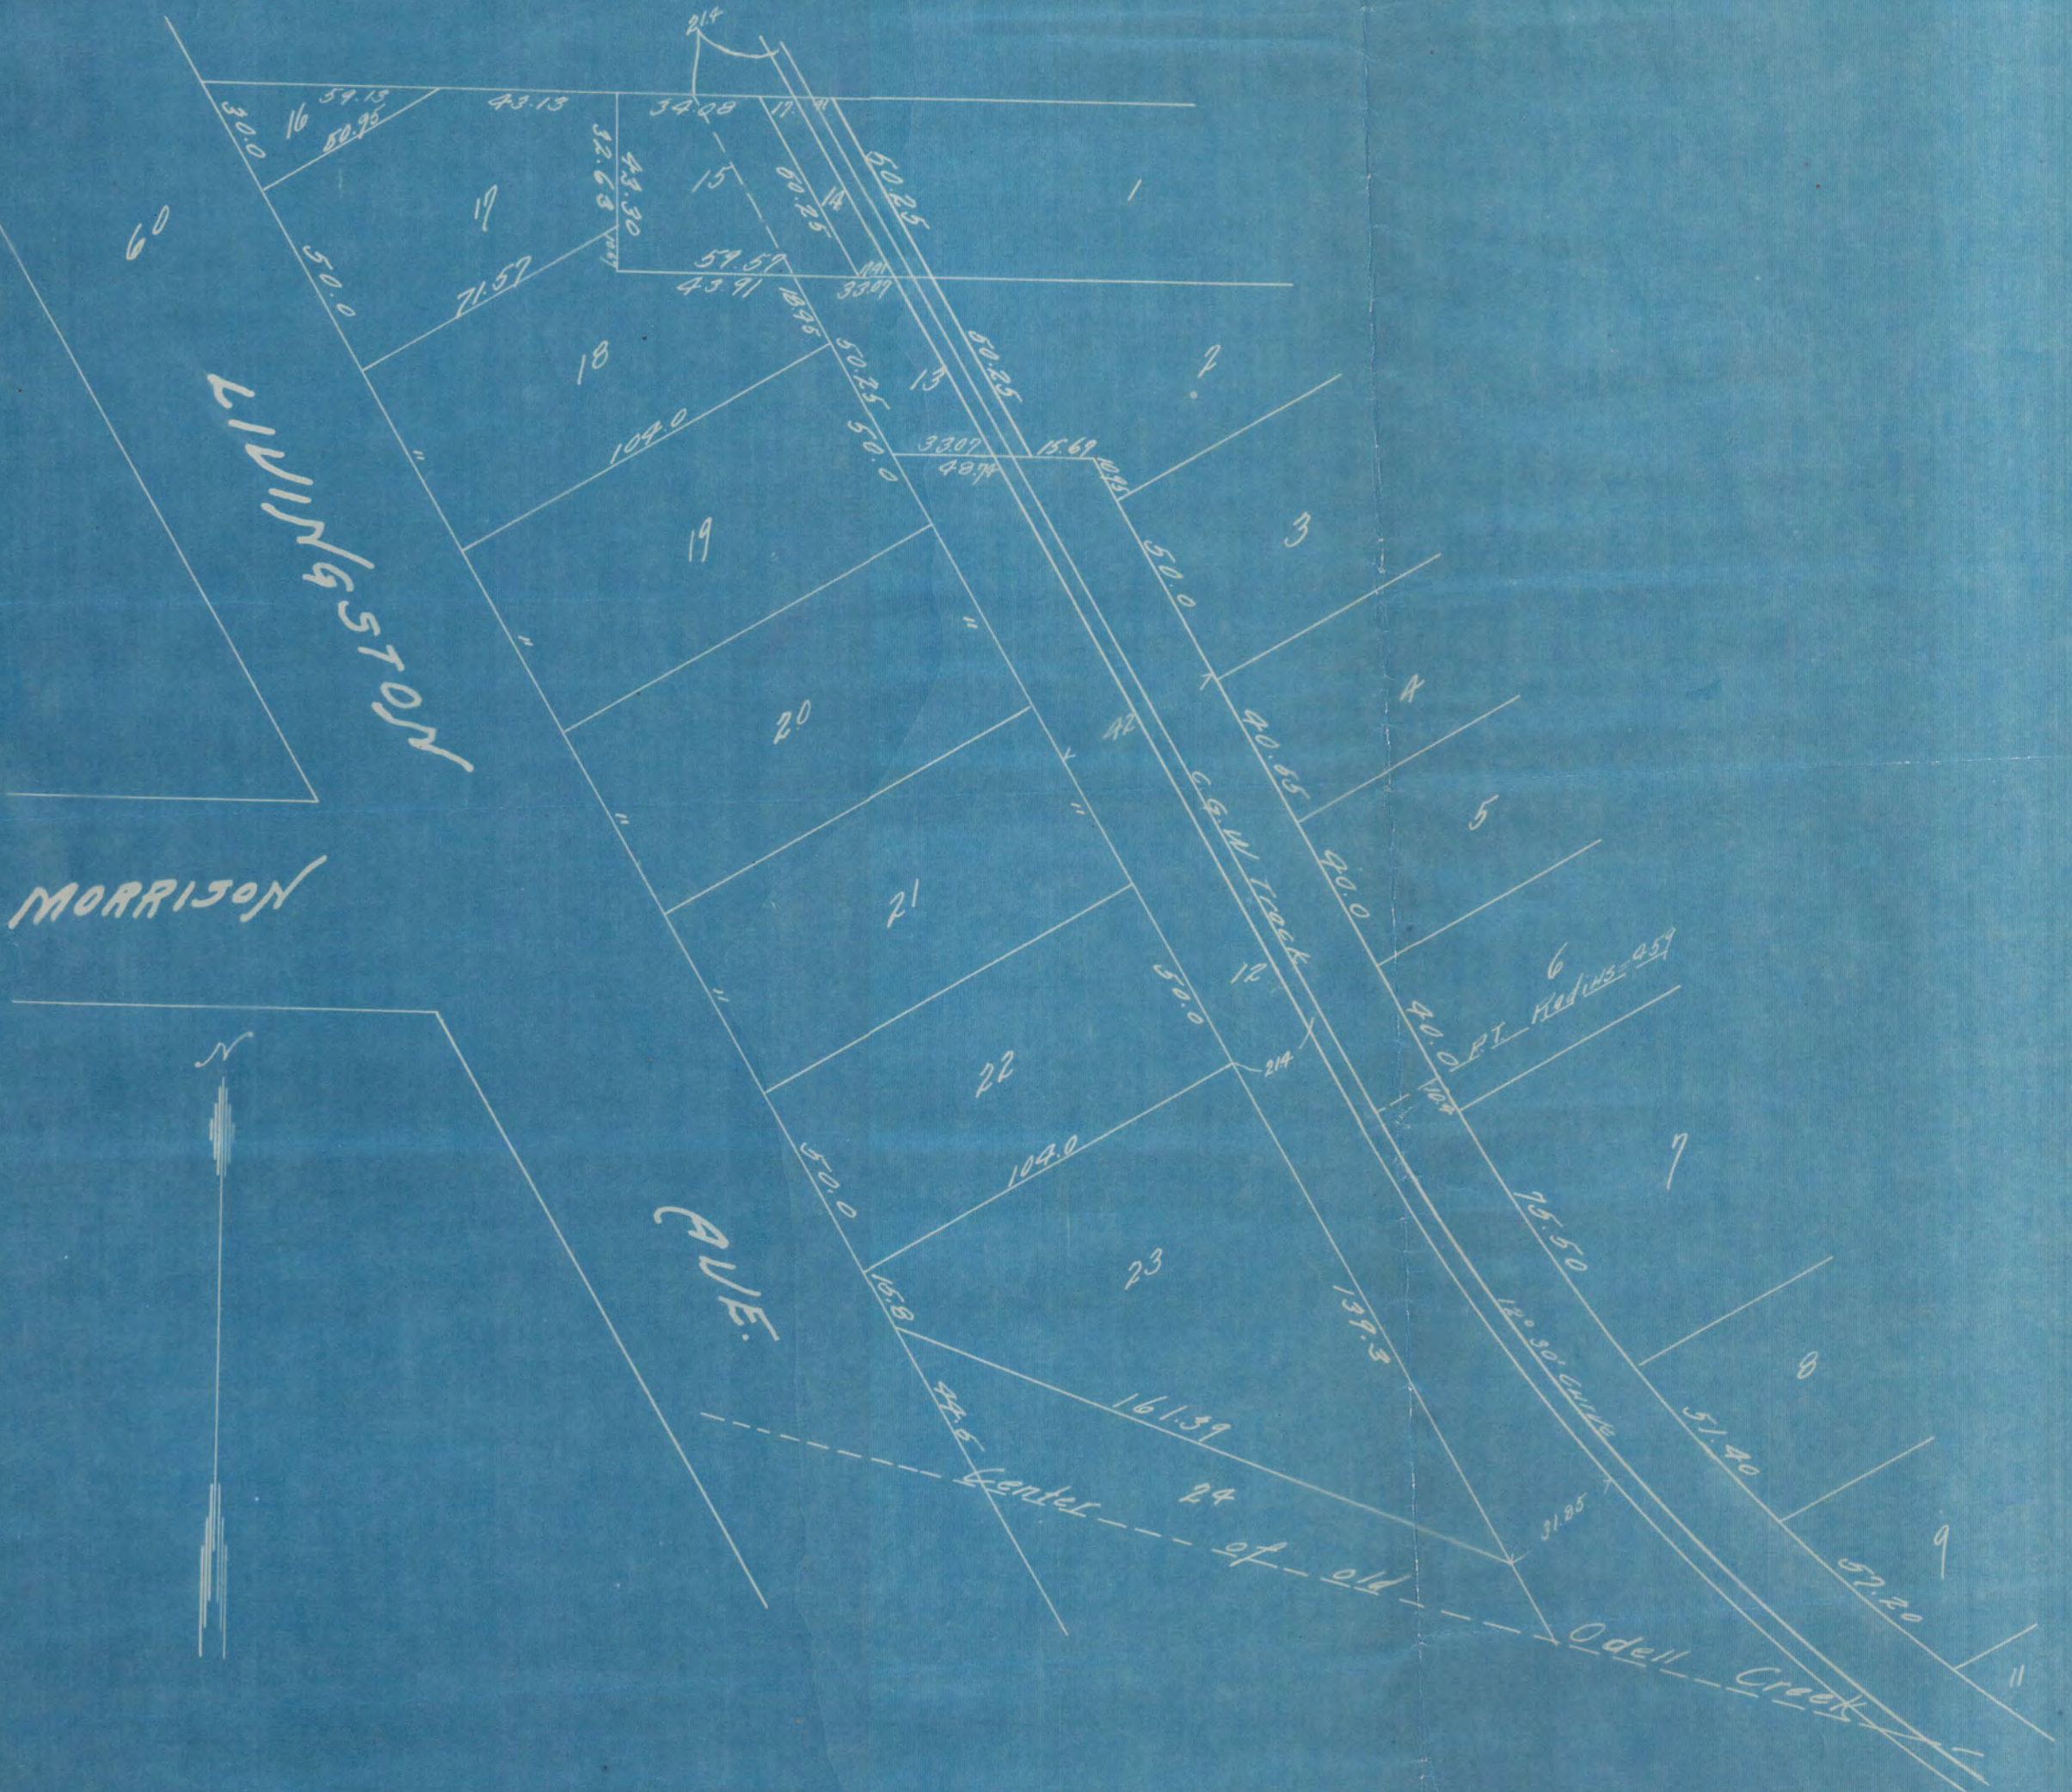

SURVEY OF LOTS 17 TO 23 INCLUSIVE AUDITOR'S SUB. NO. 39

SCALE 40 FT. PER. INCH

J. H. Morrison C.E.

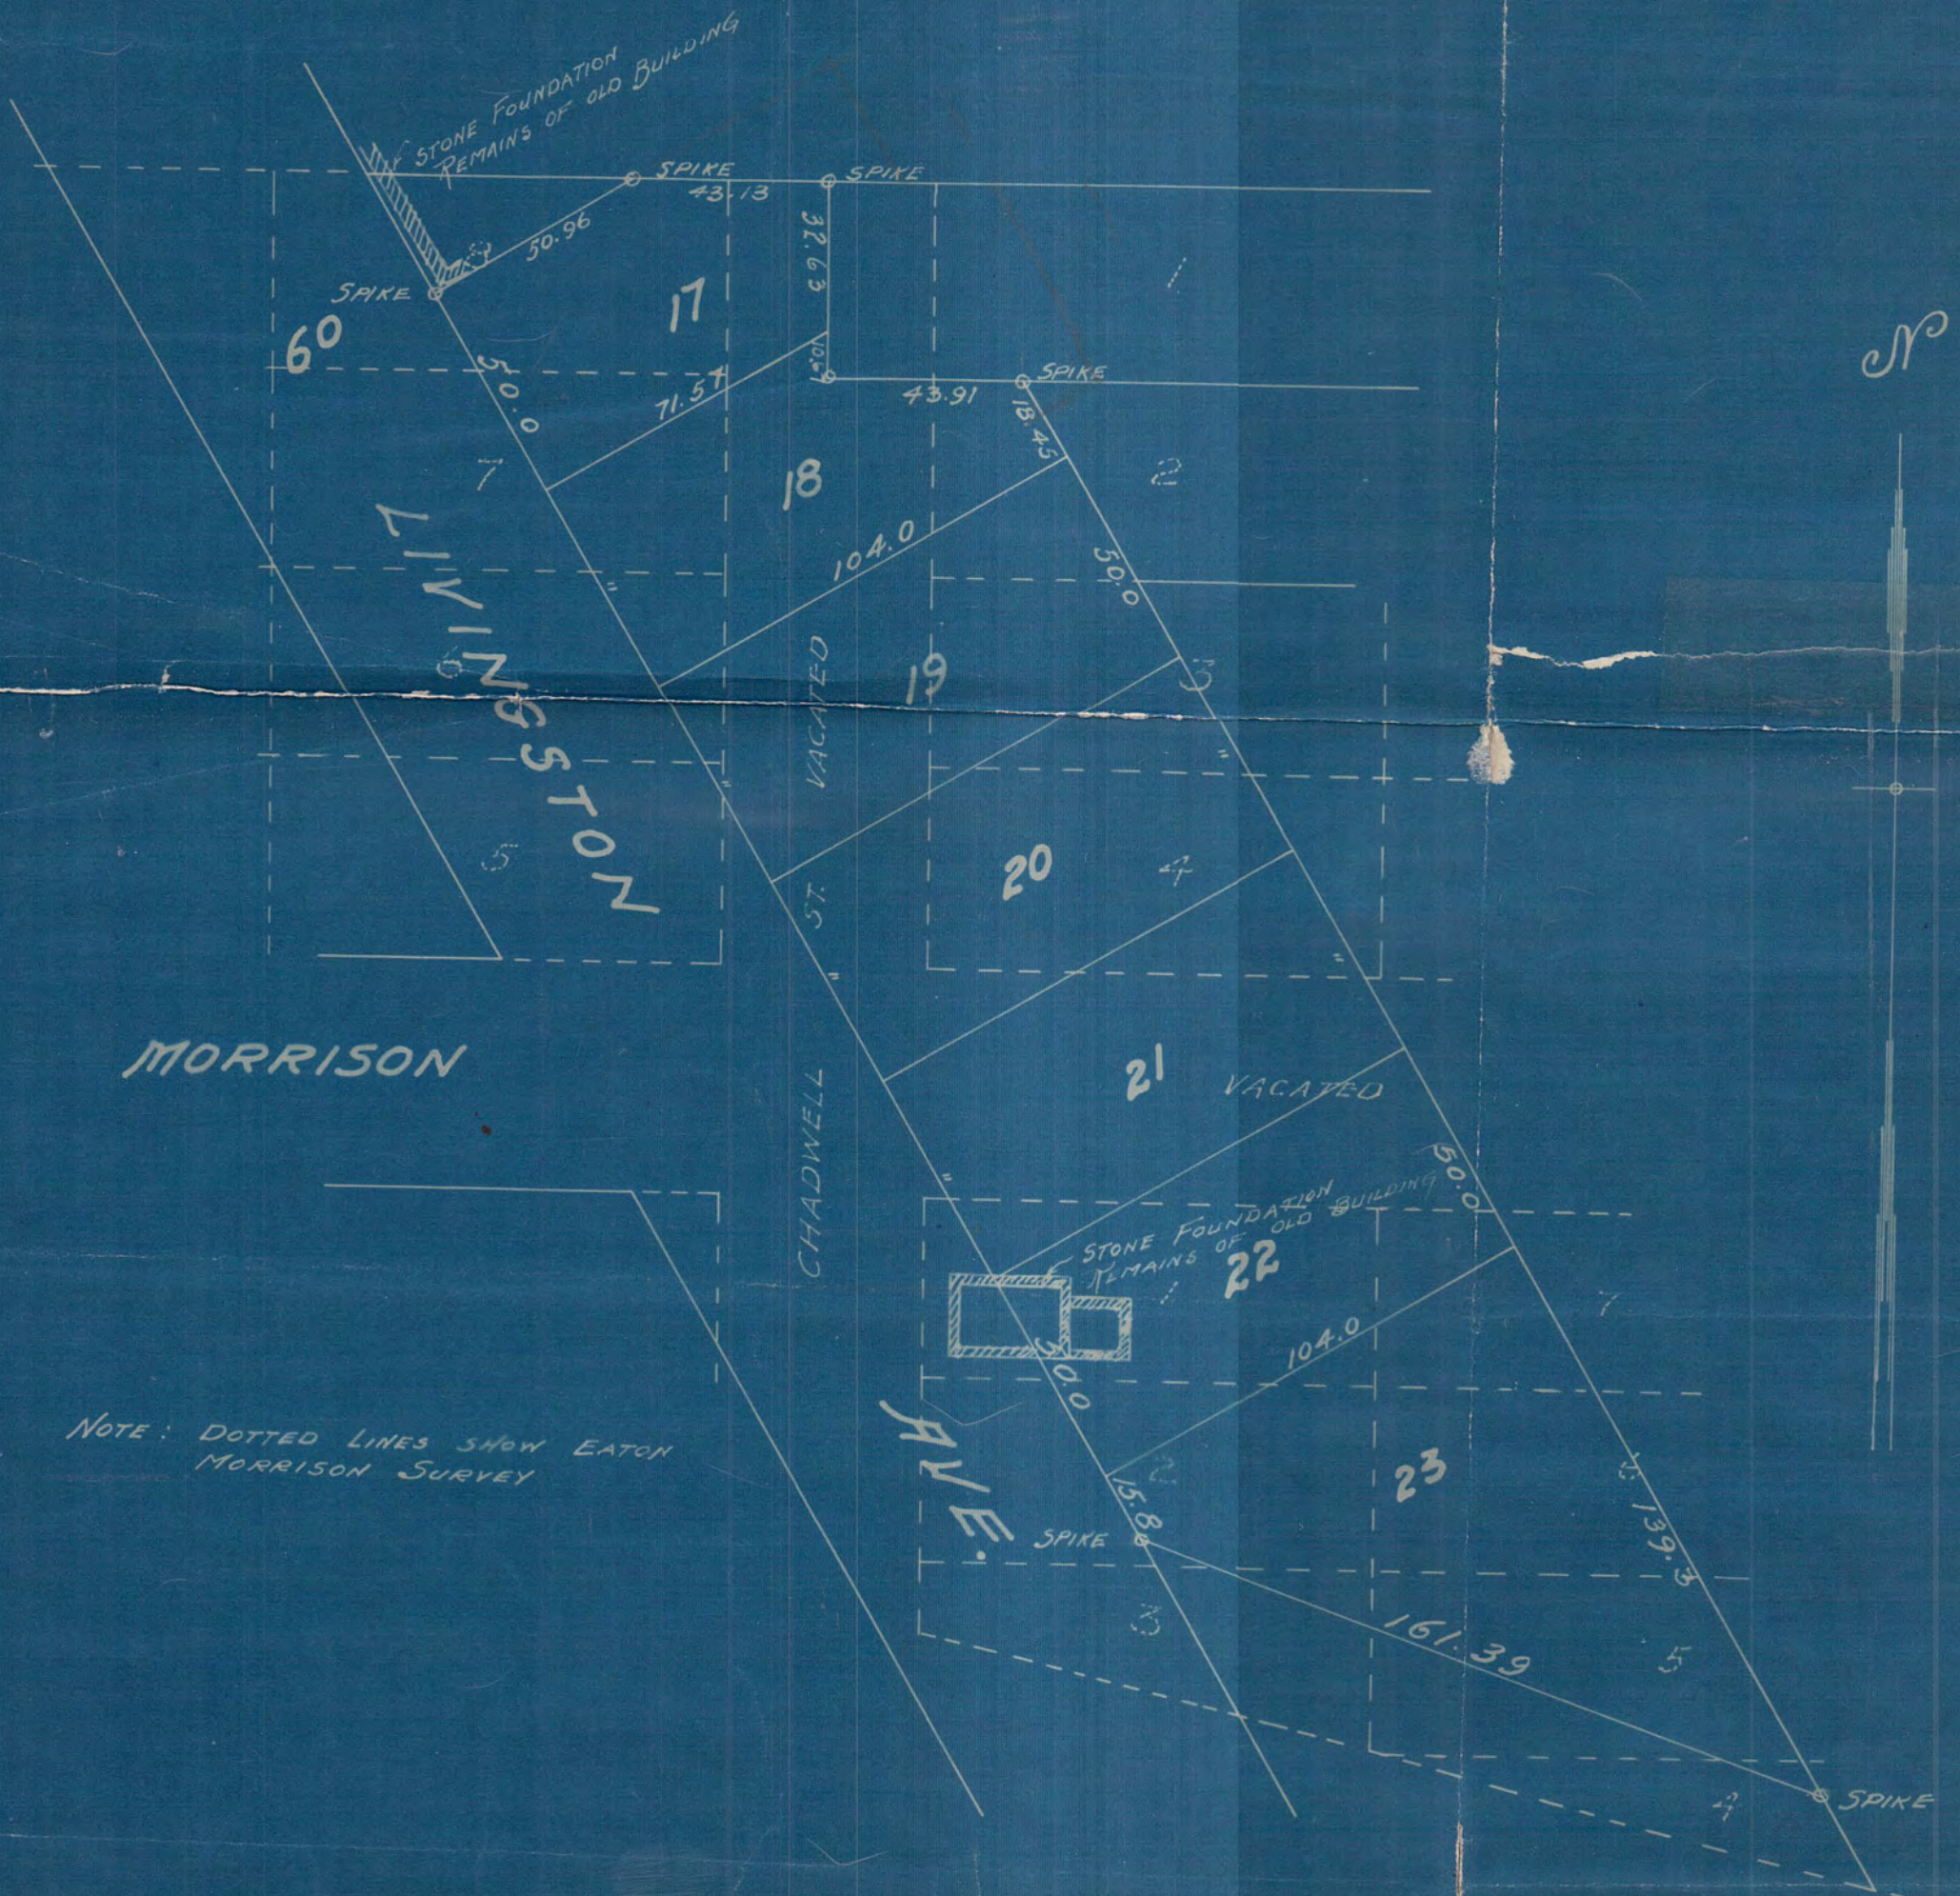

NOTE: DOTTED LINES SHOW EATON MORRISON SURVEY