


SURVEY of the S 1/2 x 22.5' of the N 1/4 1/2 of LOT 15 BLOCK 53

RICE & IRVINE'S ADD.

APRIL 1914

J. H. Armstrong

Scale: 1" = 10'

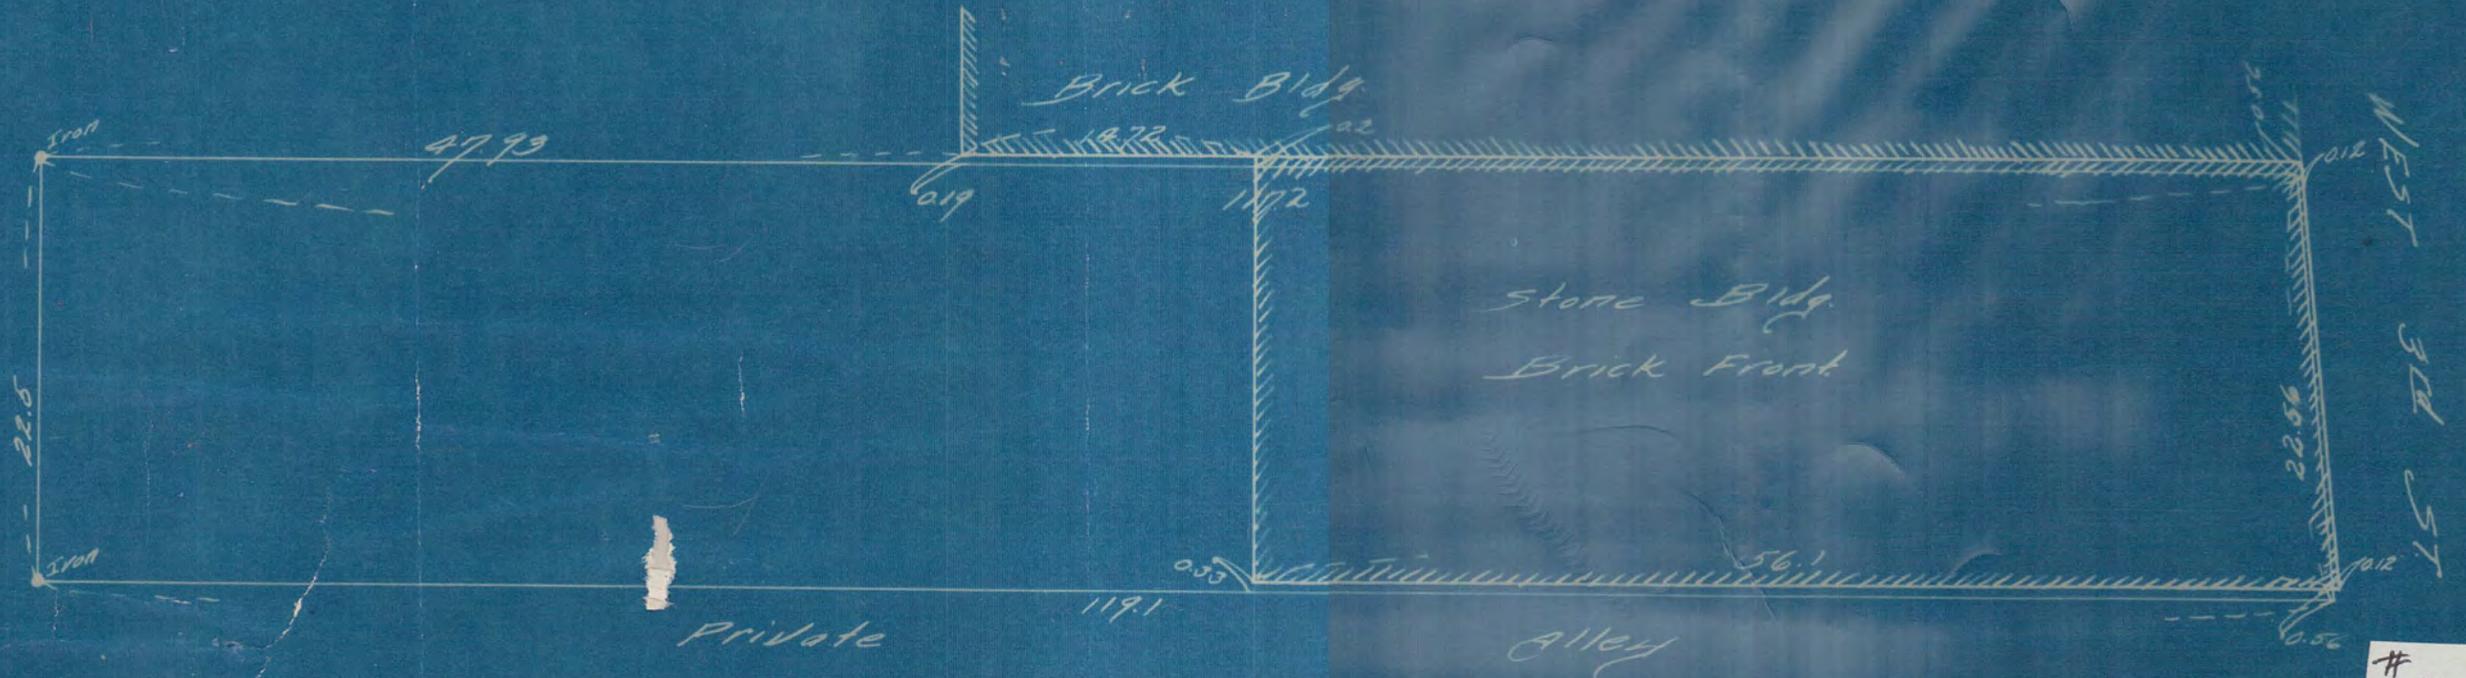

1621

1621

ABSTRACT OF TITLE

MADE BY OFFICIAL OFFICE OF RAMSEY COUNTY


No. 1

TO

The Southerly 22-1/2 feet of the Northerly 1/2 of Lot 15, Block 53,
Rice and Irvine's Addition to St. Paul.

Premises described in caption are located in the SW 1/4 of NW 1/4
of Section Number 6 Township Number 28 North of
Range Number 22 West of the Fourth Principal Meridian.

SECTION

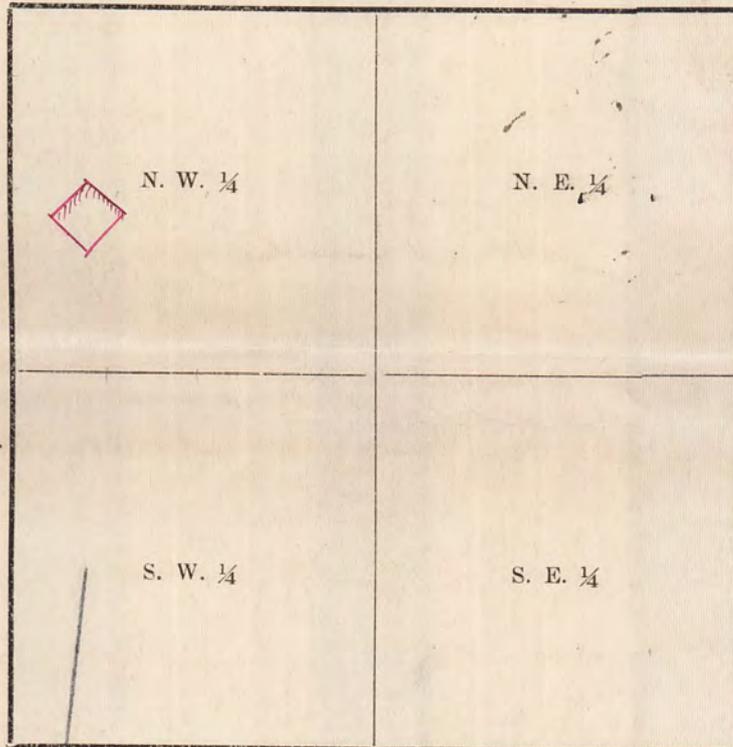


No. 2

Old Time Surveyors Measure

- 7⁸²/₁₀₀ inches make 1 Link.
- 100 Links, or 66 feet, 1 Chain.
- 3 feet, 1 Yard.
- 5½ yds. or 16½ ft., 1 Rod or Pole.
- 4 Rods, 1 Chain.
- 80 Chains (5280 feet) 1 Mile.

No. 3

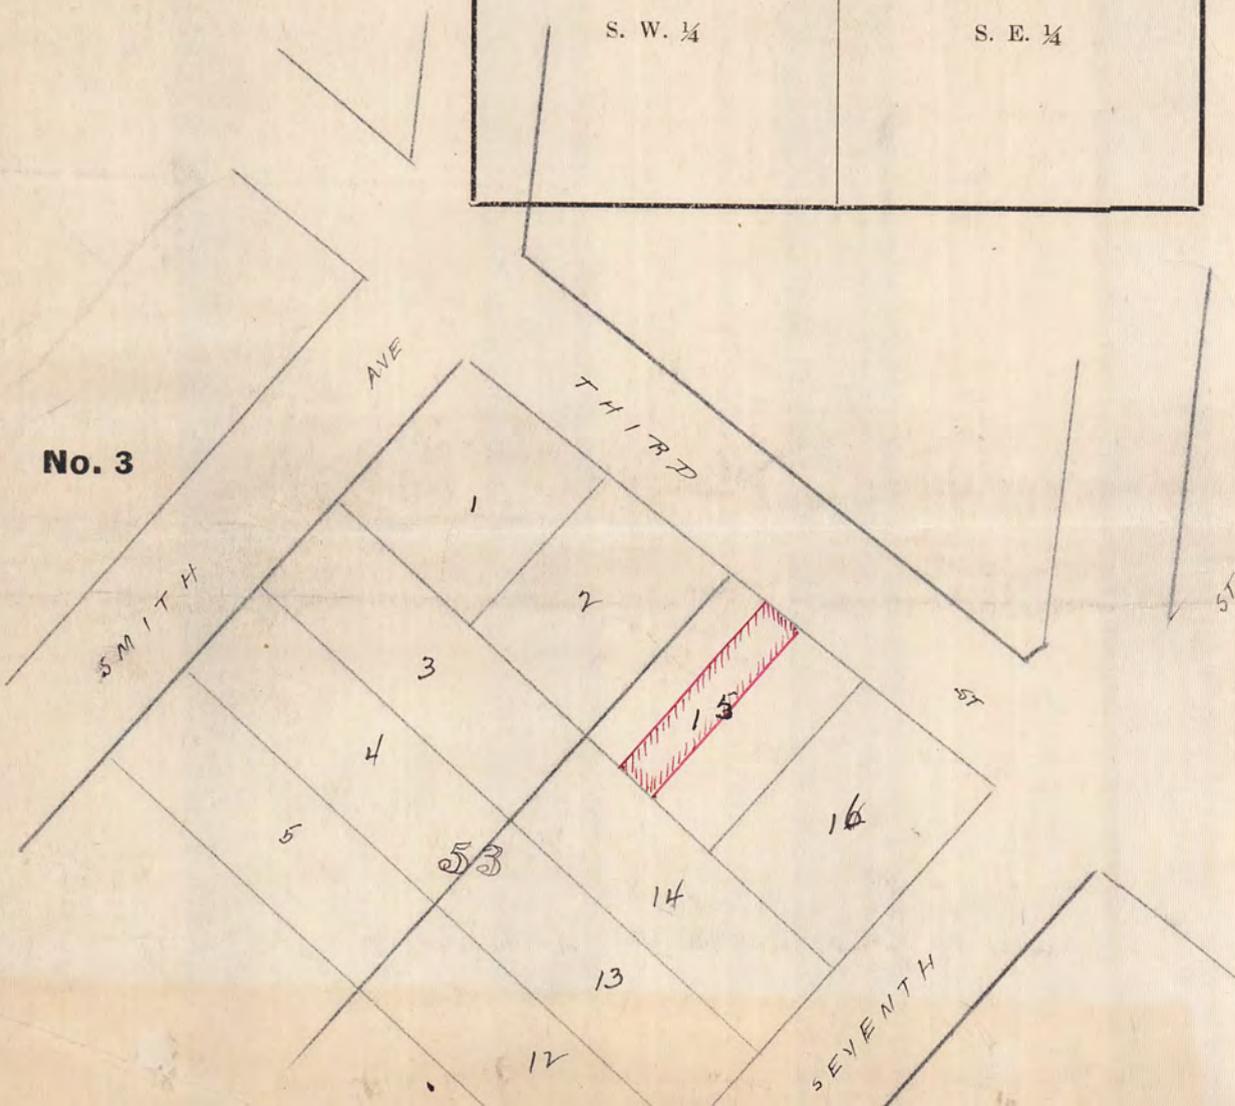

#1621