

#1042


1645

LOT 3, BLK. 4, G.V. BACON'S SUB. OF LOTS 11 & 12  
BUELL & MACKUBIN'S OUTLOTS.

SCALE: 15 FT. = 1 INCH.

JULY 3 - 1914.

R. R. GODFREY, SURVEYOR.

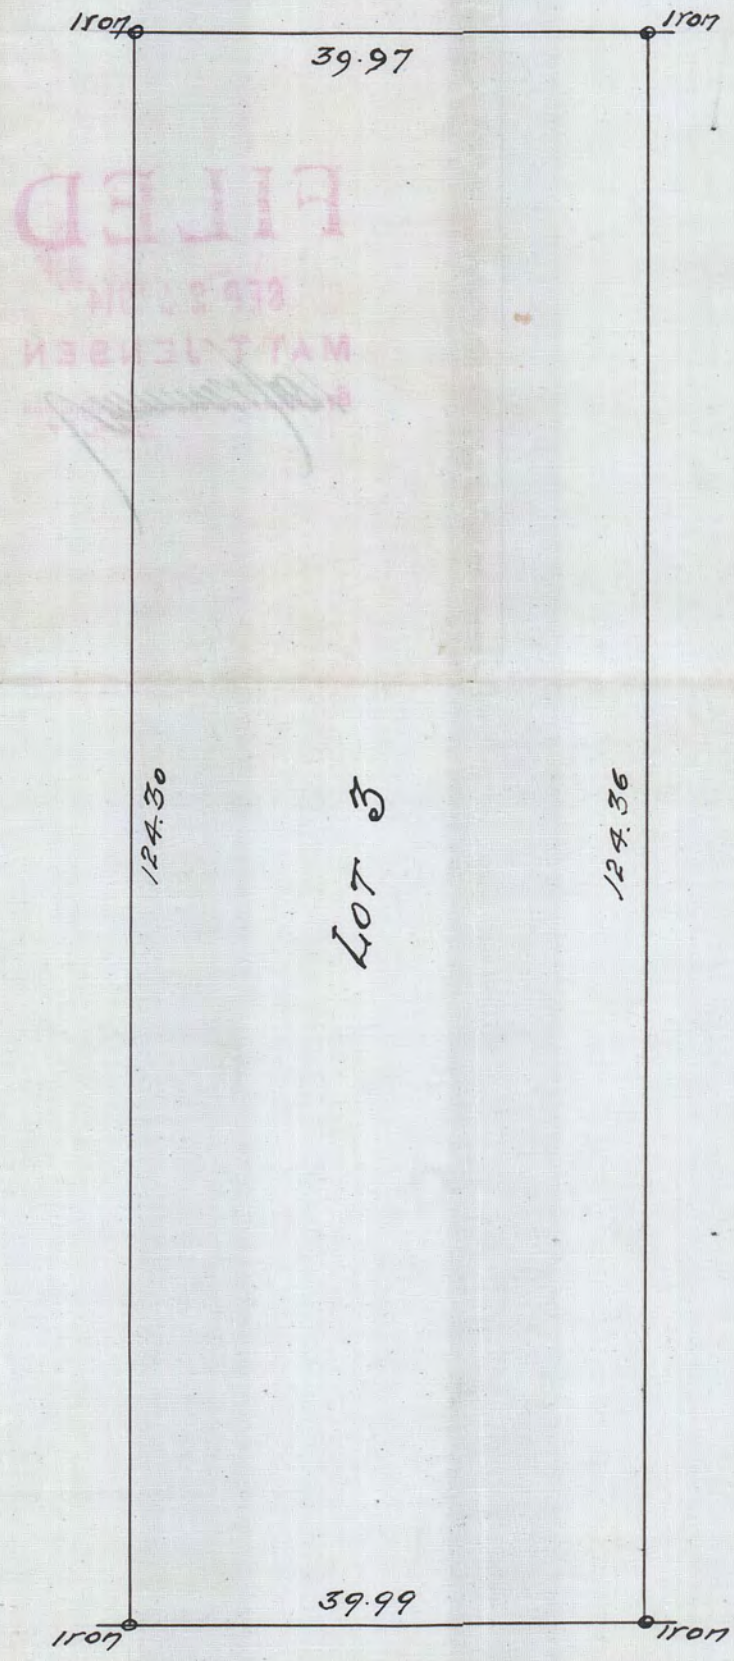

FILED  
MAY 23 1914  
MATT JENSEN  
REGISTER

CARROLL AVE.

66

*I hereby certify that the above is a true and correct plat of the above described property and that there are no encroachments hereon.*

*R. R. Godfrey, Surveyor.*

#1645

1645

# ABSTRACT OF TITLE,

Prepared by THE ST. PAUL ABSTRACT COMPANY.

No. 1.

Lot 3 Block 4  
"G. W. Racors Subdivision"


STATE OF MINNESOTA, }  
County of Ramsey. }

The St. Paul Abstract Company does hereby certify that the following exhibit, consisting of 17 sheets, from 1 to 17 inclusive (each of which bears its Corporate Seal), and 58 entries, from 1 to 58 inclusive, is a true and complete Abstract of Title to the real estate described in No. 1 hereof, as shown by the records in the office of the Register of Deeds in and for said County and State, up to this 6<sup>th</sup> day of April 1897, at 8 o'clock A.M.

Including Taxes & Profits

THE ST. PAUL ABSTRACT COMPANY,  
ABSTRACTERS.

J. H. Buchanan  
VICE PRESIDENT.

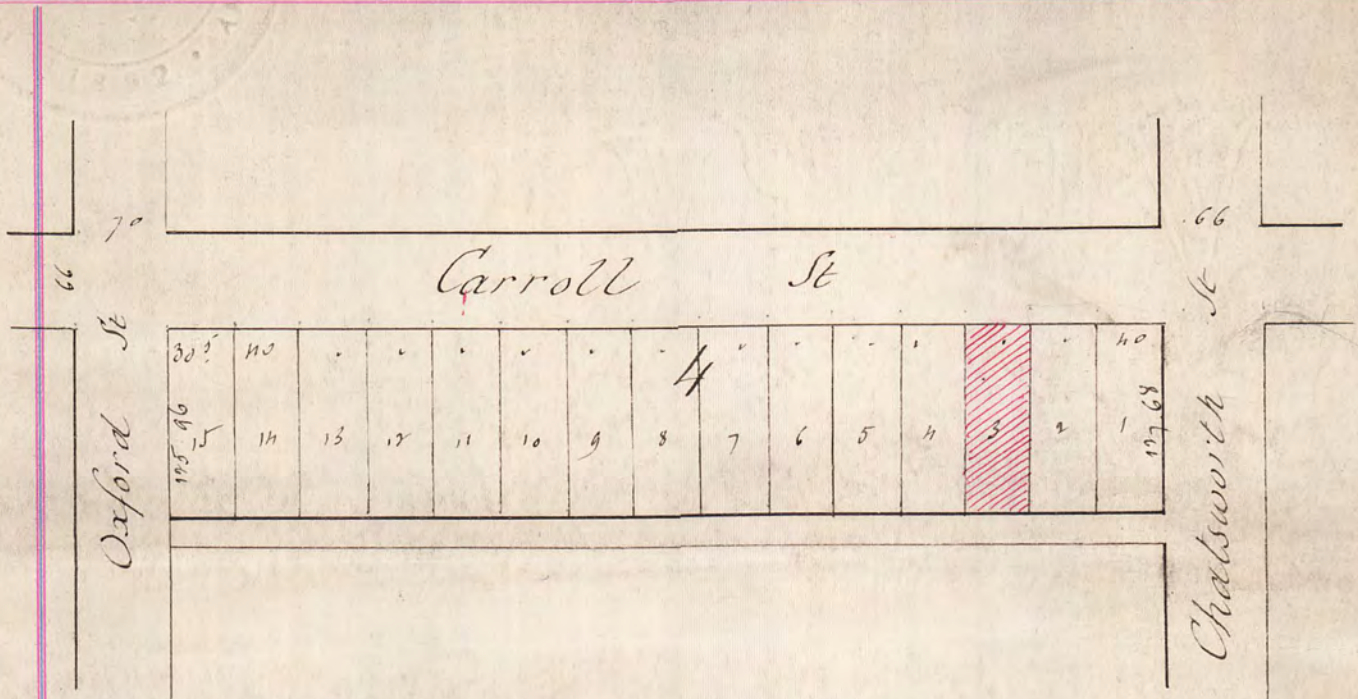

# 1645