


<sup>N</sup>  
**PRICE AND DESNOYER'S**  
**RE-AR.**  
 OF PART OF BLK 3 J. WHITNEY'S ADD AND  
 THAT STRIP OF LAND LYING BETWEEN BLK 3  
 AND JACKSON ST  
 MAY-1914

JENS PEDERSEN  
 SURV.  
 210 GLOBE BLDG

SCALE 20' = 1"

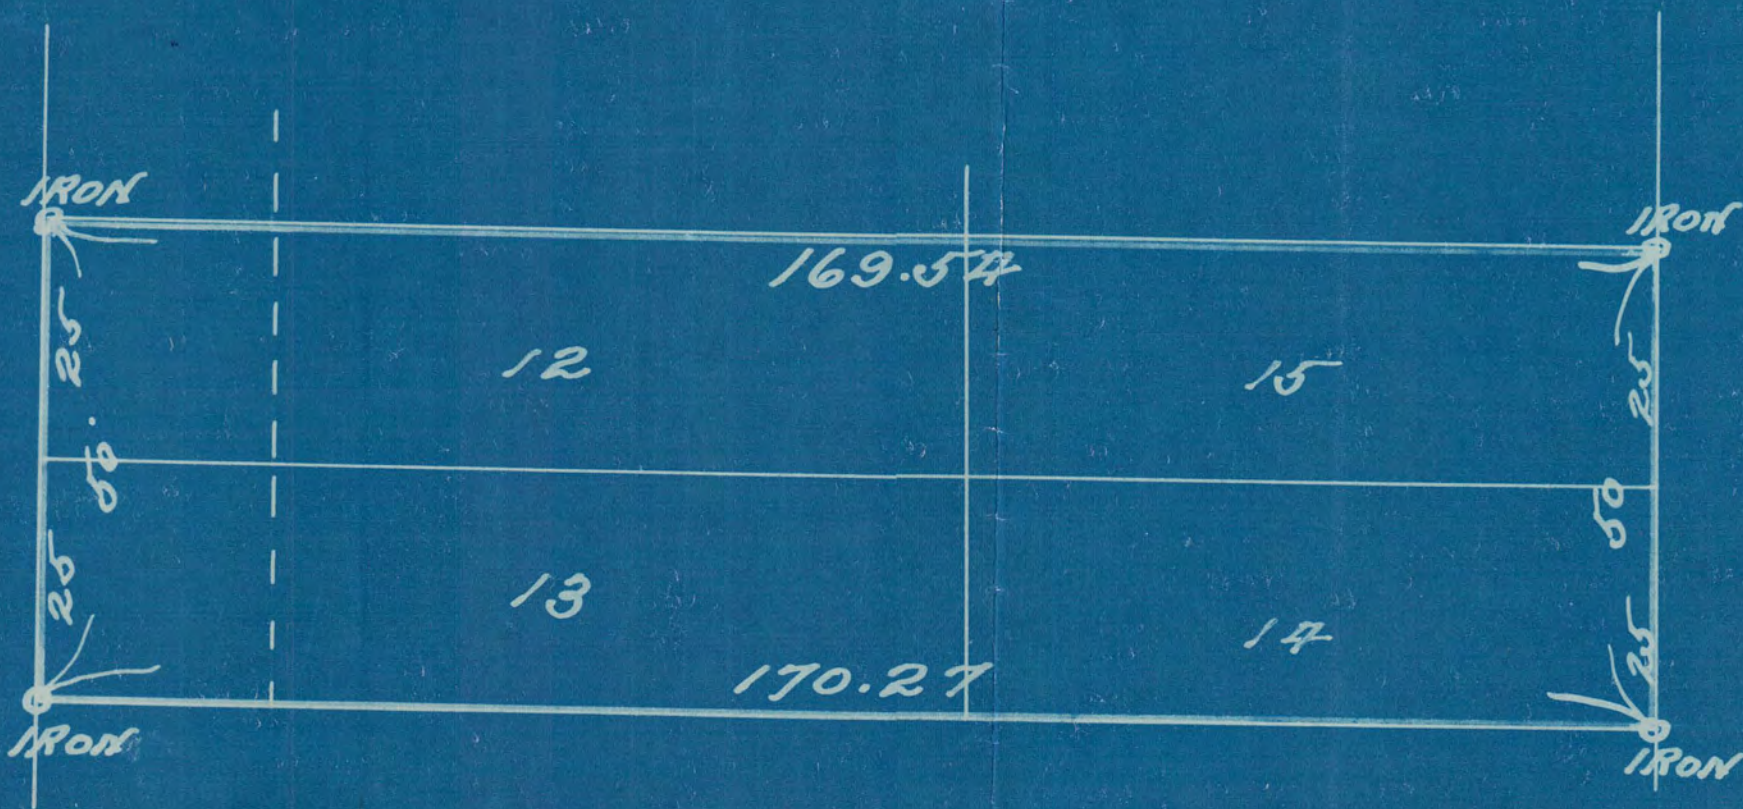

JACKSON ST.  
 W. E.  
 TEMPERANCE  
 63

# 1664