

1666

ABSTRACT OF TITLE

Prepared by The St. Paul Abstract Company

No. 1

To NW'ly 2/3 of lot 3 block 28 St. Paul Proper.

State of Minnesota }
County of Ramsey


The St. Paul Abstract Company does hereby certify that the following exhibit, consisting of 11 sheets, from 1 to 11 inclusive (each of which bears its Corporate Seal), and 55 entries from 1 to 55 inclusive, is a true and complete Abstract of Title to the real estate described in No. 1 hereof, as shown by the records in the office of the Register of Deeds in and for said County and State, up to this 18th. day of April 1894 191 at 8 o'clock A. M.

Mch. 12, 1914.

THE ST. PAUL ABSTRACT COMPANY
ABSTRACTERS.

J. A. Buchanan
VICE-PRESIDENT

- 2 -

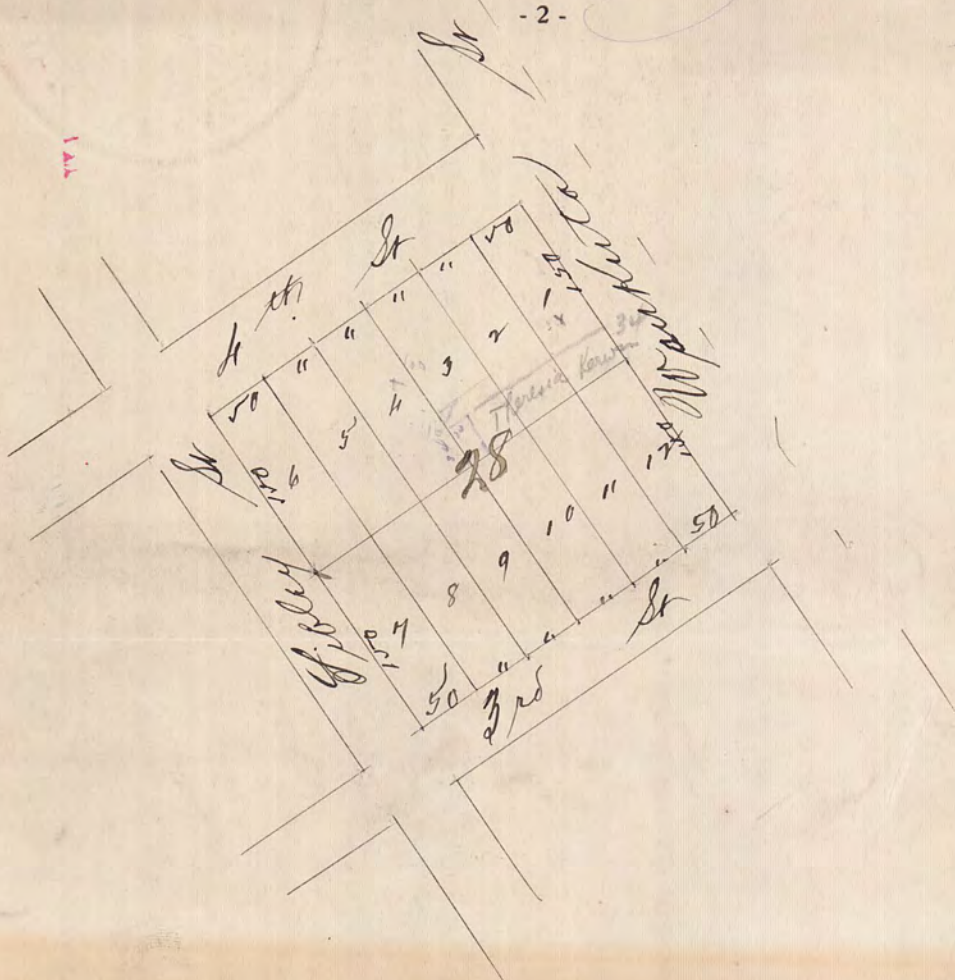

1666

ST PAUL PROPER.
SURVEY OF
NLY 2/3 OF LOT 3 BL 28
MAR 20-1914 JENS PEDERSEN
SURY.
SCALE 10' = 1"

E. FOURTH ST.



48.5
38

48.5

29

1666