

1679

HUGHES MIDWAY ADD SURVEY OF


LOTS 11, 12, 13, 14 AND 15
JENS PEDERSEN SURV.
JUNE 13-1914

I HEREBY CERTIFY TO HAVING SURVEYED LOTS 11, 12, 13, 14 AND 15 HUGHES MIDWAY ADD AND HAVE PLACED IRON MONUMENTS AT THE CORNERS AS SHOWN ON THIS PLAT. AND ALL LOCATIONS AND DISTANCE AS HEREON SHOWN ARE CORRECT.

SCALE 20' = 1"

Jens Pedersen
SURV

NO ENCROACHMENTS ON ABOVE DESCRIBED PROPERTY.

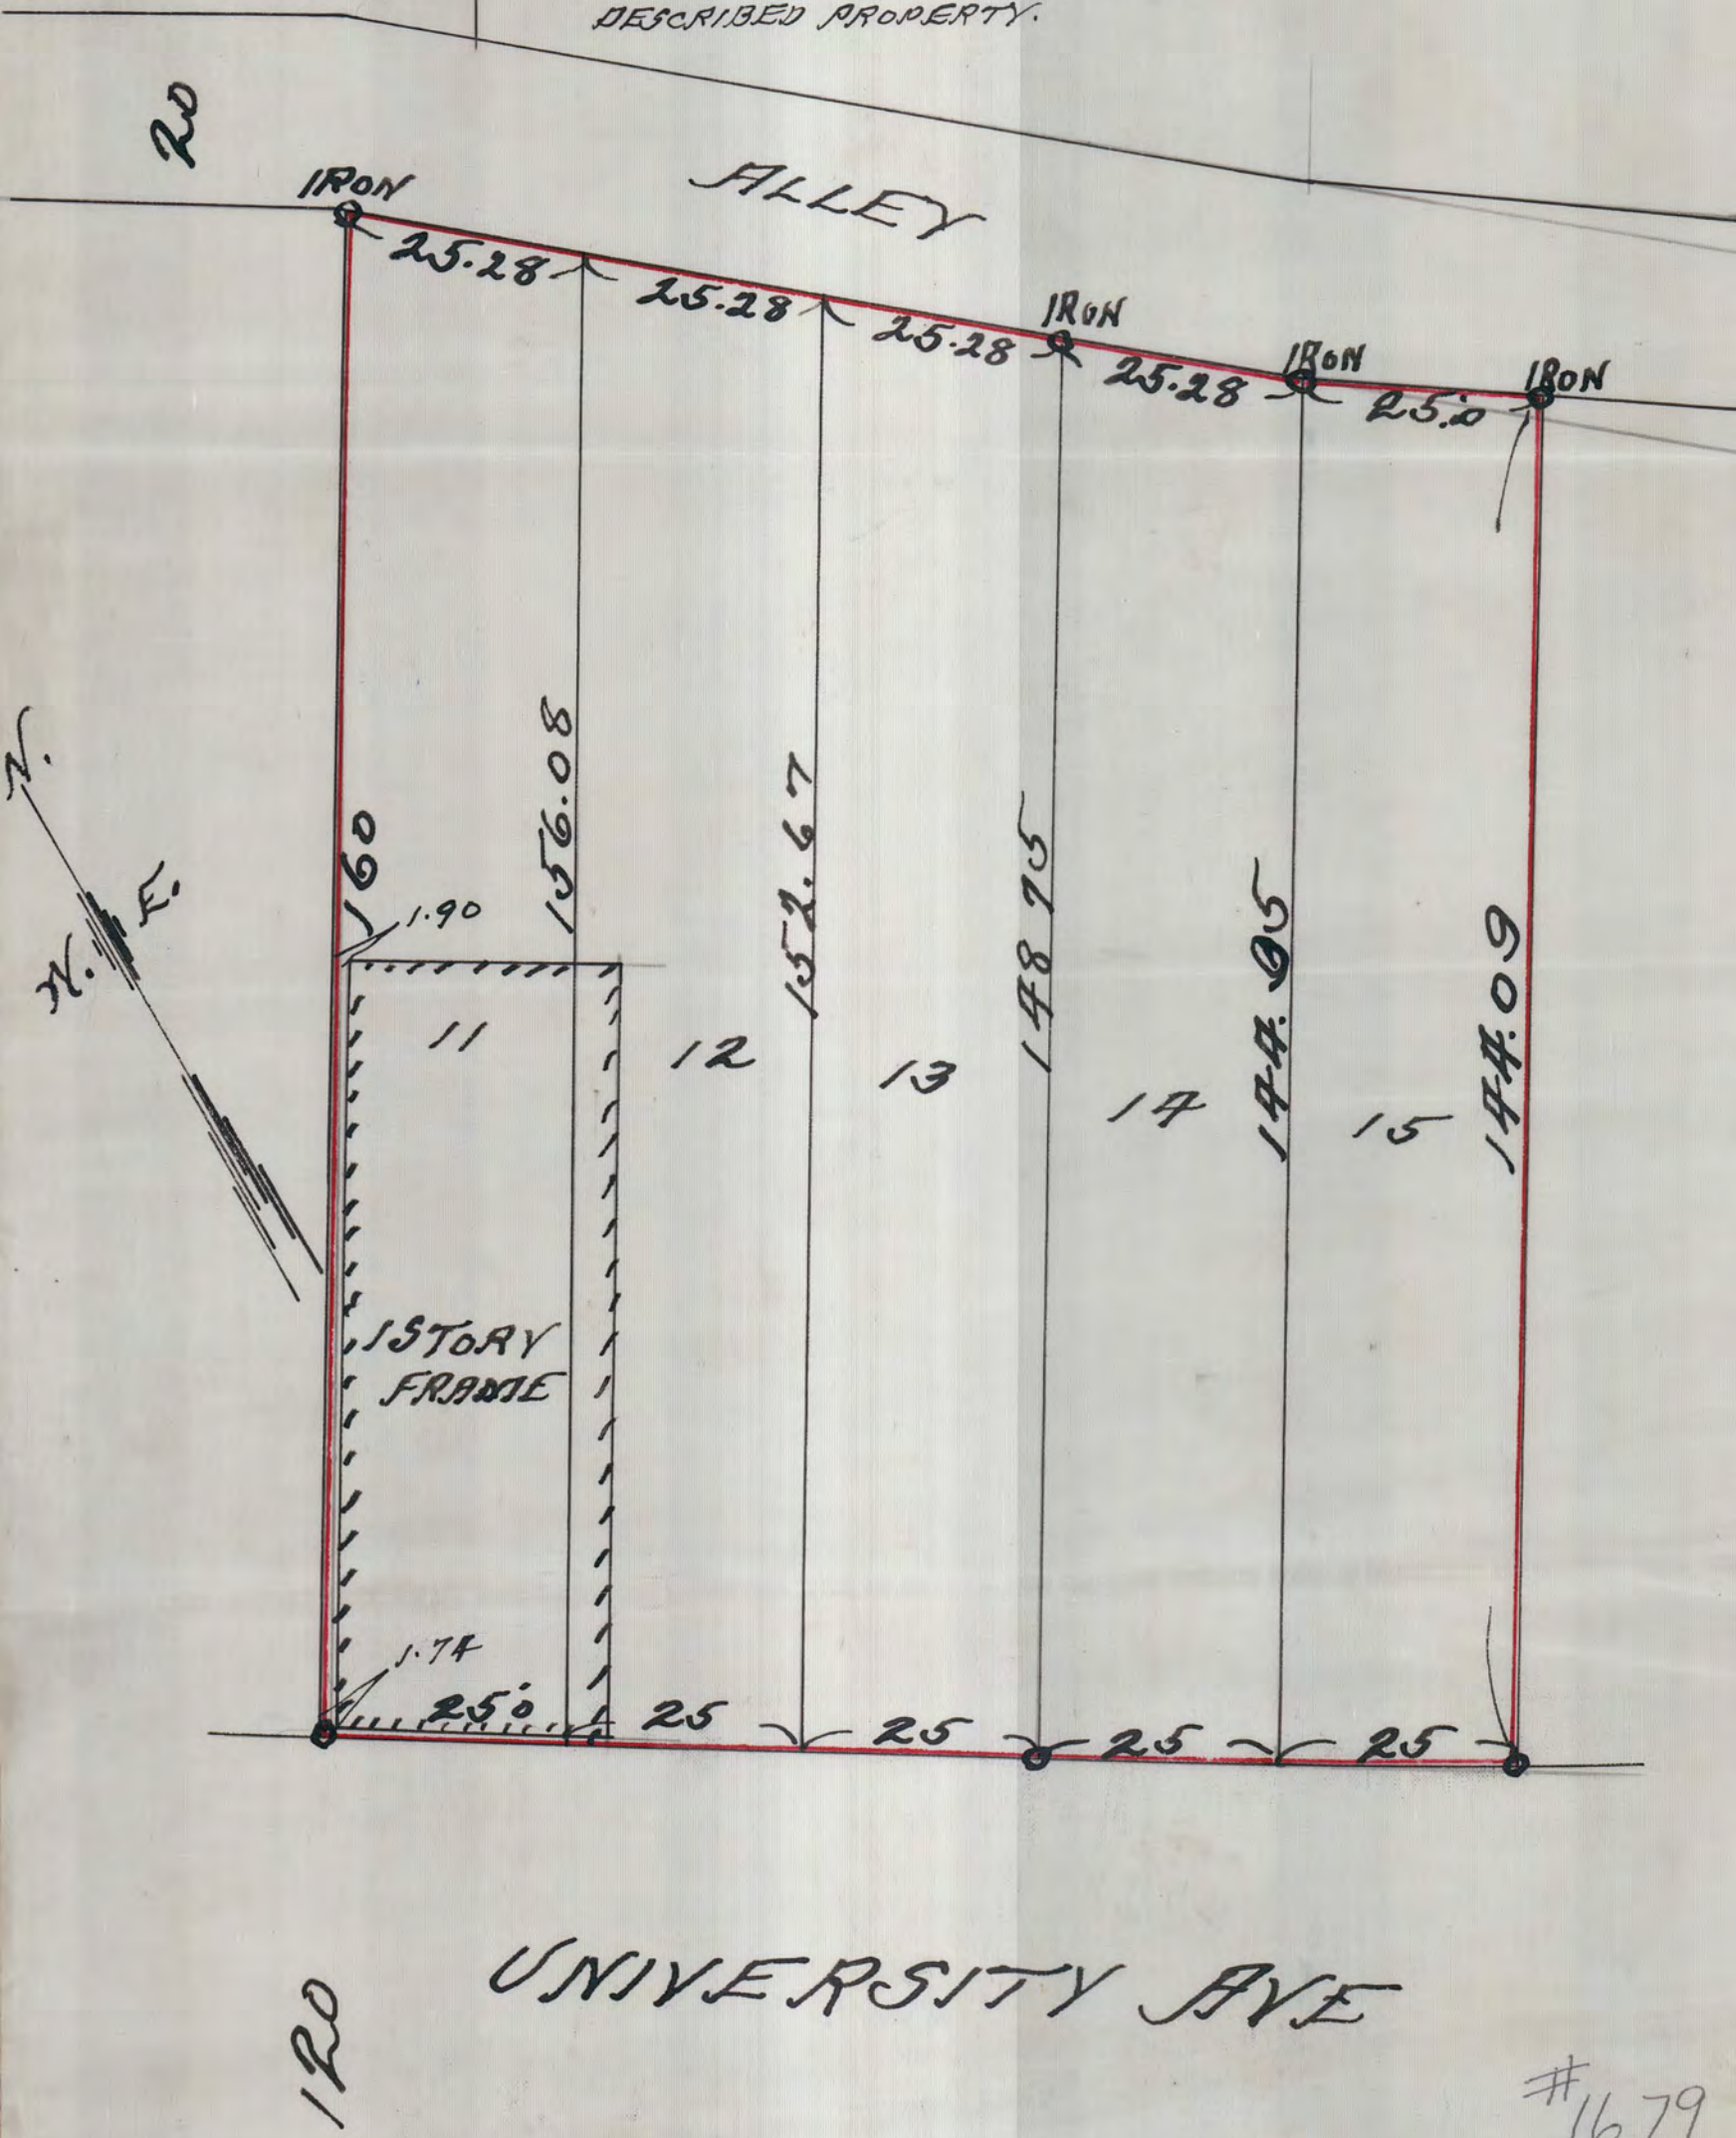

#1679