



1687

E. H. HAWKS SUB  
 OF  
 WINSLOW'S ADD  
 SURVEY OF  
 NLY 92 FT OF ELY 32 1/2 FT OF LOT 13 BL 20  
 JULY 23-1914 JENS PEDERSEN SURV  
 SCALE 20' = 1"

ST PAUL MINN JULY 23-1914  
 I HEREBY CERTIFY THAT THIS DIAGRAM  
 CORRECTLY REPRESENTS LOTS 13, 14, 15 AND 16  
 BLOCK 20 E. H. HAWKS SUB OF WINSLOW'S ADD  
 TO ST PAUL AND PARTICULARLY THE ELY 32 1/2 FT  
 OF THE NLY 92 FT OF THE ELY 32 1/2 FT OF  
 SAID LOT 13.

Jens Pedersen  
 SURV.

BANFIL ST.

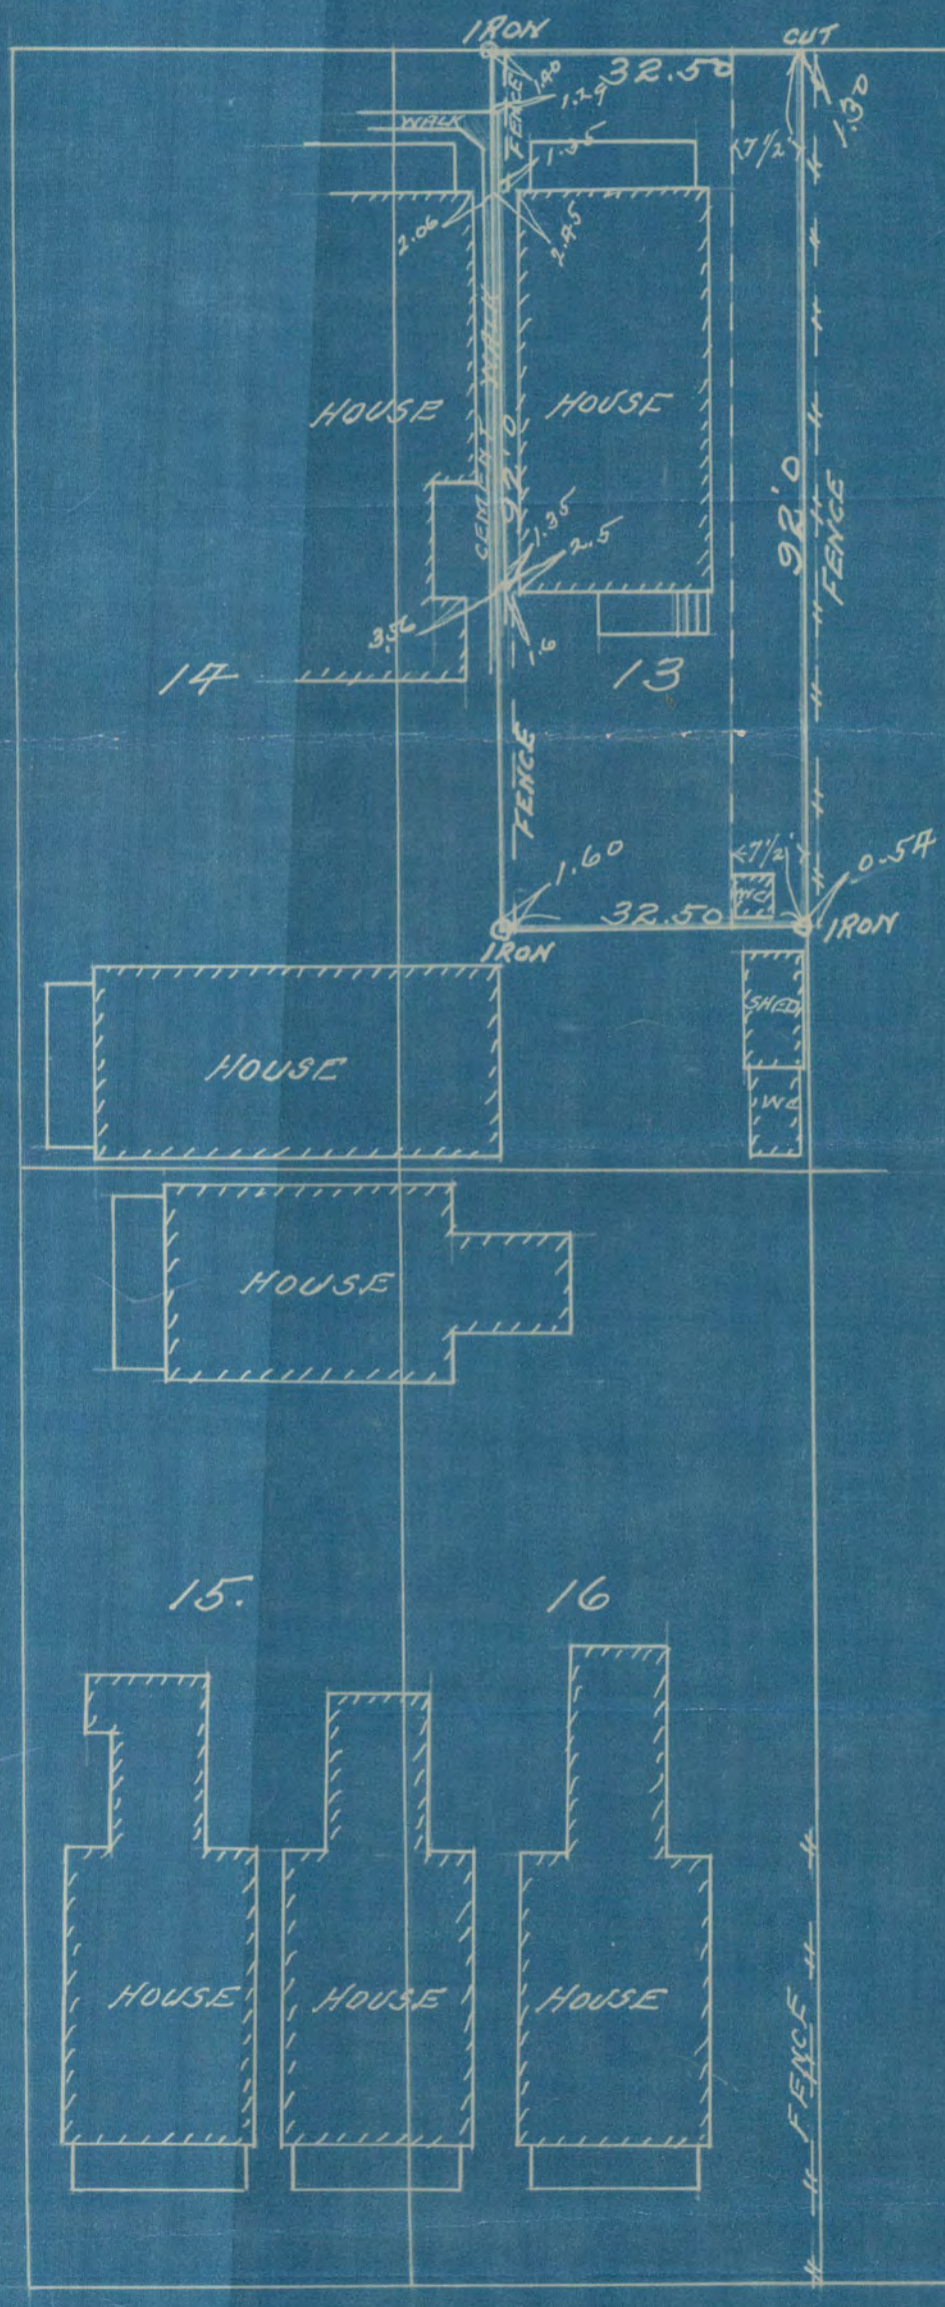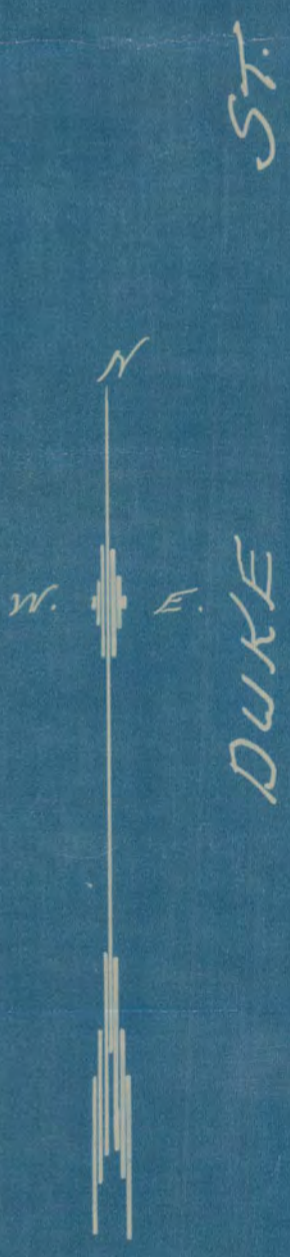

66

GOODHUE ST.

# 1687