

N

LOT 26 BLOCK 2.

J.G. STOUTS ADD.


JOHN B. IRVINE SURVEYOR.

408 GLOBE BLDG.

ST. PAUL, MINN.

AUG. 5-1914

scale 20ft. per inch.

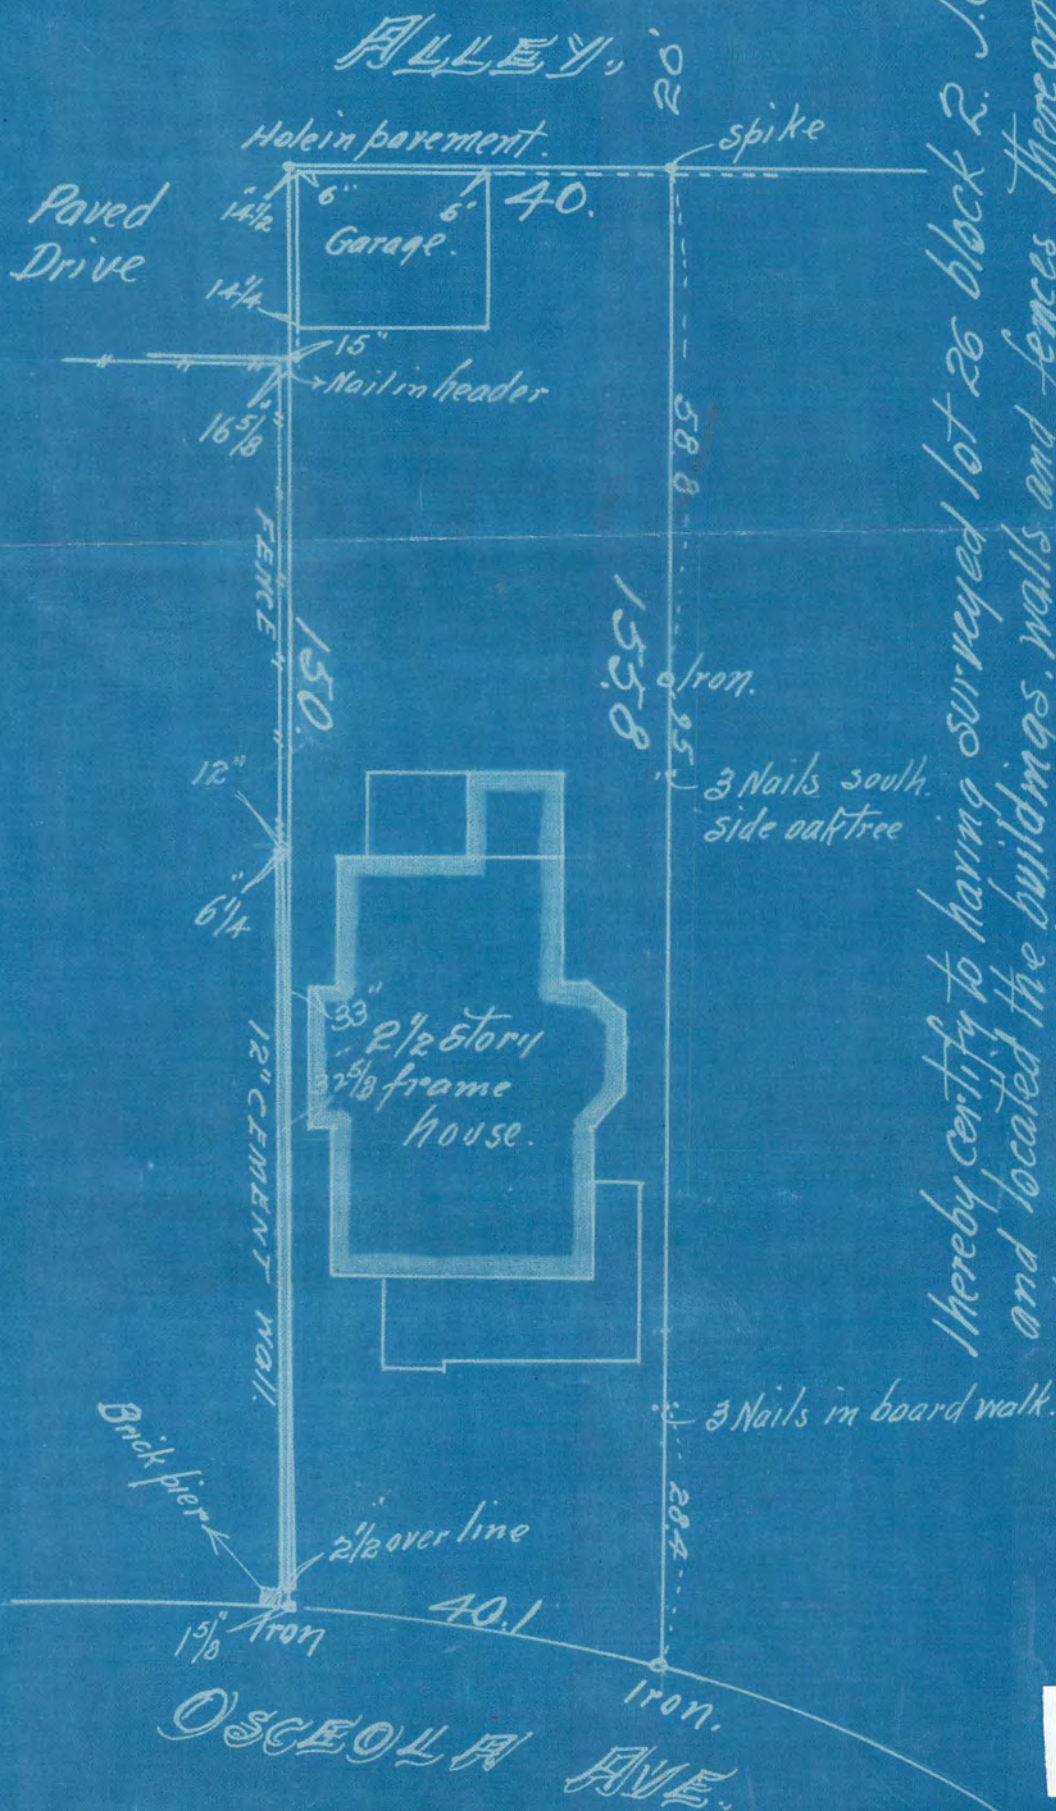


Thereby certify to having surveyed lot 26 block 2. J.G. Stout's Add.
 and located the buildings, walls and fences thereon as shown by
 this plat and the same is correct.
 August 5-1914.
 John B. Irvine Surveyor.

LOT 26 BLOCK 2
J.G. STOUTS ADD

JOHN B. IRVINE SURVEYOR
408 GLOBE BLDG.
ST. PAUL, MINN.
AUG. 5-1914

scale 20ft. per inch.

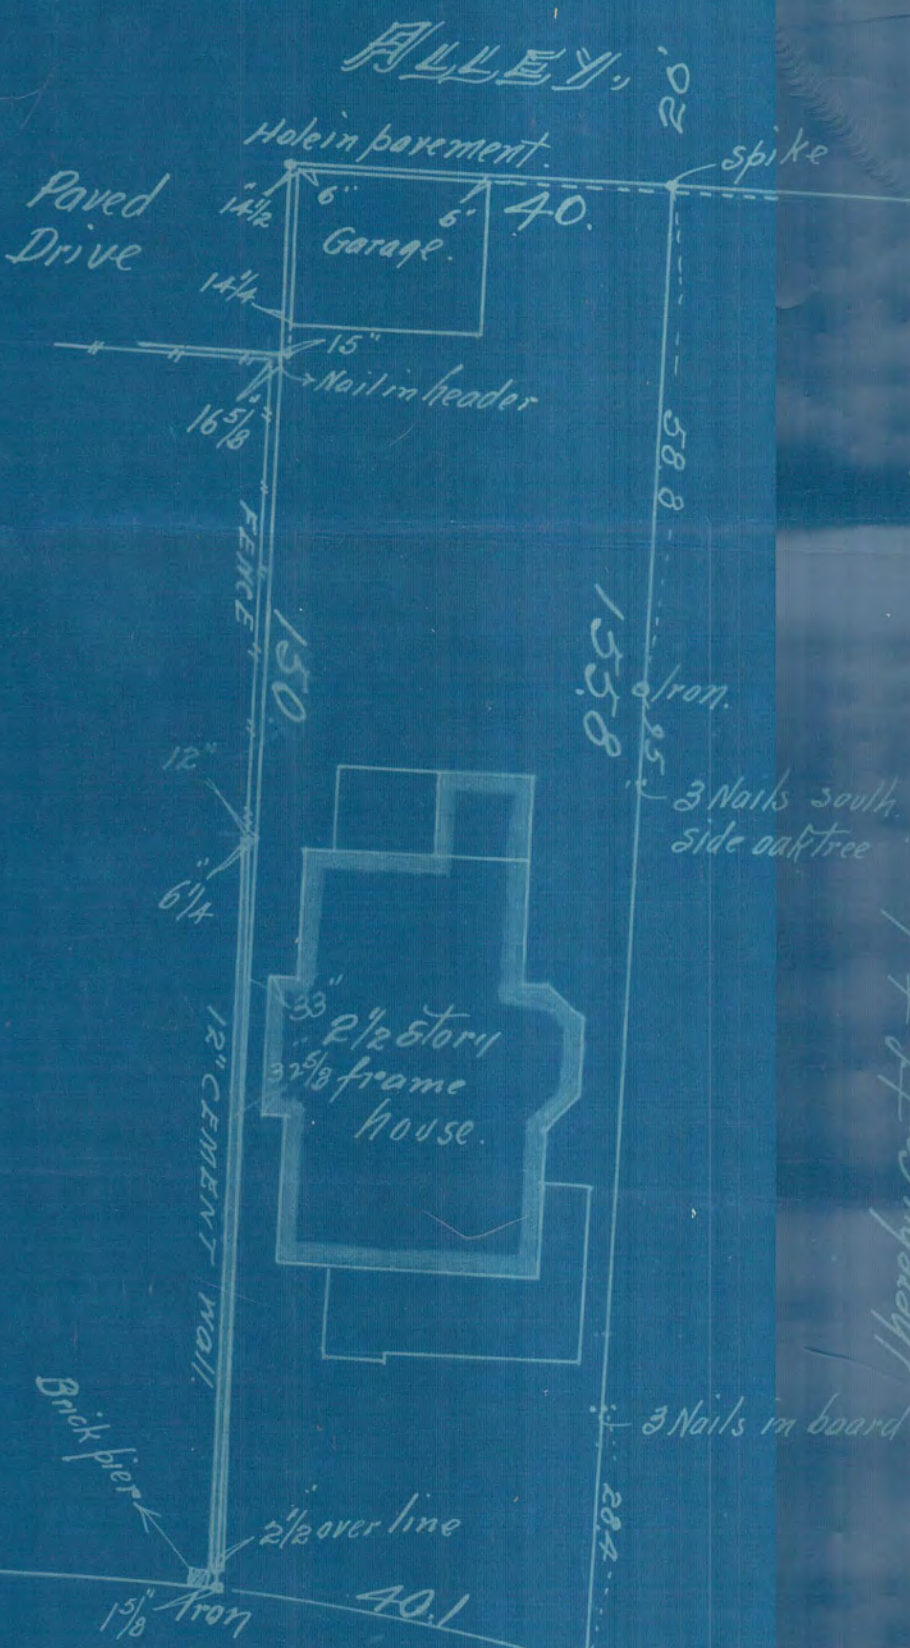

I hereby certify to having surveyed lot 26 block 2 J.G. Stout's Add. and located the buildings, walls and fences thereon as shown by this plat and the same is correct.
August 5-1914.

John B. Irvine Surveyor.

OSCEOLA AVE