


SOUTHERLY 125ft. of  
 LOT 3 & PART OF LOT 4 BLOCK 9.  
 HOYT'S ADD.

JOHN B. IRVINE, SURVEYOR.  
 408 GLOBE BLDG.  
 ST. PAUL, MINN.  
 FEB. 24-1914  
 scale 20 ft. per inch.

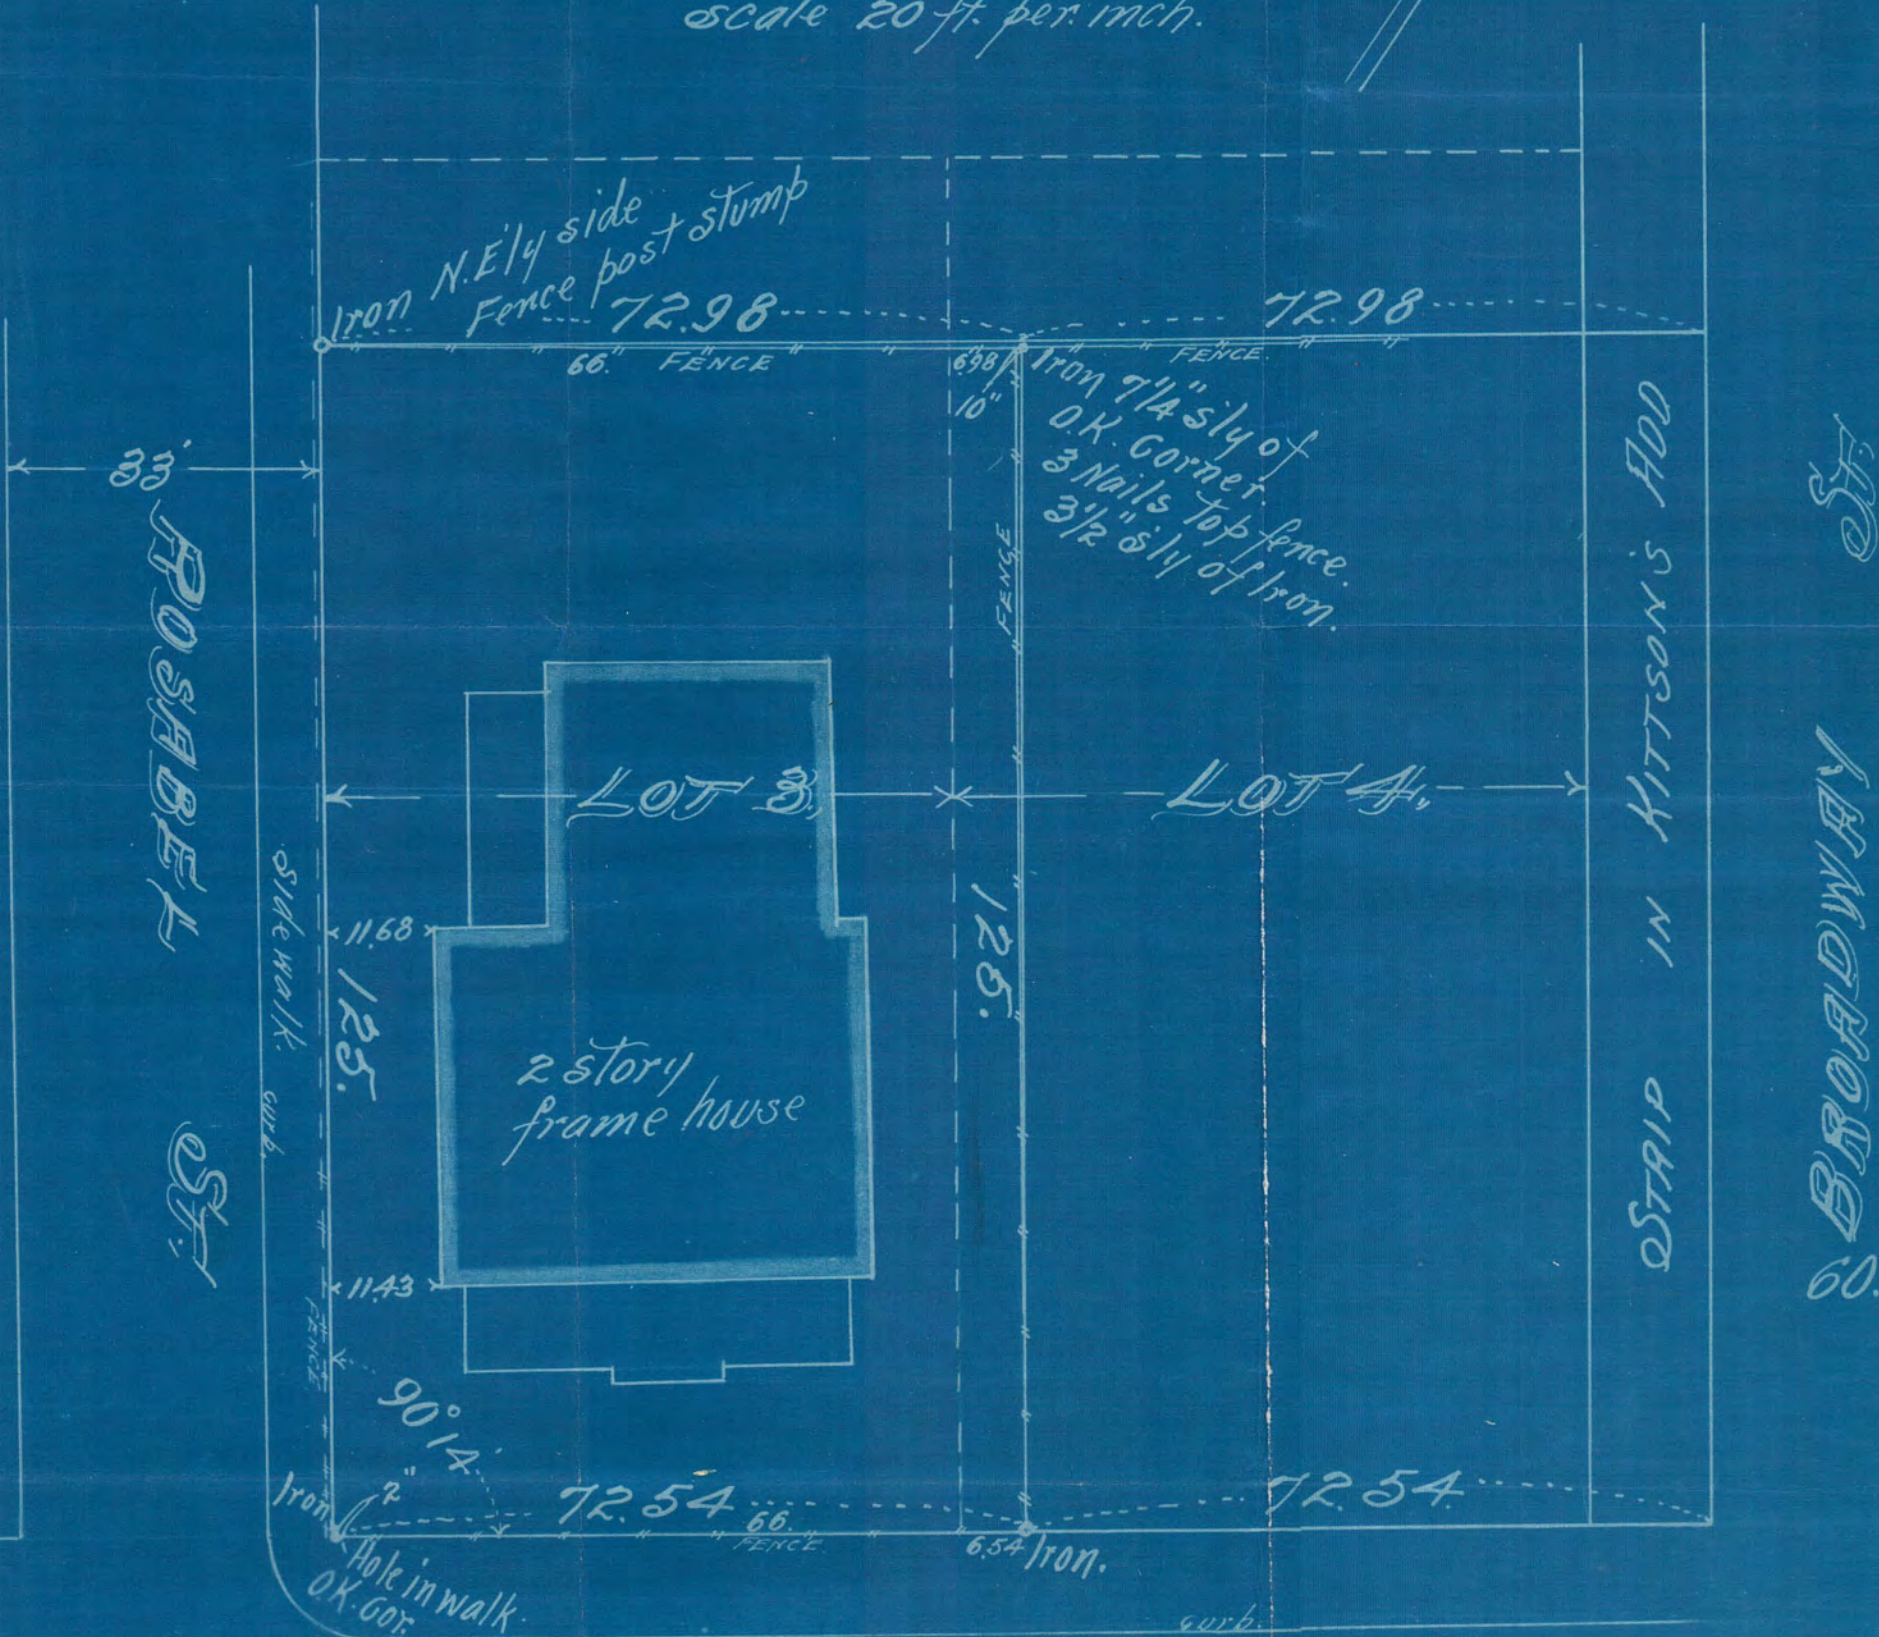

# 1706