

KUMTIS ADD

SURVEY OF


WLY 1/3 OF LOTS 1, 2 AND 3 BL 5

AUG-18-1914

JENS PEDERSEN
SURV.

E FIFTH ST

60

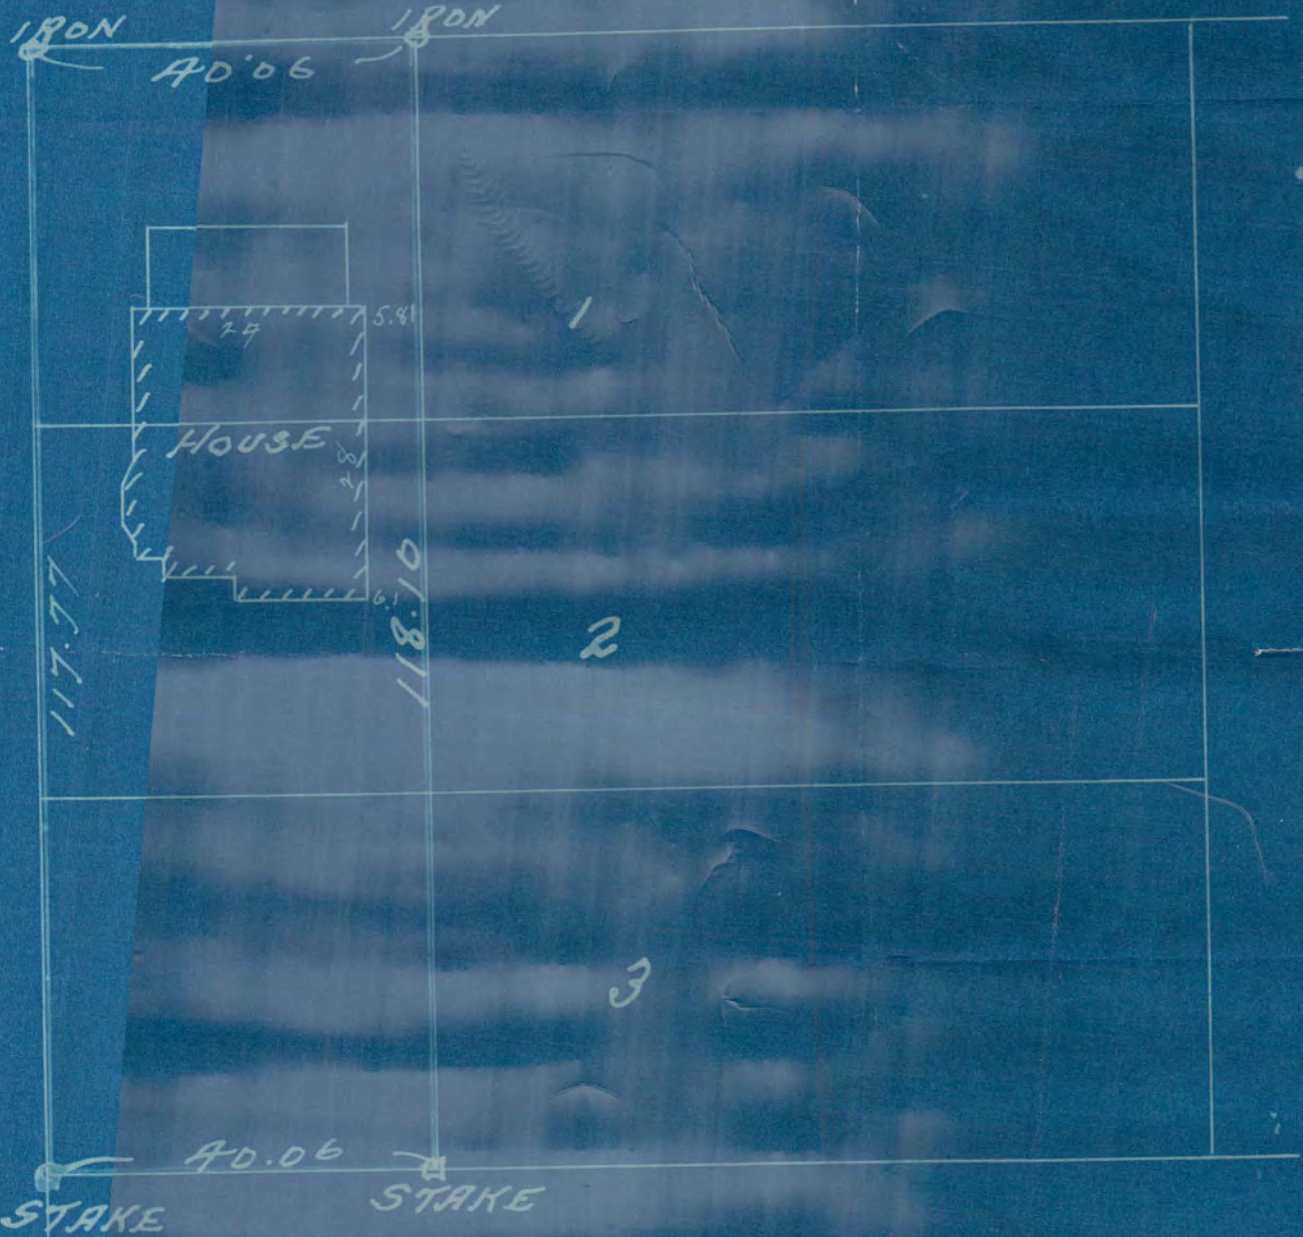

ST.

W E

SCALE 20' = 1"

CYPRESS

60

STAKE

STAKE

1718