


1724

H. F. SCHWABES ADD SURVEY OF

LOTS 30 AND 32 BLK 4
SEPT 28-1914 JENS PEDERSEN
SCALE 20'=1" SURY.

ALLEY.

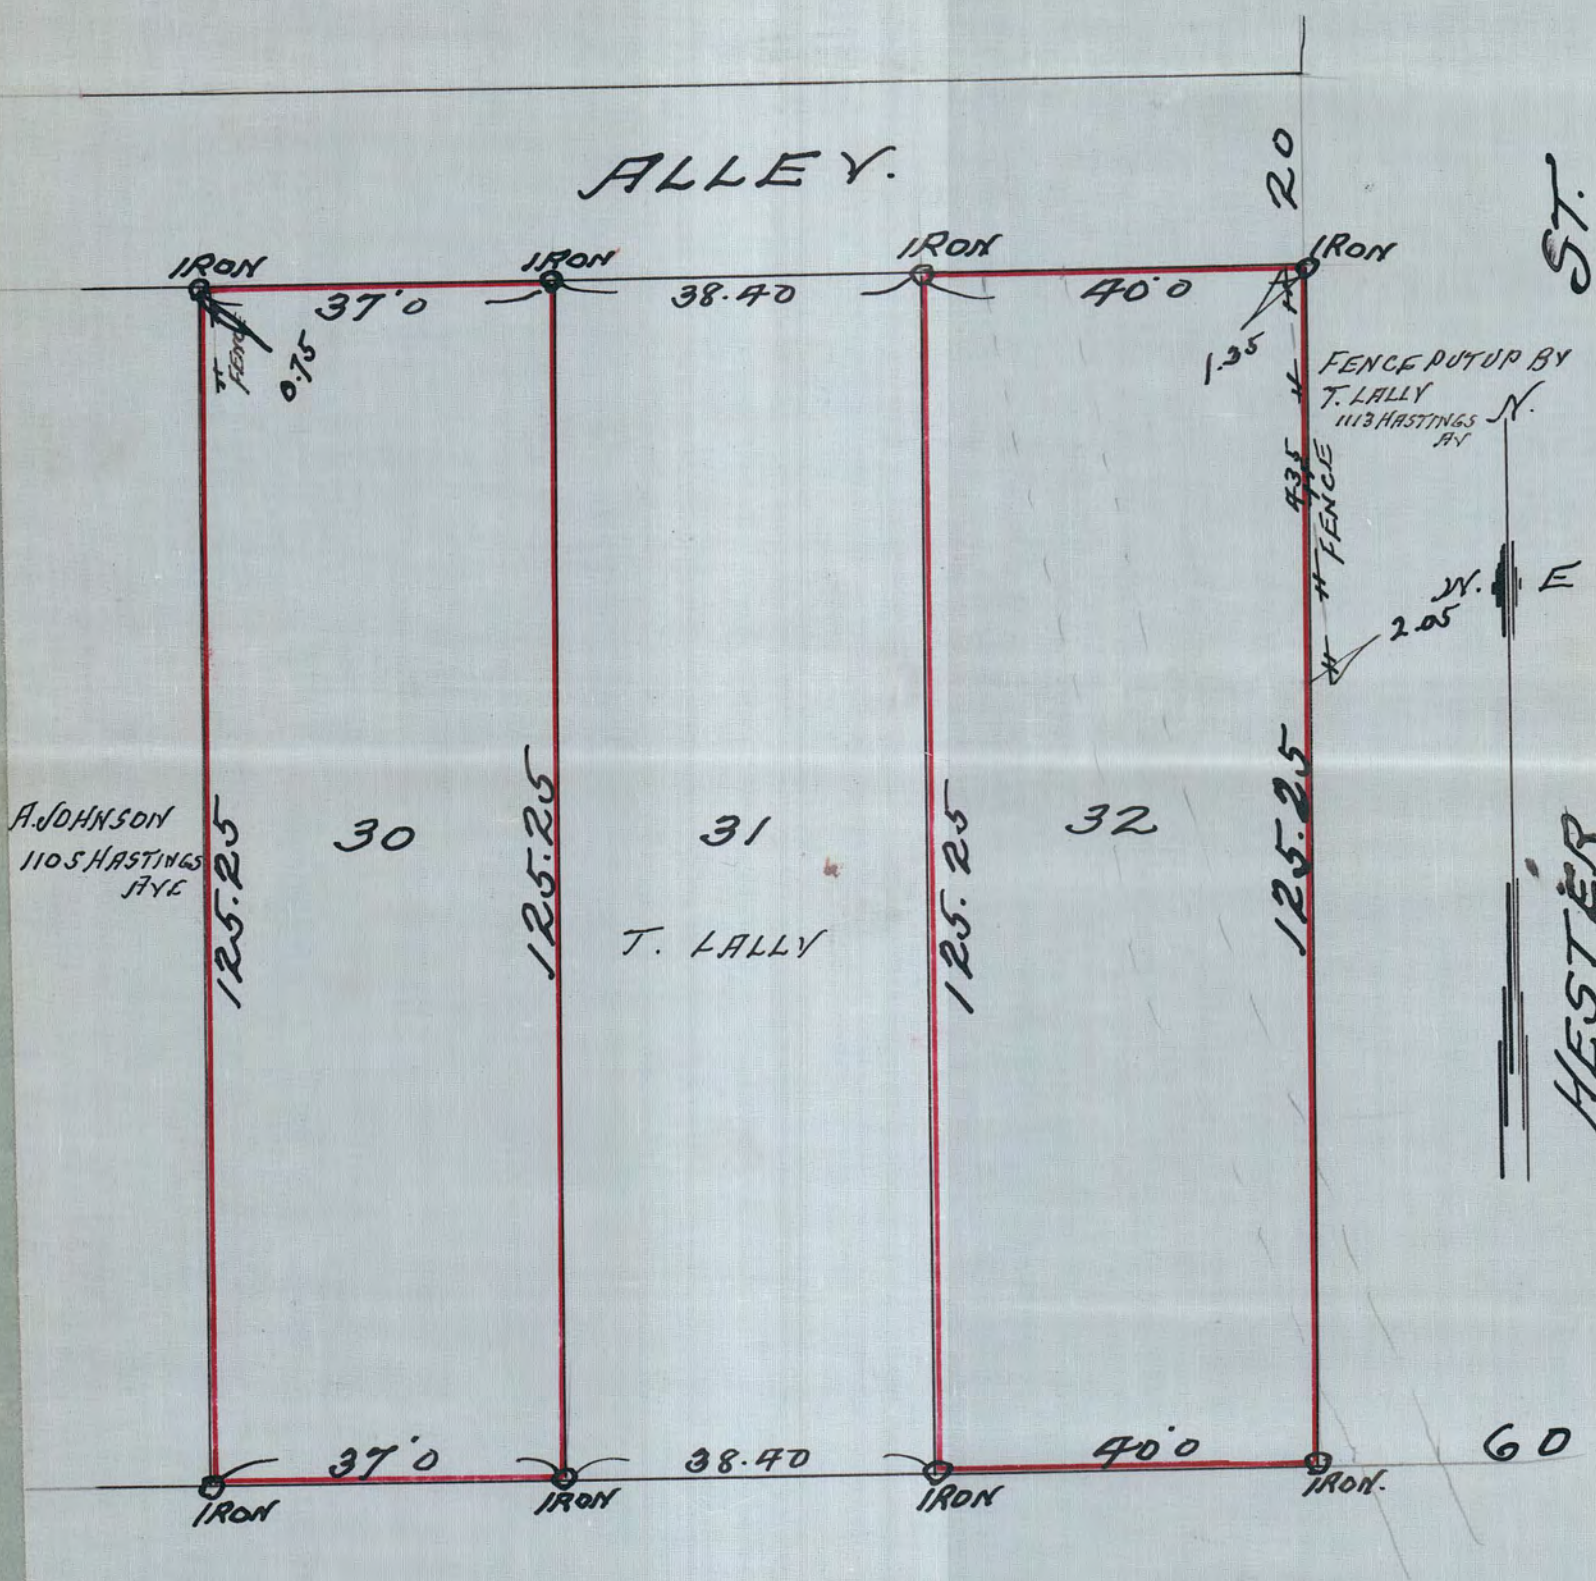

HASTINGS AVE 66

1724