


WAYNES ADD  
SURVEY OF  
LOT 8 BL. 1.  
SEPT 23-1914 JENS PEDERSEN  
SURV.  
SCALE 10' = 1"

60

MINNEHAHA ST

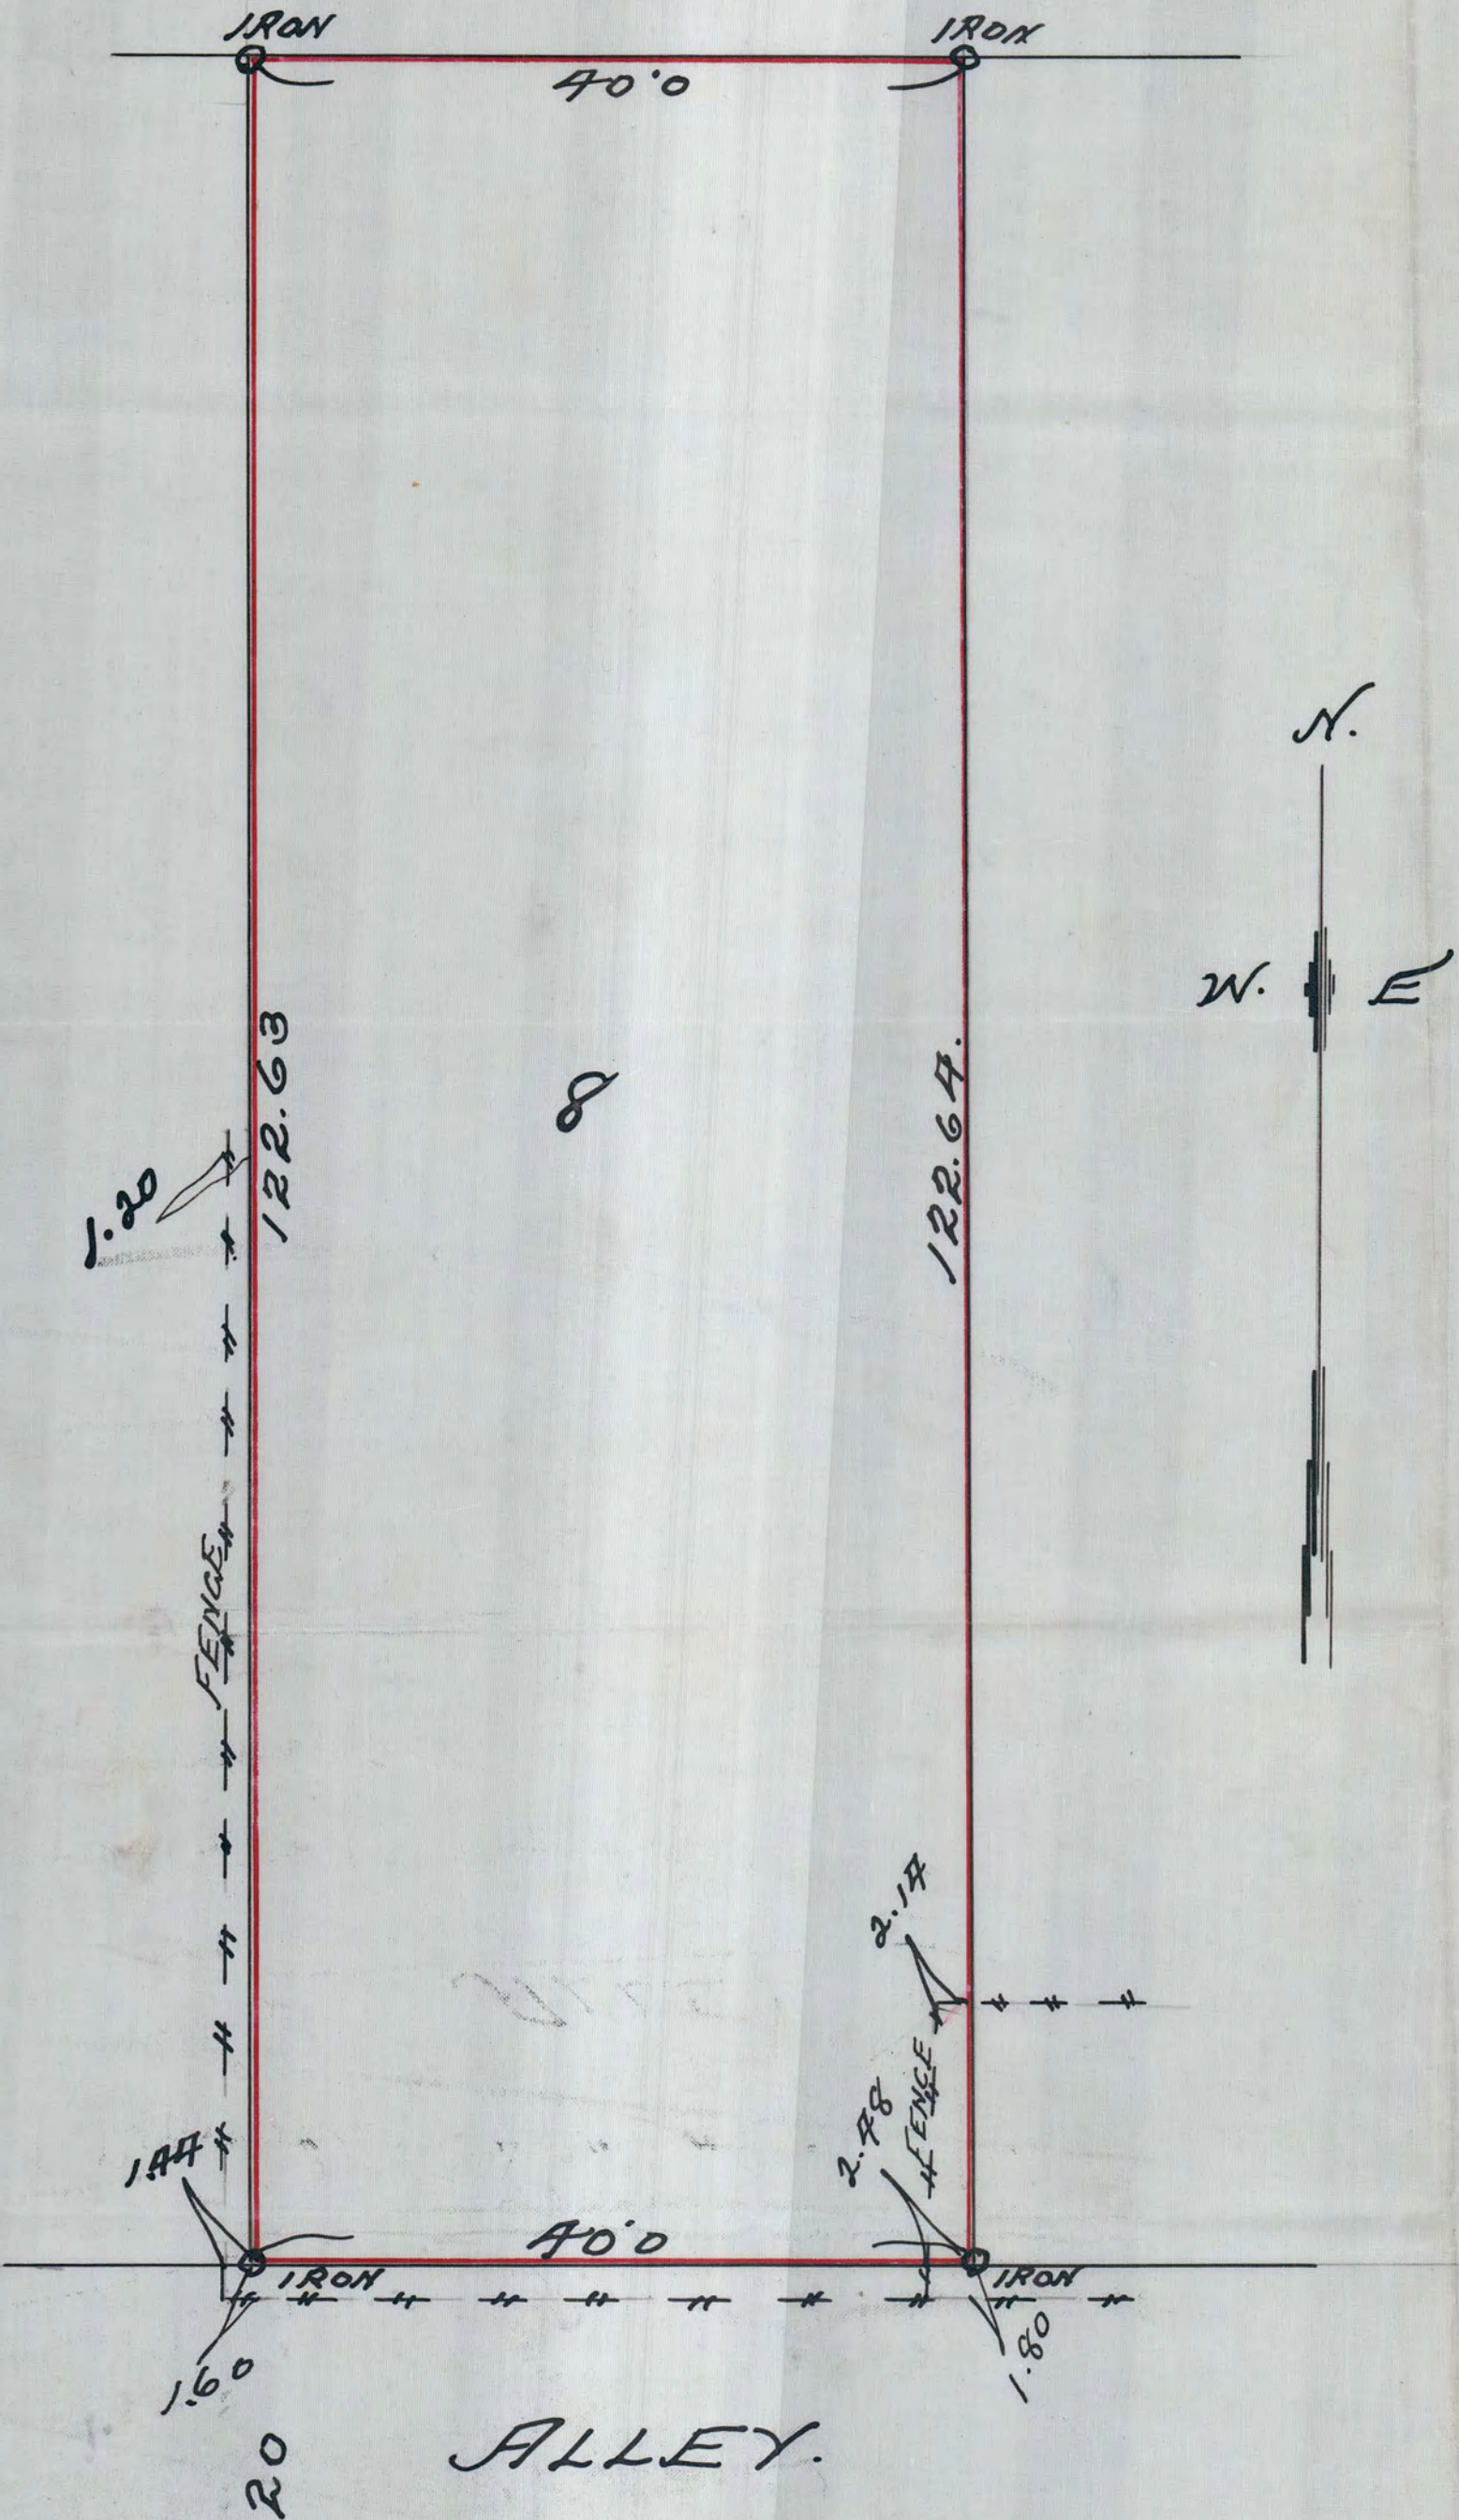

#1726