


MAYALL'S SUB  
 OF BLK. I WHITNEY AND SMITH'S ADD.  
 AND BLK 17 ROBERT AND RANDALL'S ADD.  
 SURVEY OF

LOTS 1, 2, 13, 14, 15 AND S.WLY 1/2 OF 3 AND 12

DEC 5-1914

SCALE 10 FT = 1 IN

JENS PEDERSEN  
 SURV

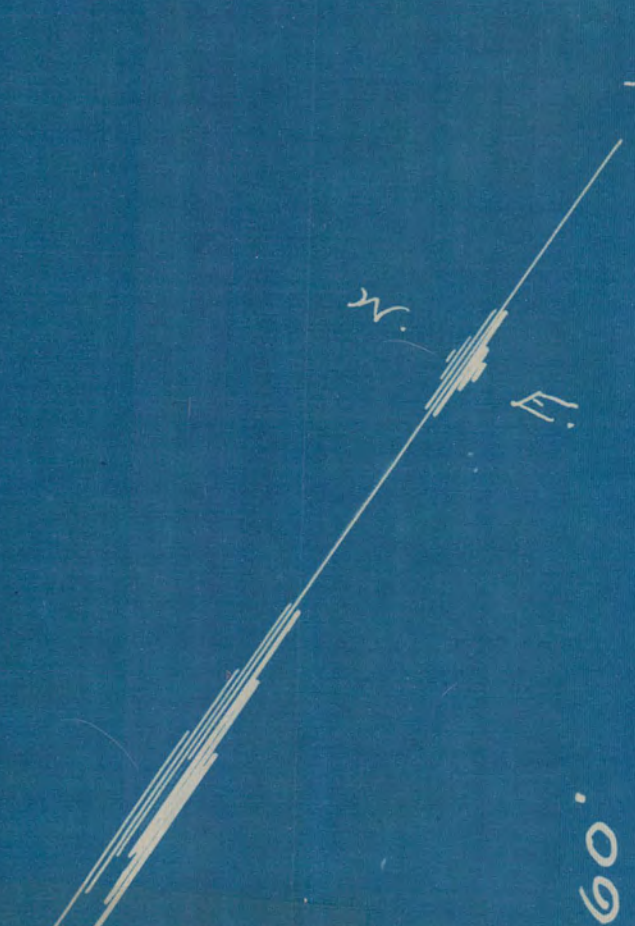


E. EIGHTH

ST.

ST.

JACKSON

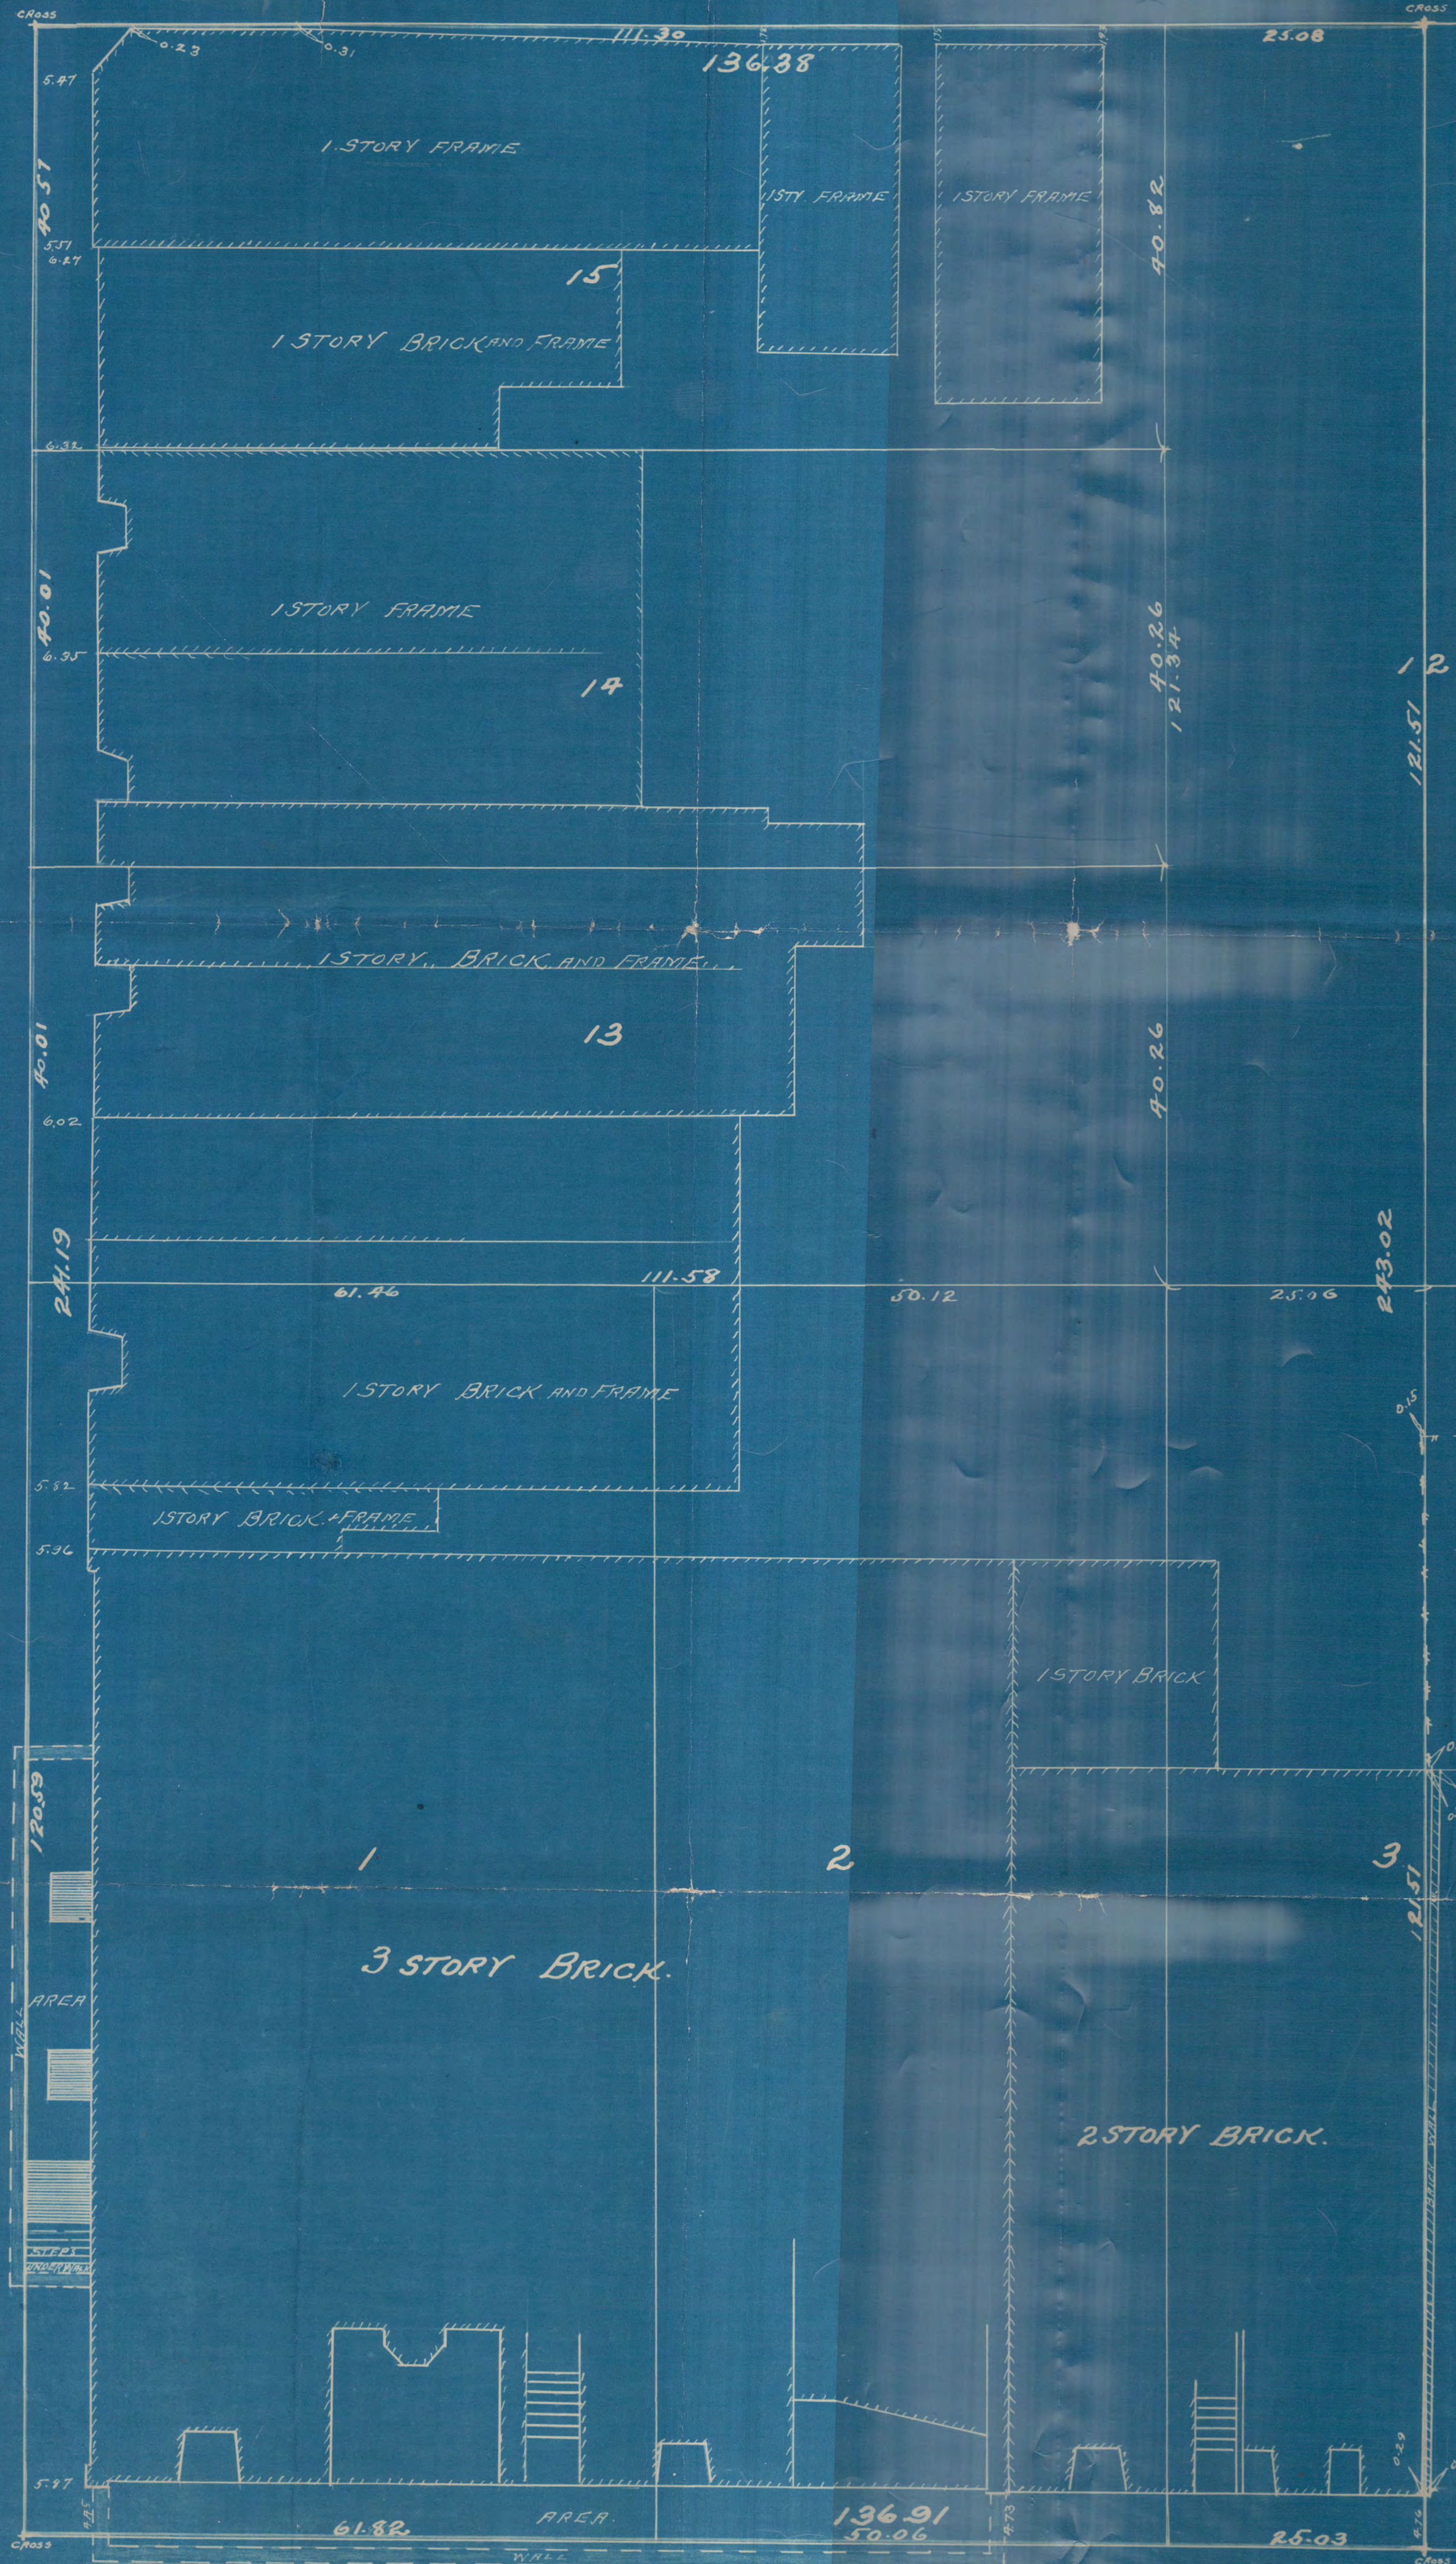

E. SEVENTH

ST.