


ASHTON AND SHERBURNES ADD
 SURVEY OF
 LOTS 9 AND 10 BL 7
 WLY OF JACKSON ST
 AND 1/2 OF HILLSDALE ST VACATED
 DEC 19-1914
 JENS PEDERSEN
 SCALE 20' = 1" SURV.

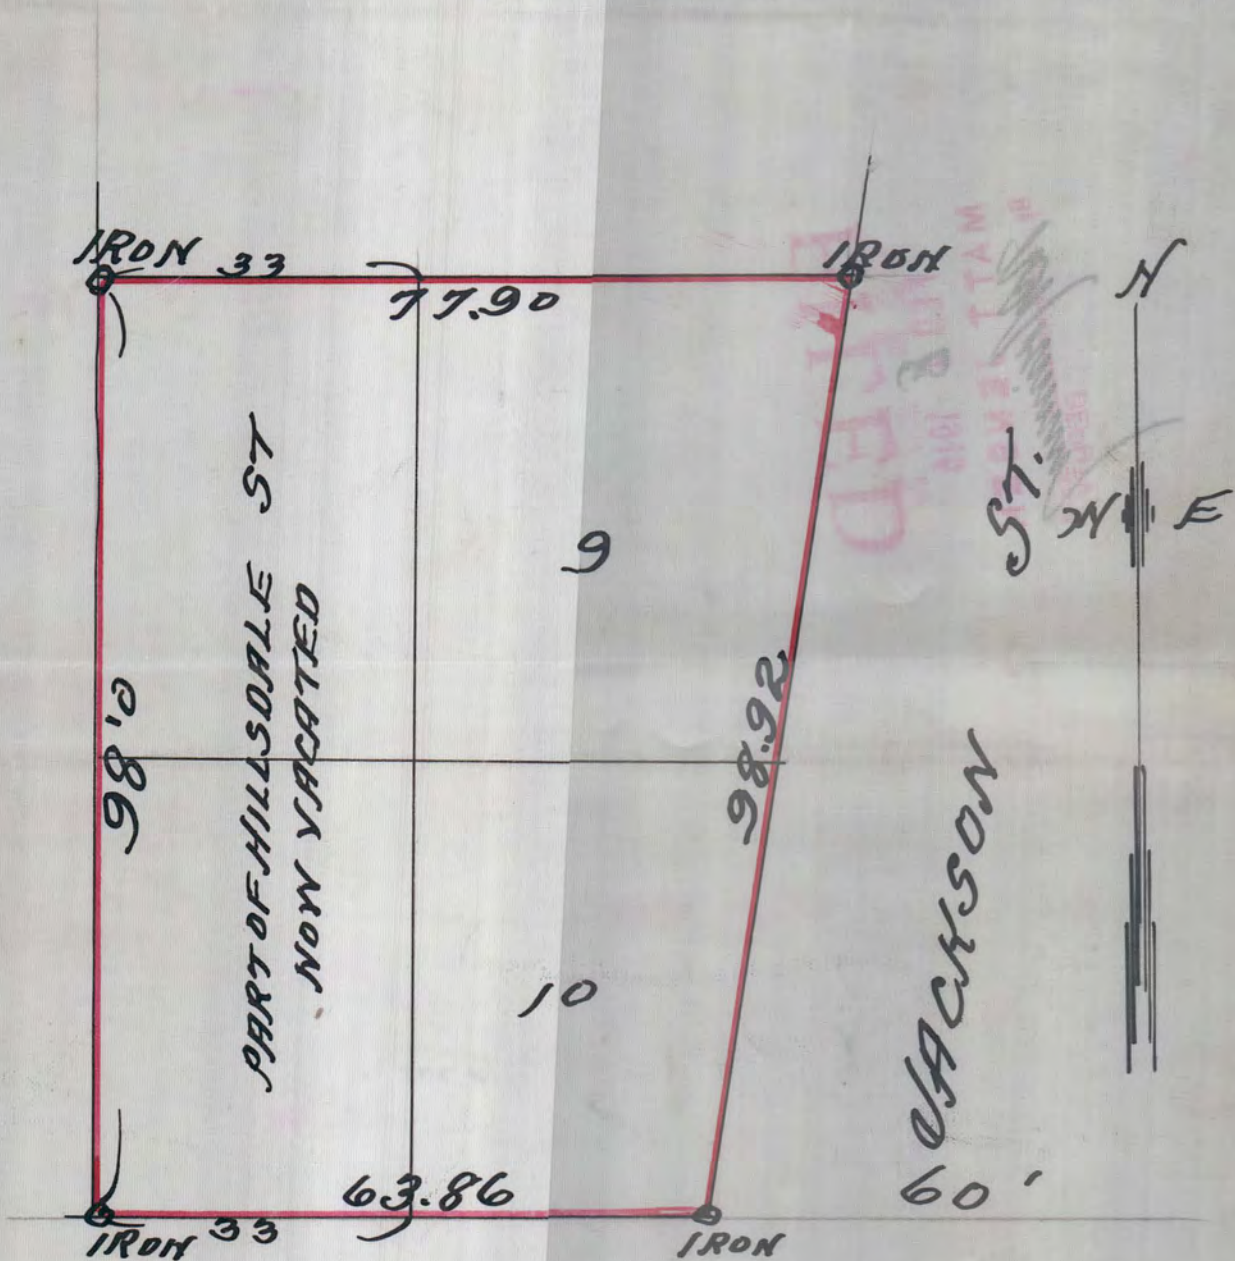

ARCH ST.

1/299

60

1756