


SURVEY OF.

ALL THAT PART OF LOT 4 LEECH'S ADD DESCRIBED AS FOLLOWS TO WIT COMMENCING AT A POINT ON THE N LINE OF GOODRICH AVE 49.50 FT WEST OF THE S.E. COR OF LOT 4 THENCE N. PAR TO THE E LINE OF SAID LOT 4 TO THE SLY LINE OF W. SEVENTH ST THENCE SWLY ALONG THE SLY LINE OF W. SEVENTH ST TO THE N LINE OF GOODRICH AVE THENCE E ALONG THE N LINE OF GOODRICH AVE TO POINT OF BEGINNING

OCT 21-1914

JENS PEDERSEN SURV.
SCALE 10' = 1"

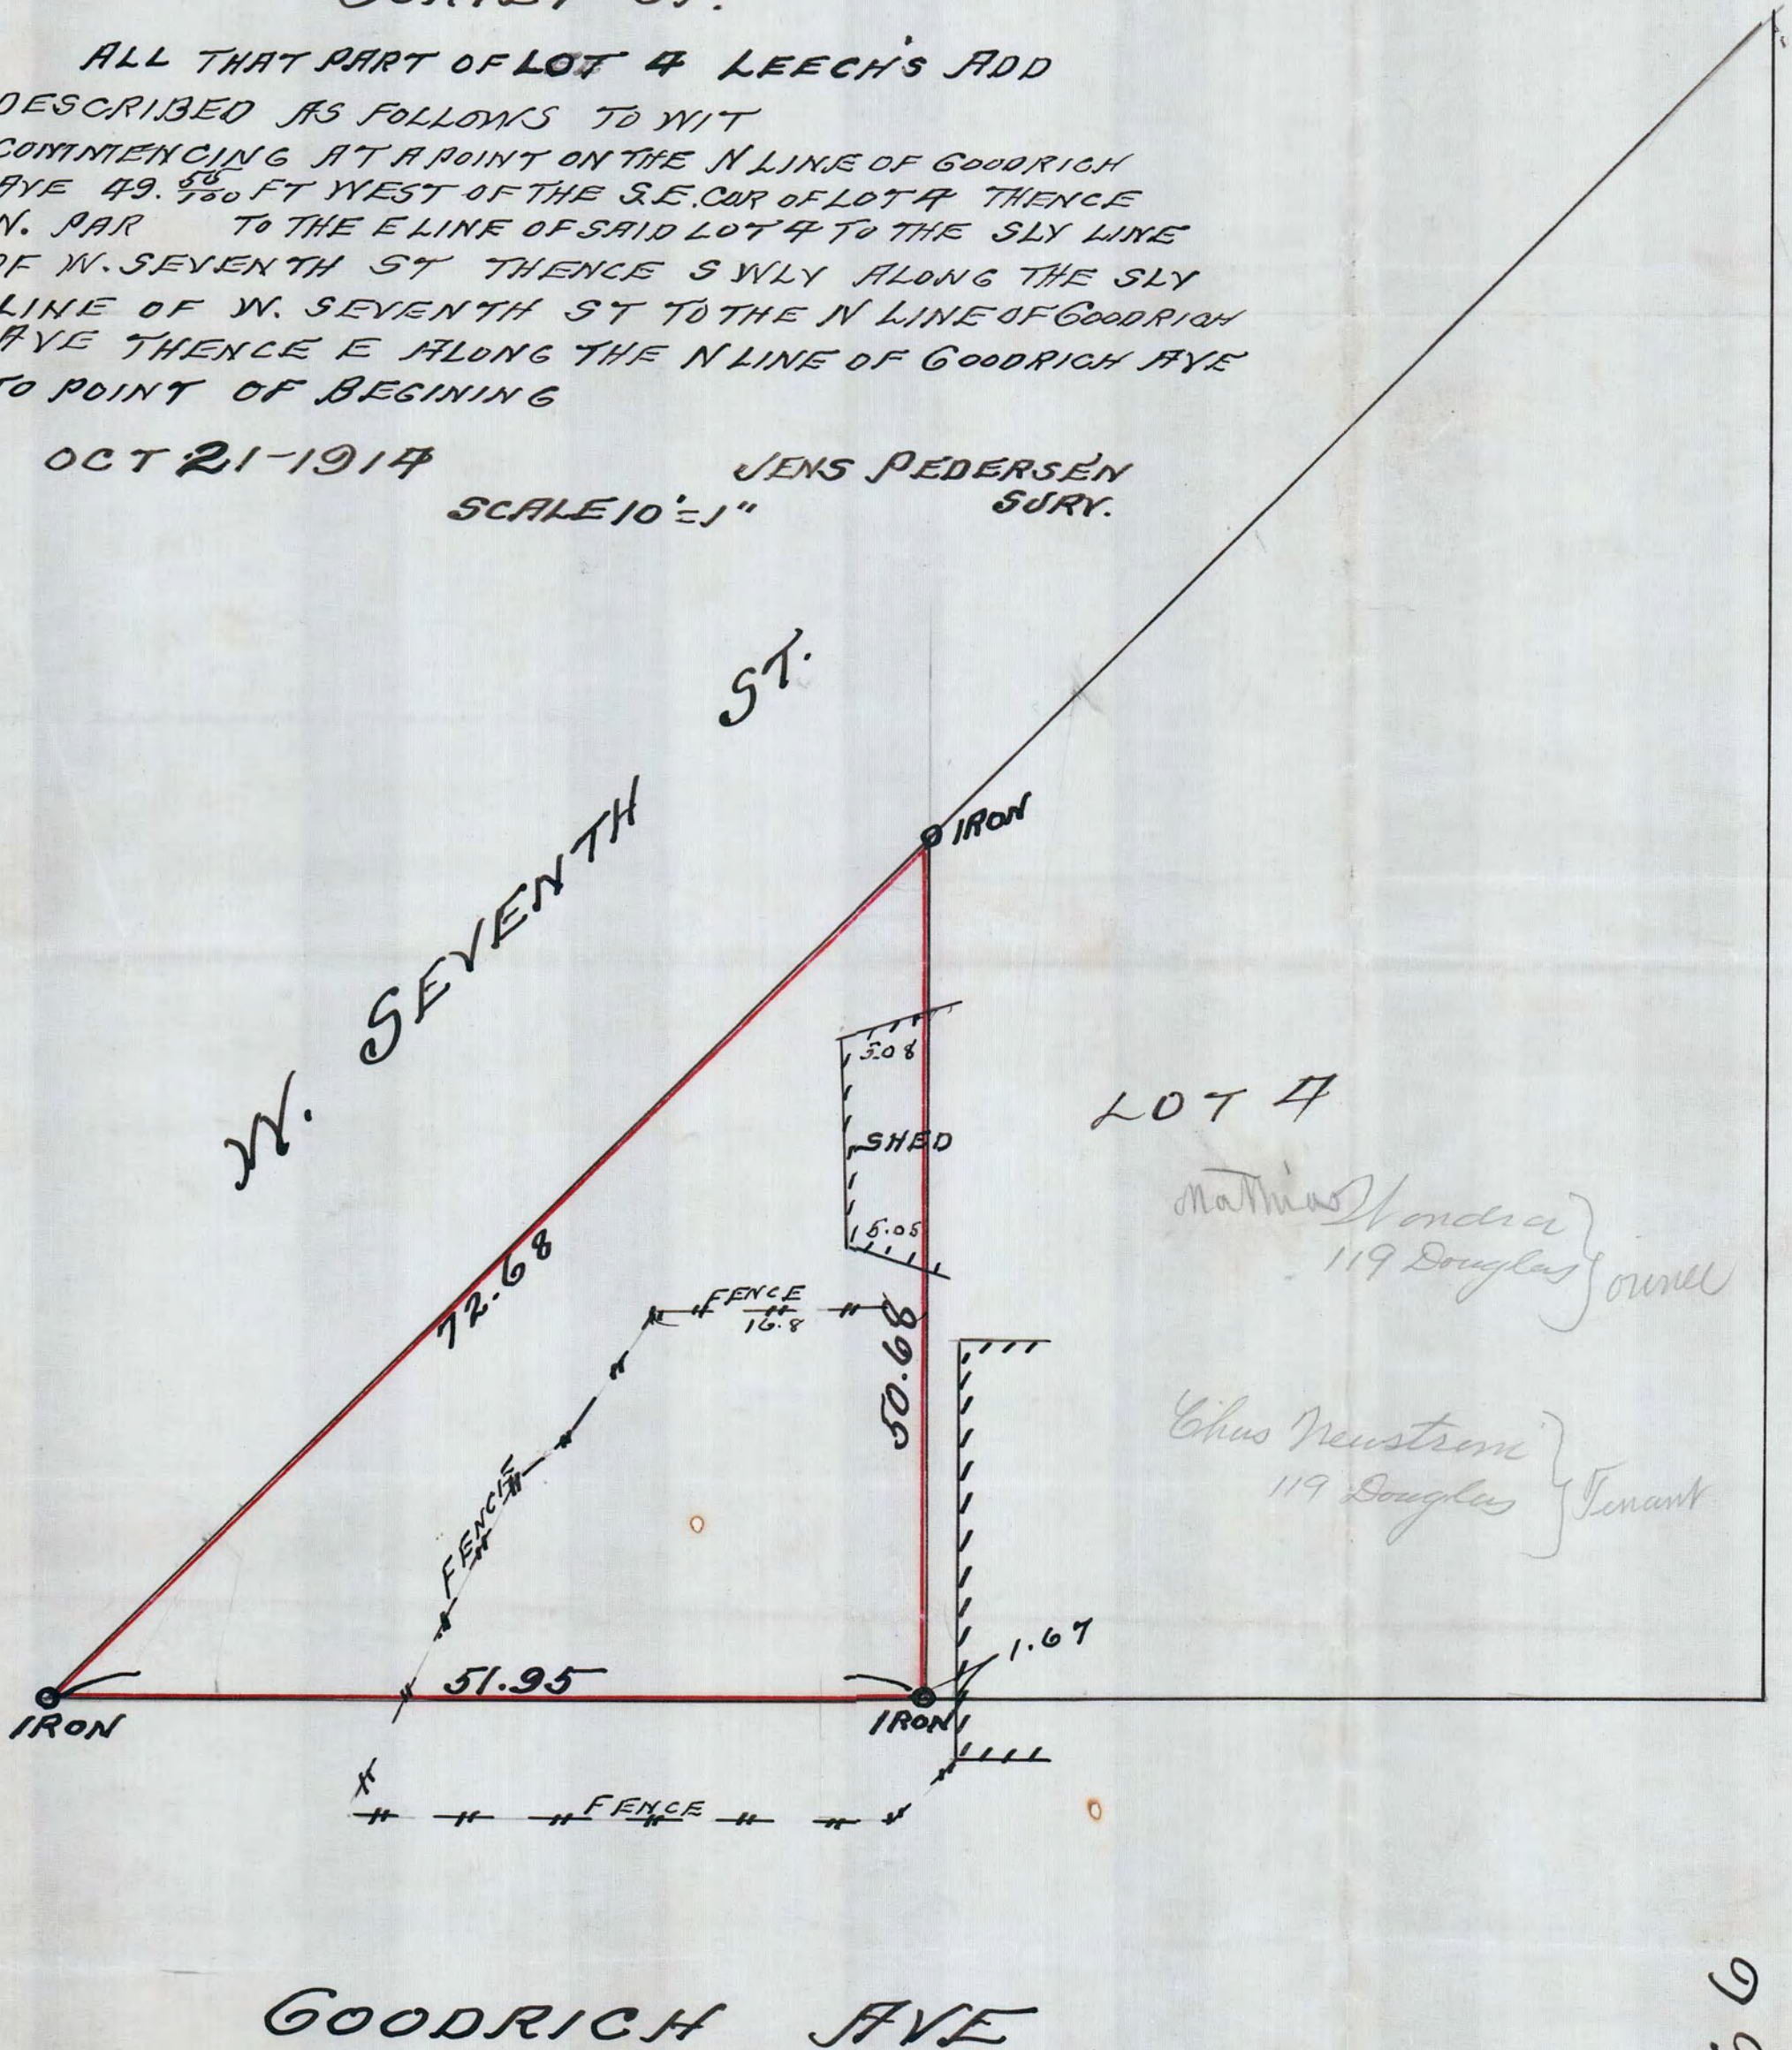

66

#1766