


SYNDICATE No 4  
 SURVEY OF  
 W 20 FT LOT 26 AND E 10 FT LOT 25  
 BLOCK 4  
 MAR 18-1915 JENS PEDERSEN  
 SURY  
 SCALE 20' = 1"

15

ALLEY

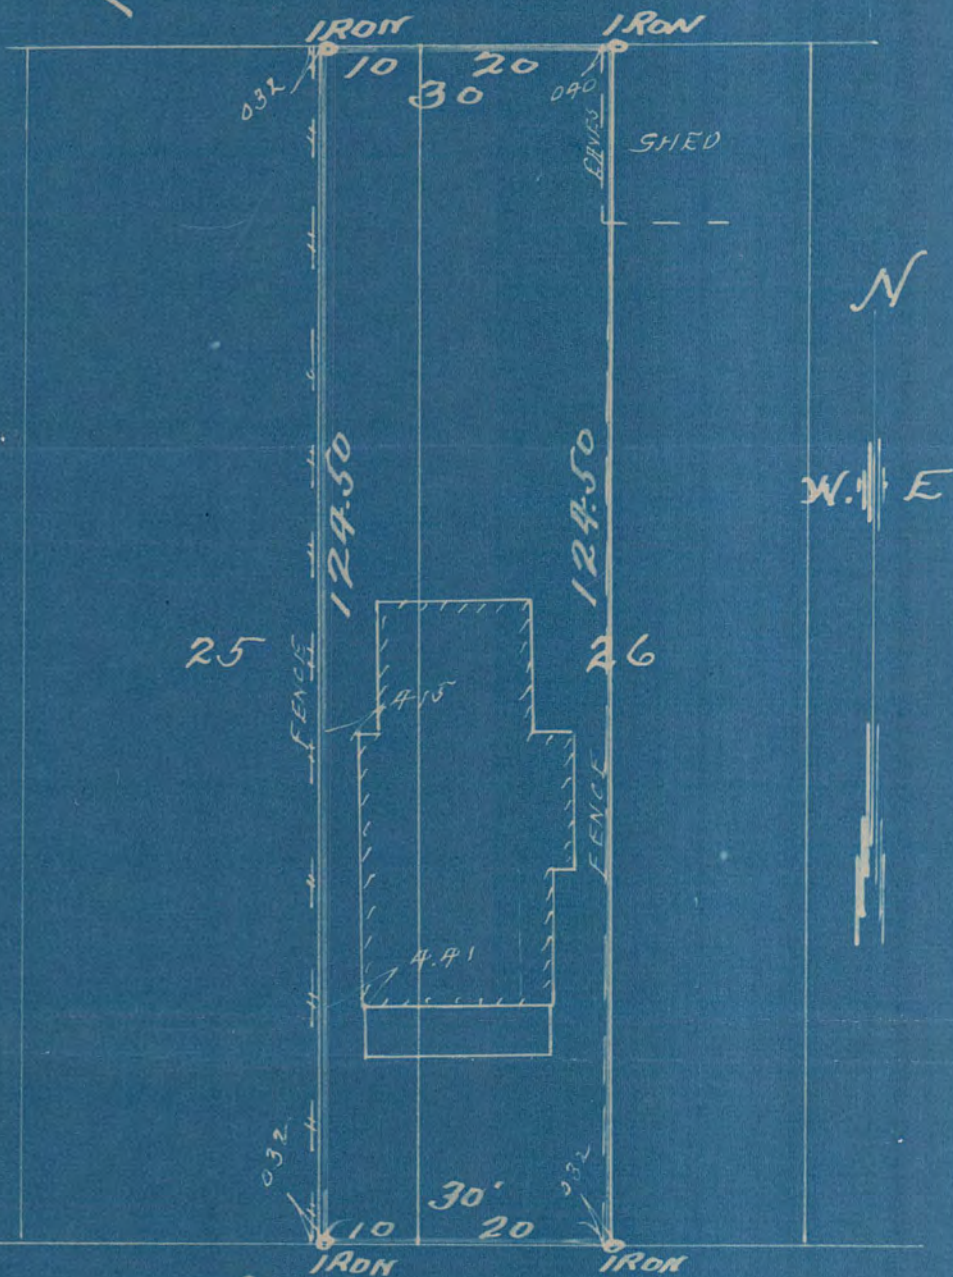

66

VAN BUREN ST

#  
1795