

1800

LAWTONS SUB  
 OF  
 BL 24 BROWN AND JACKSONS ADD  
 SURVEY OF  
 LOT 5  
 MAR 20-1915 JENS PEDERSEN  
 SCALE 10' = 1" SURY.

60

IRON CUTT 40'0 CUT IN WALL

1.07

0.92

3 STORY BRICK.


0.83

0.72

126.82

5

126.83

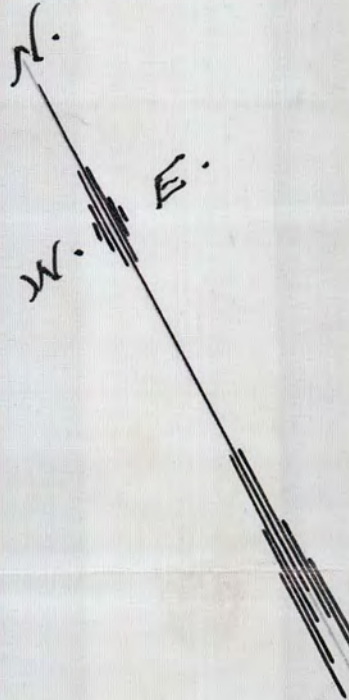

FENCE

FENCE

0.33

0.25

40'0

3 NAILS

3 NAILS

ALLEY.

20

#1800