

MILHAM PARK  
SURVEY OF  
LOTS 14 AND 15  
BLK. 1

JENS PEDERSEN  
SURV.


SCALE 1" = 20'



ALLEY

SNELLING AVE.

ST. ANTHONY AVE.

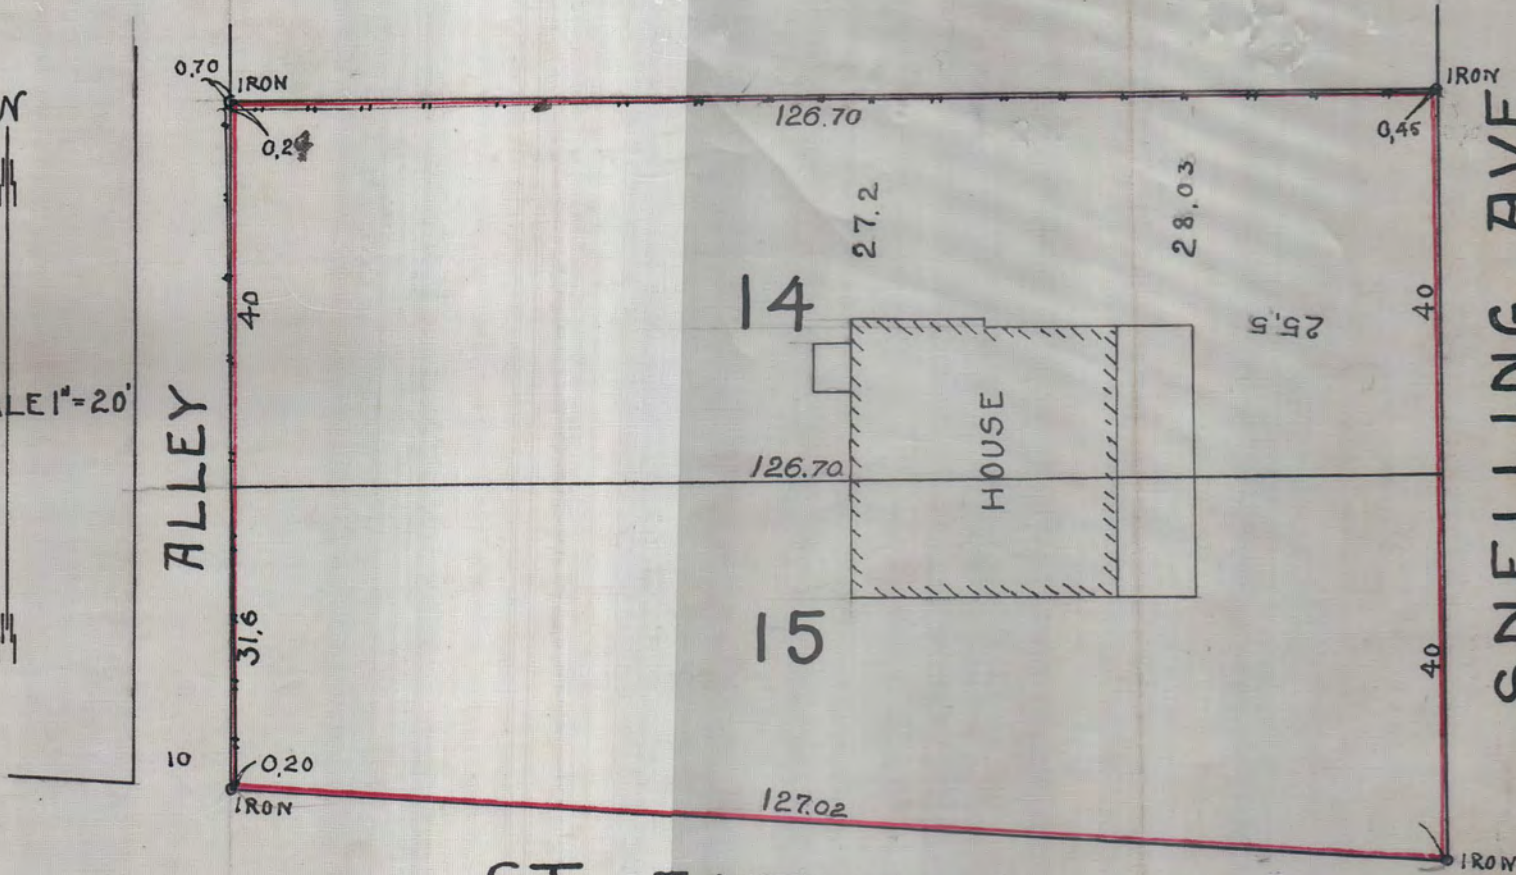

1822

#18