
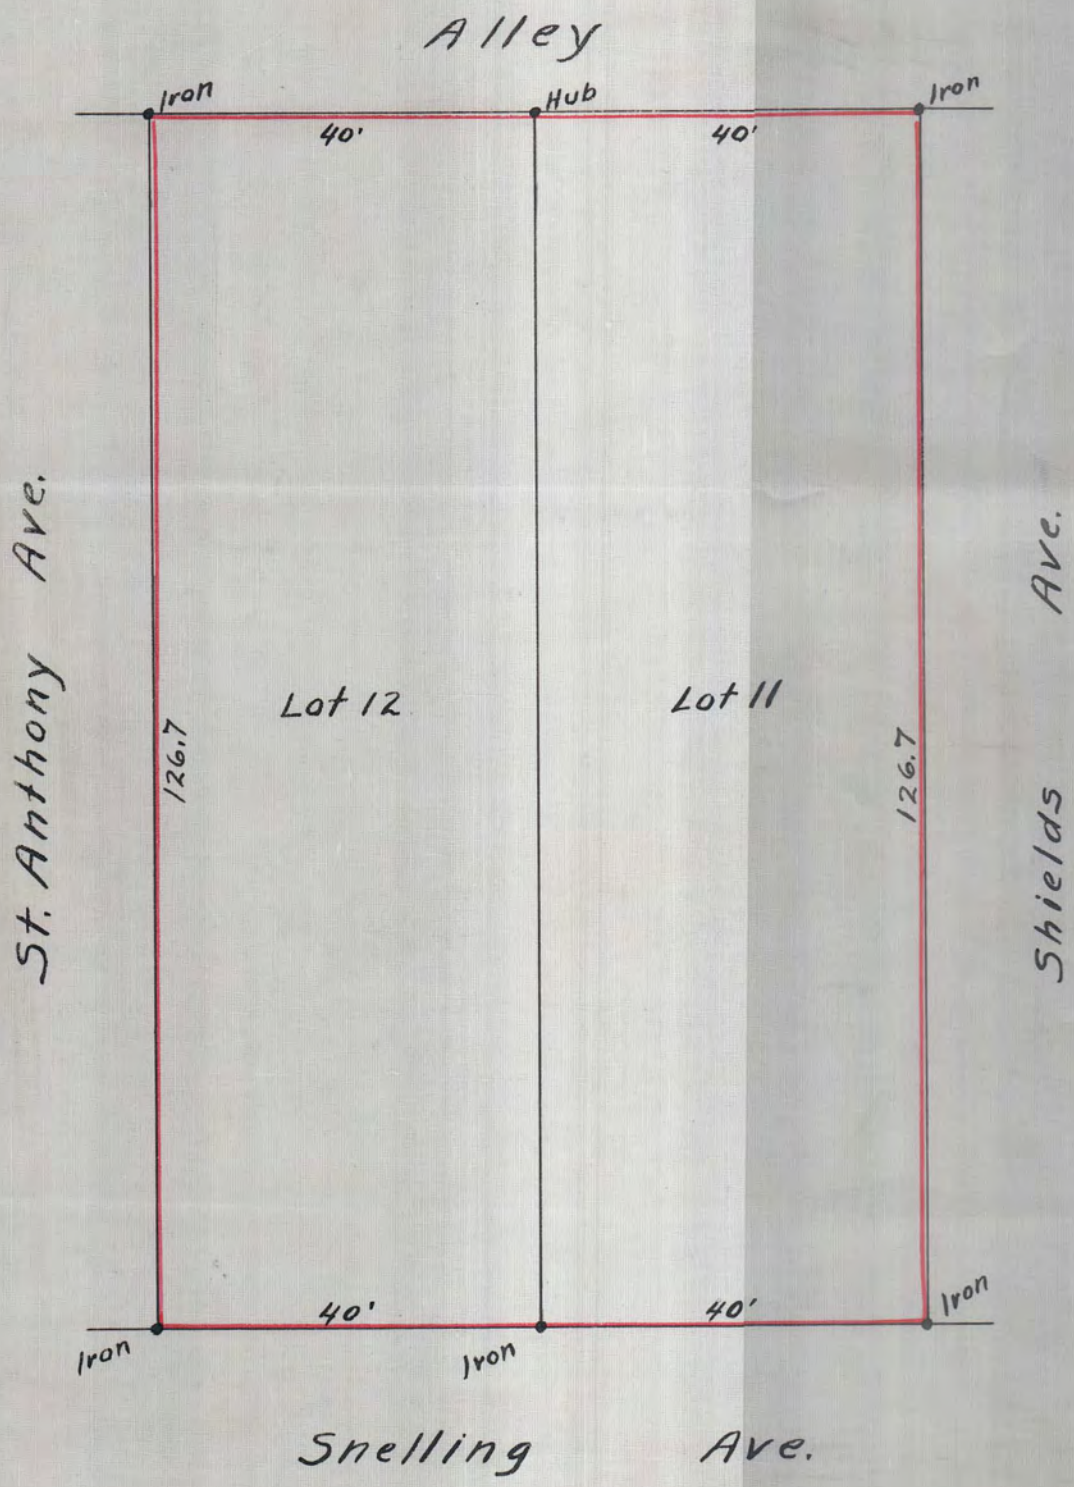


1823

Survey of
Lots 11 & 12 Block 1
Milham Park Add.
April-19-1915 C.F. Scheunemann
Scale-1"=20'

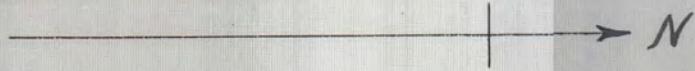

1823