


Survey of
Lot 13 Block 1
Milham Park Add.
April-19-1915 C.F. Scheunemann
Scale-1"=20'

1824

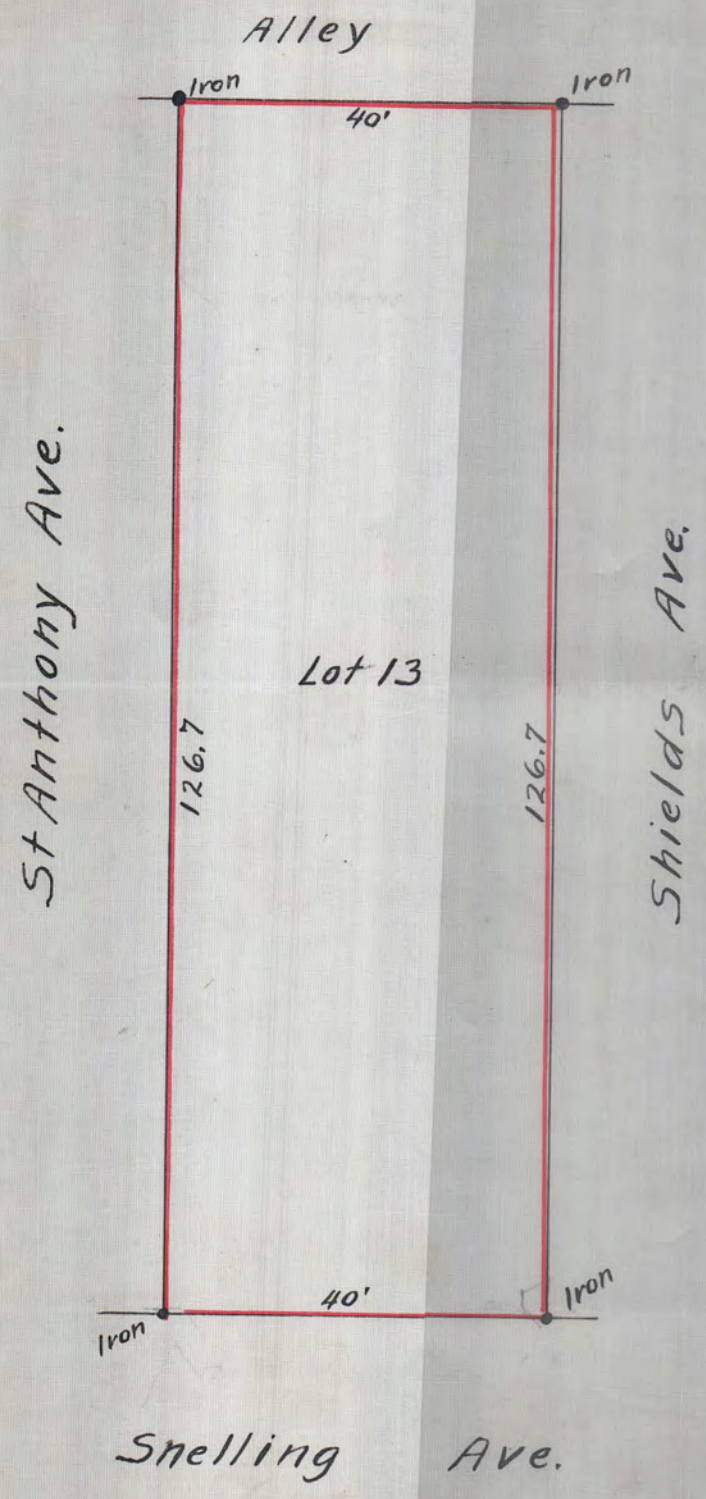

#1824