

LOT 1 BLOCK 9.

# OLIVERS ADD.


SCALE 20 FT PER INCH

JUNE 12 - 1915

E. P. SCHAFER.  
SURVEYOR

GEORGE ST.

ORLEANS ST.

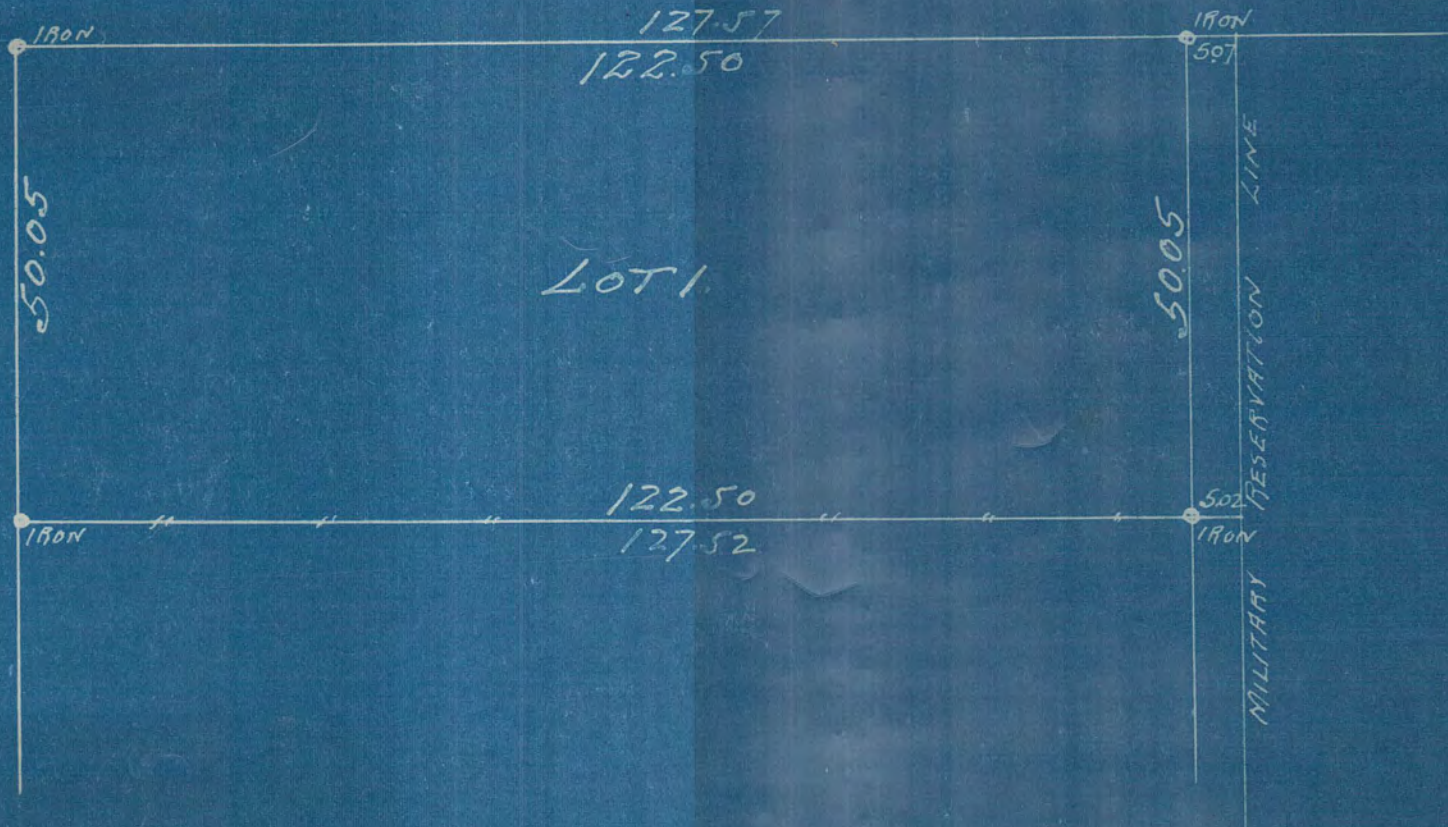

1868