

MURRAY'S ADD.

TO

WHITE BEAR

SURVEY OF

LOT 5.

BLK. 6.


OCT. 15, 1915.

JENS PEDERSEN
SURV.

AVE.

MURRAY

5

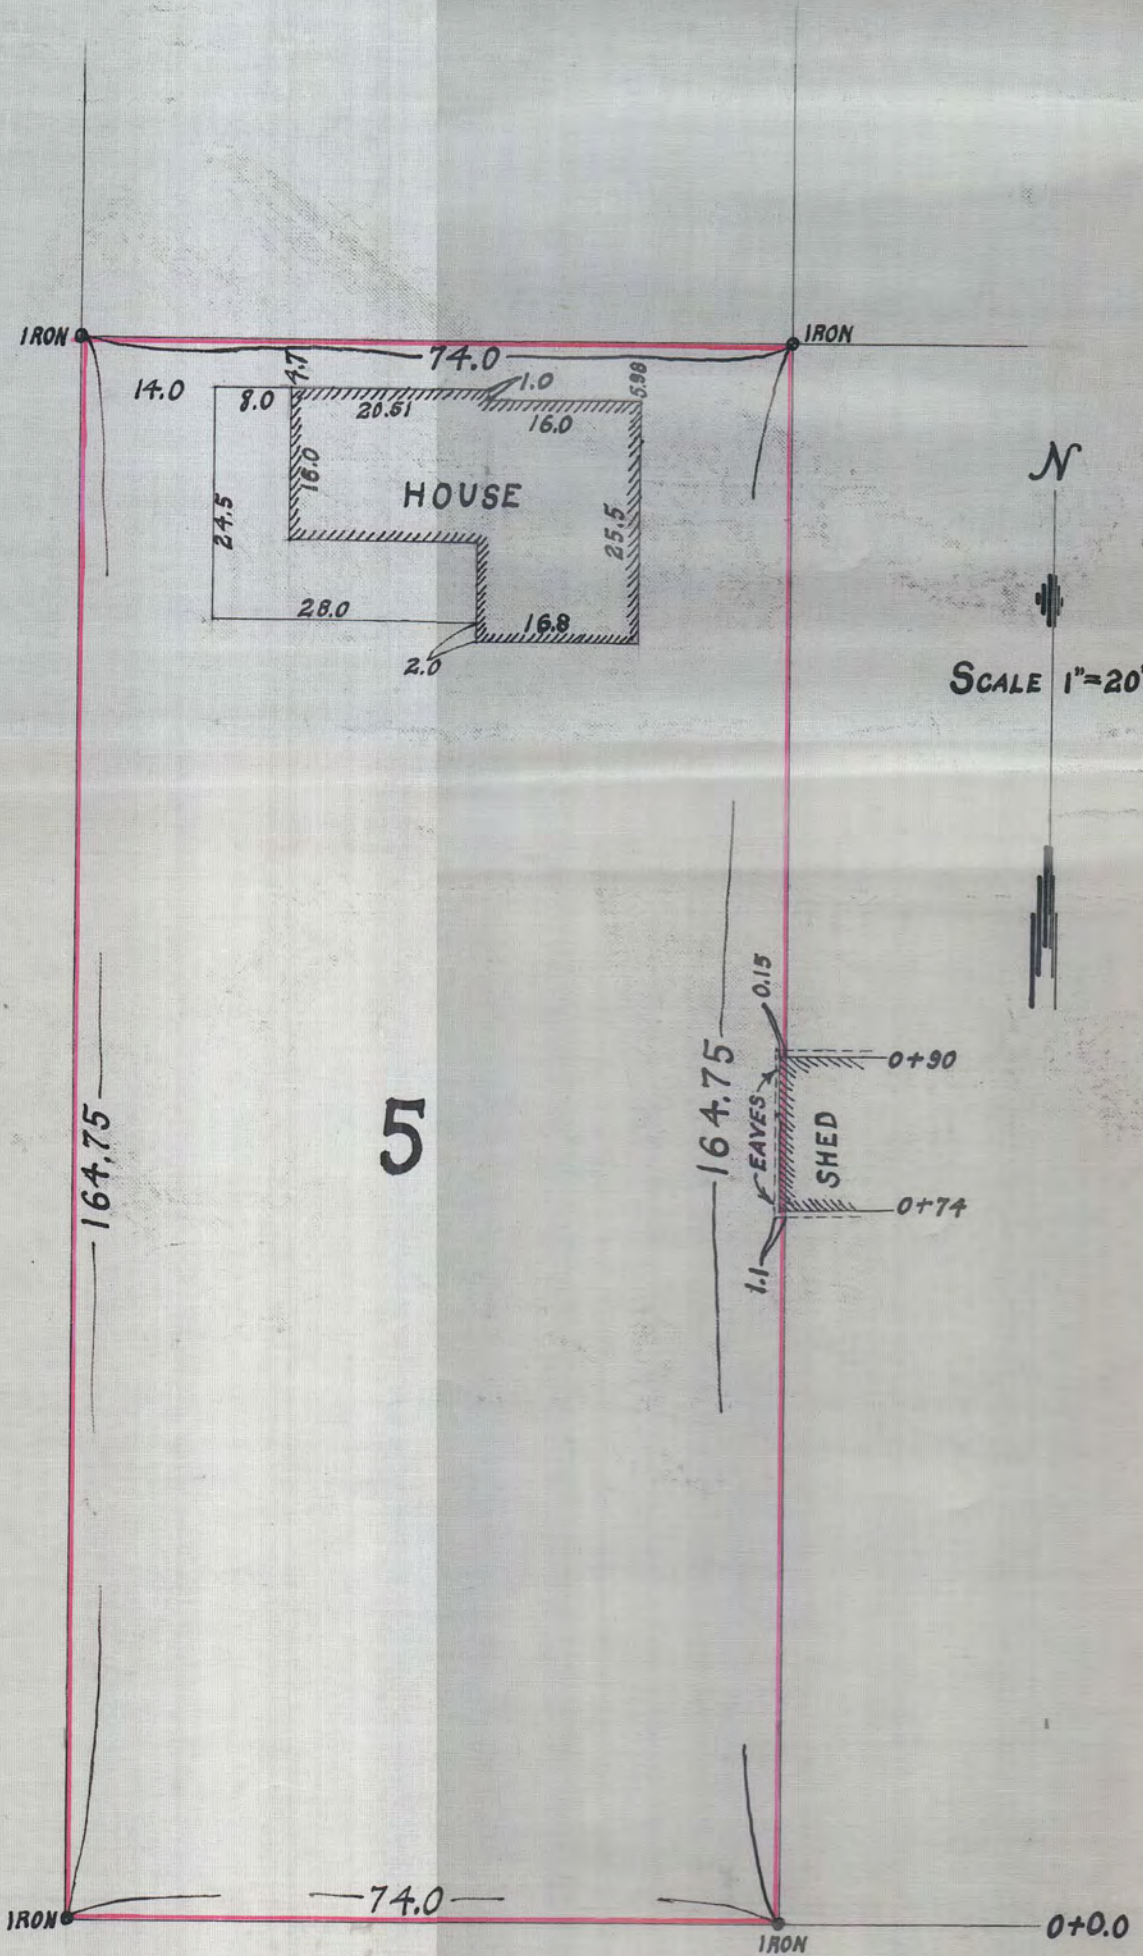

3RD

ST.

1881