

ROBERT'S & RANDALL'S ADD.

SURVEY OF


LOTS 1 AND 2

BLK. 7.

JENS PEDERSEN  
SURV.

ELEVENTH ST.

JACKSON ST.

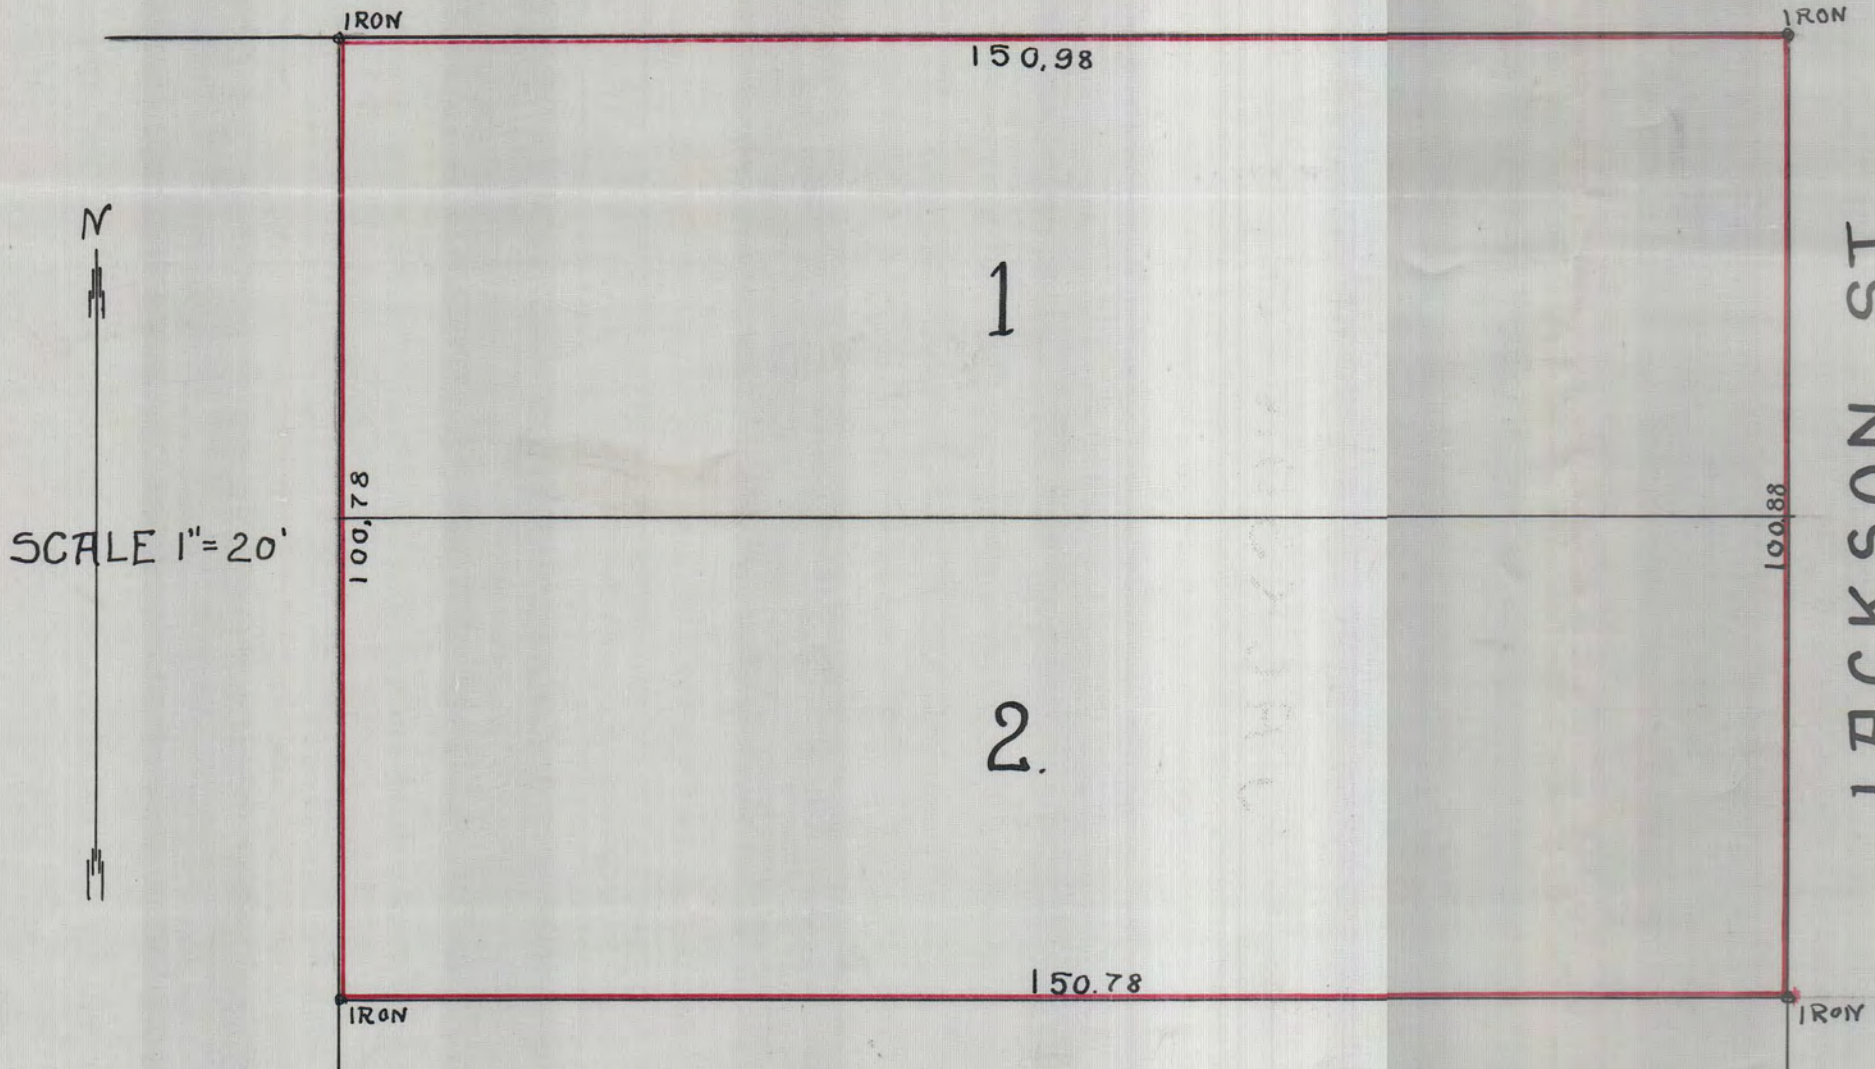

# 1900