


WHITACRE BRISBIN AND MULLIN'S
 SUB
 SURVEY OF
 LOTS 13 AND 14 NLY OF OAKLAND AVE
 JUNE 29-1915 JENS PEDERSEN
 SCALE 10"=1" SURV.

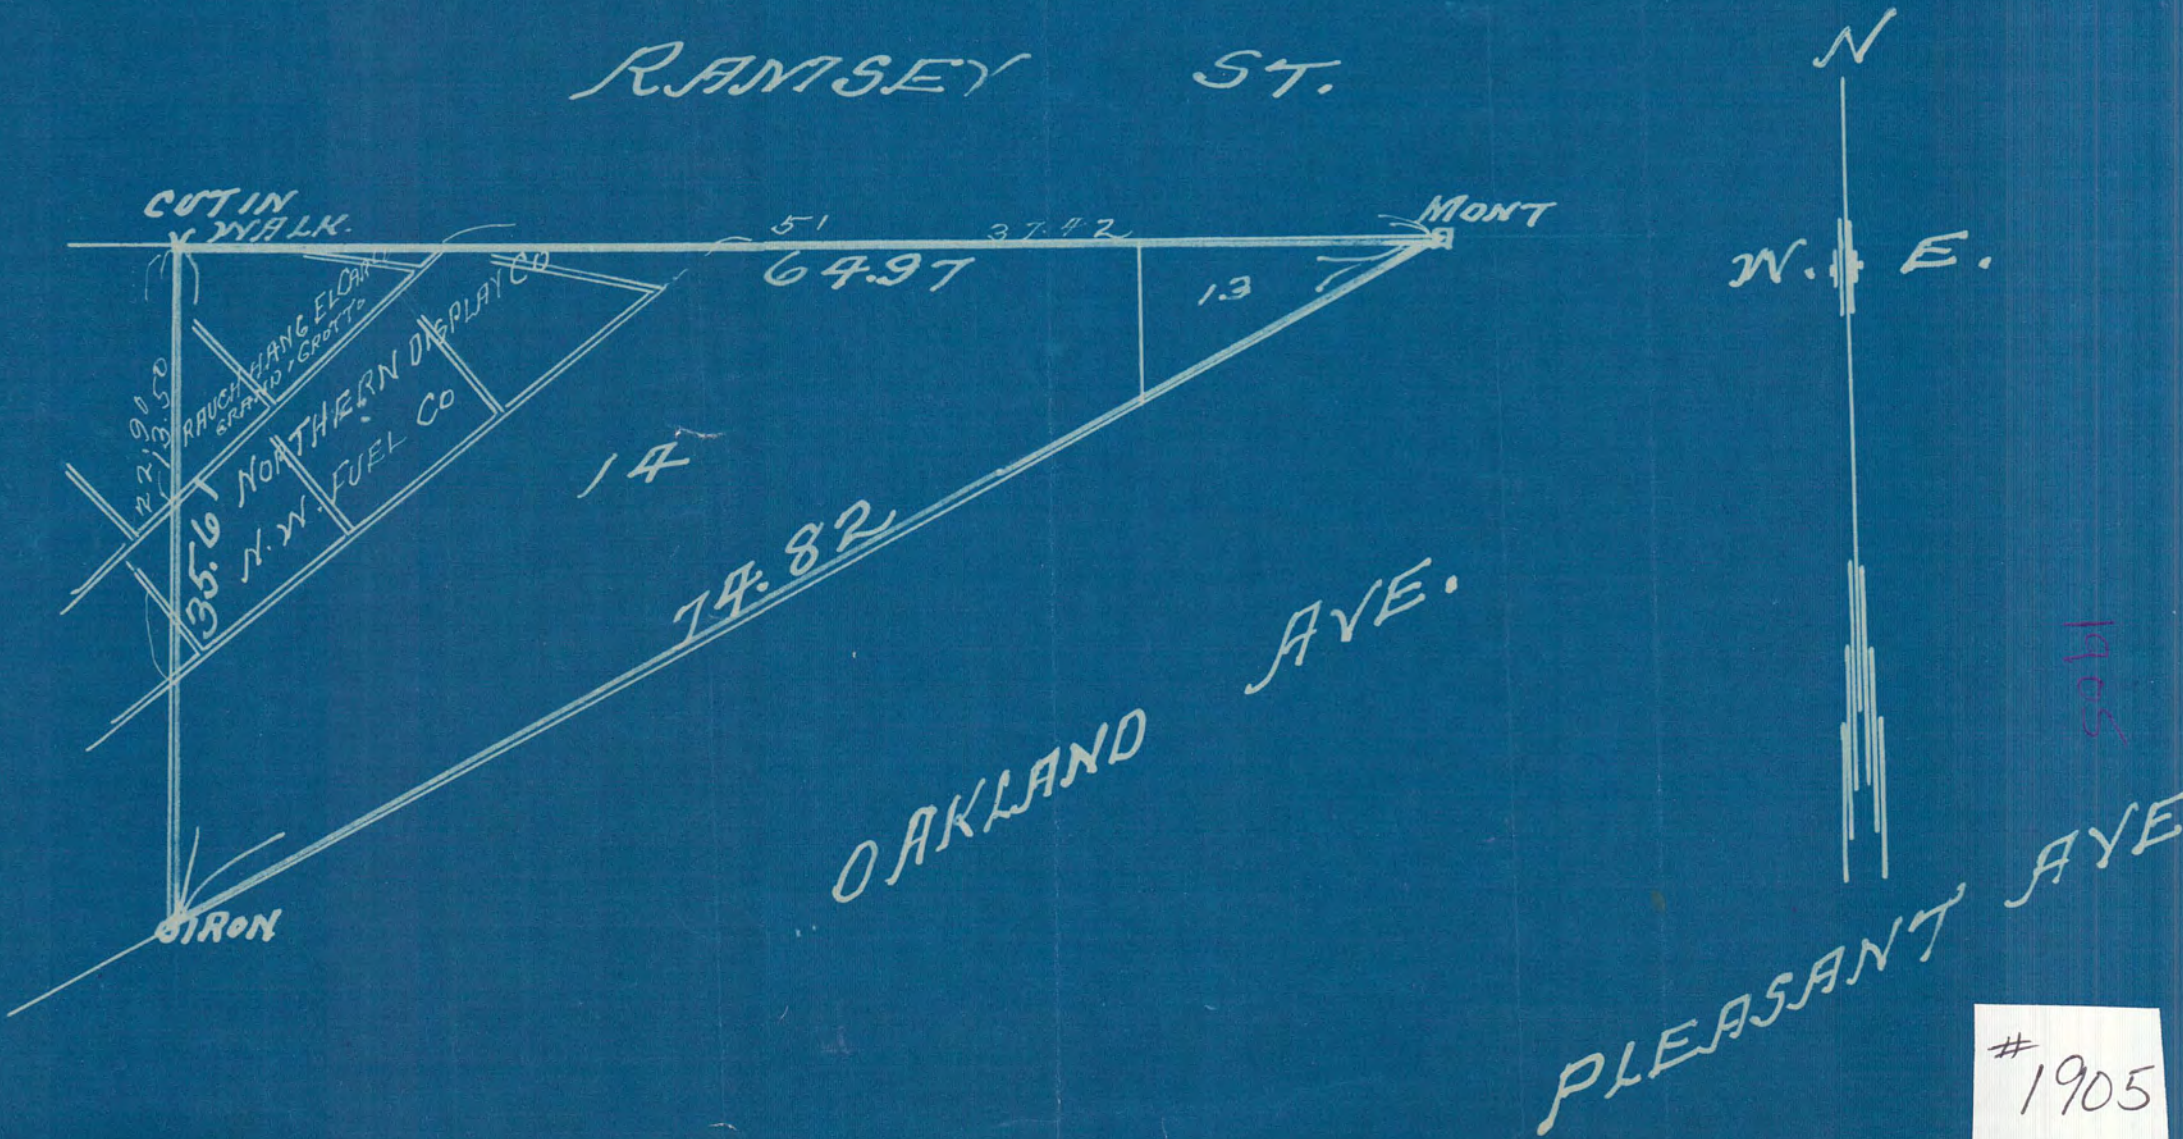

1905