
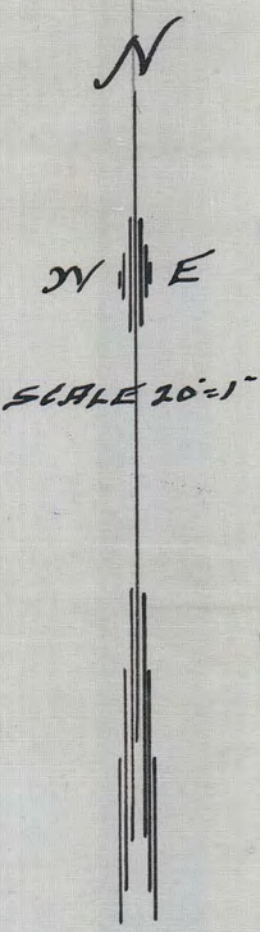


ROBERTSONS ADD  
 TO  
 WEST ST PAUL  
 SURVEY OF  
 LOTS 19 AND 20 BL 158  
 DEC 11-1915 JENS PEDERSEN  
 SURV.

ST.

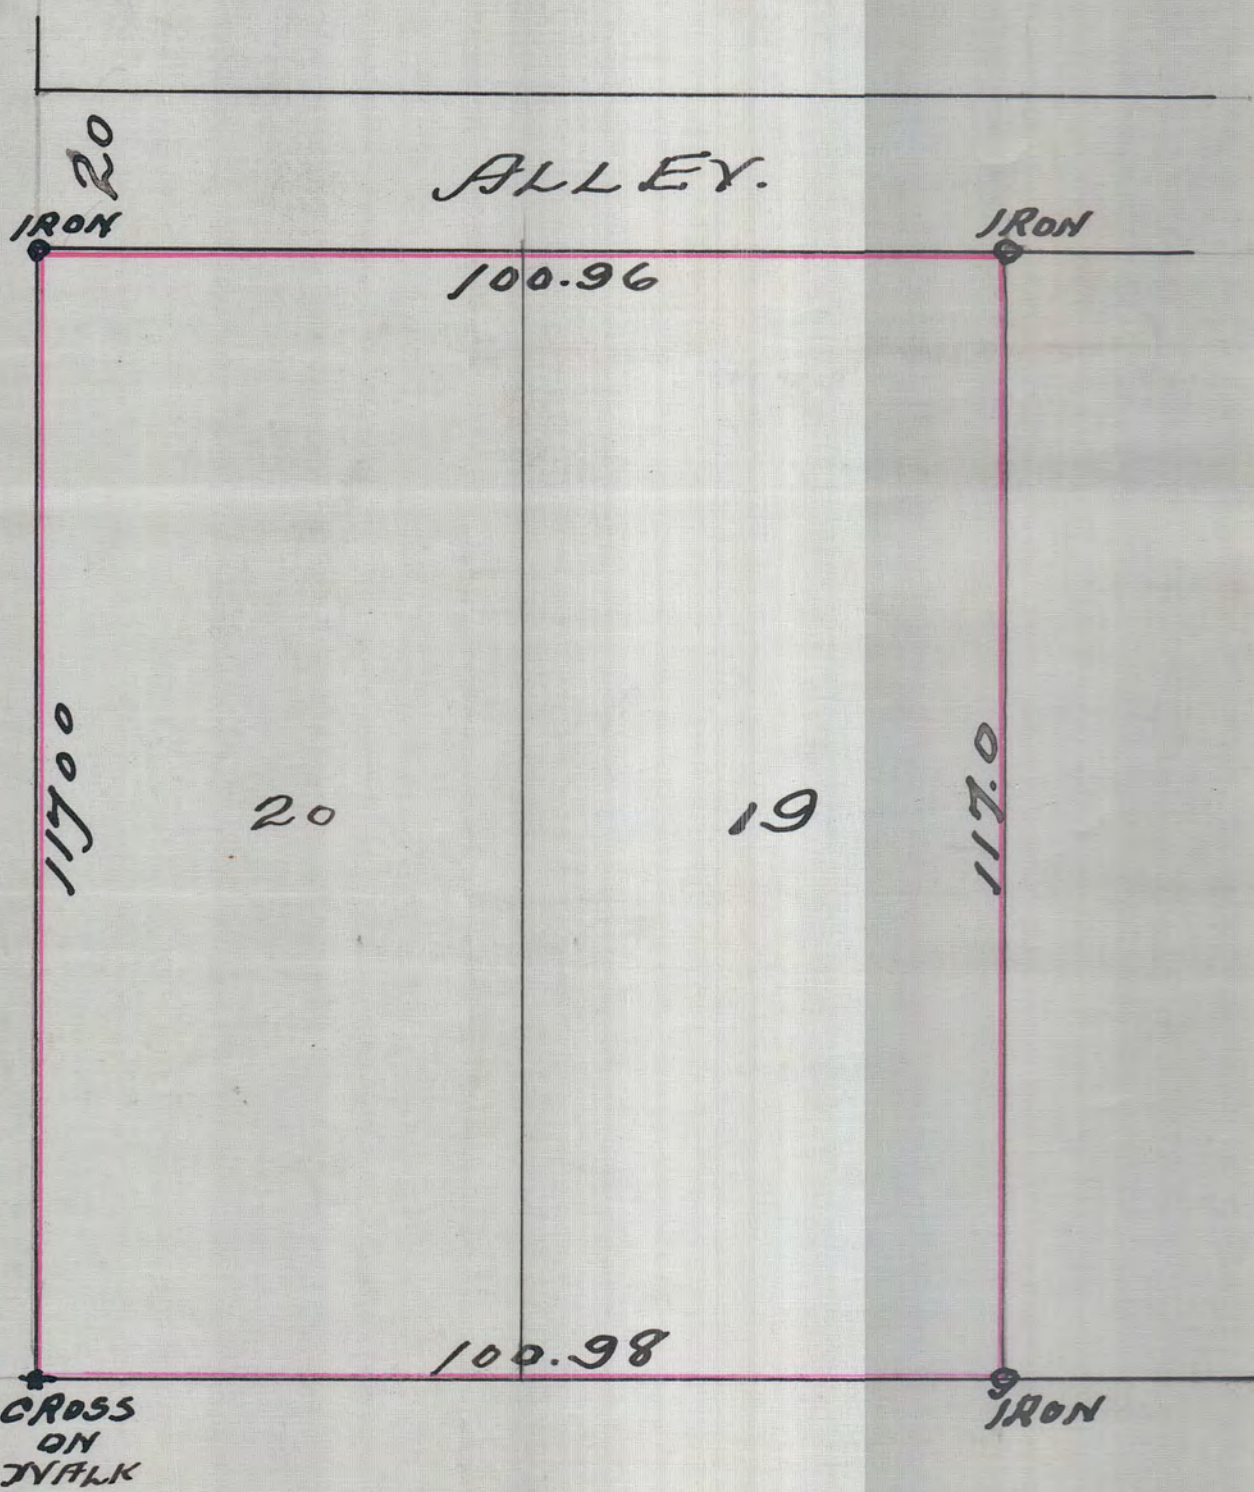

80

ISABEL

ST.

#1936