

GILLETTE'S ADD. TO WOODLAWN PARK
SURVEY OF


LOT 1.
FEB., 5, 1916.

BLK. 2.
JENS PEDERSEN
SURV.

VAN BUREN

ST.

WHEELER
AVE.

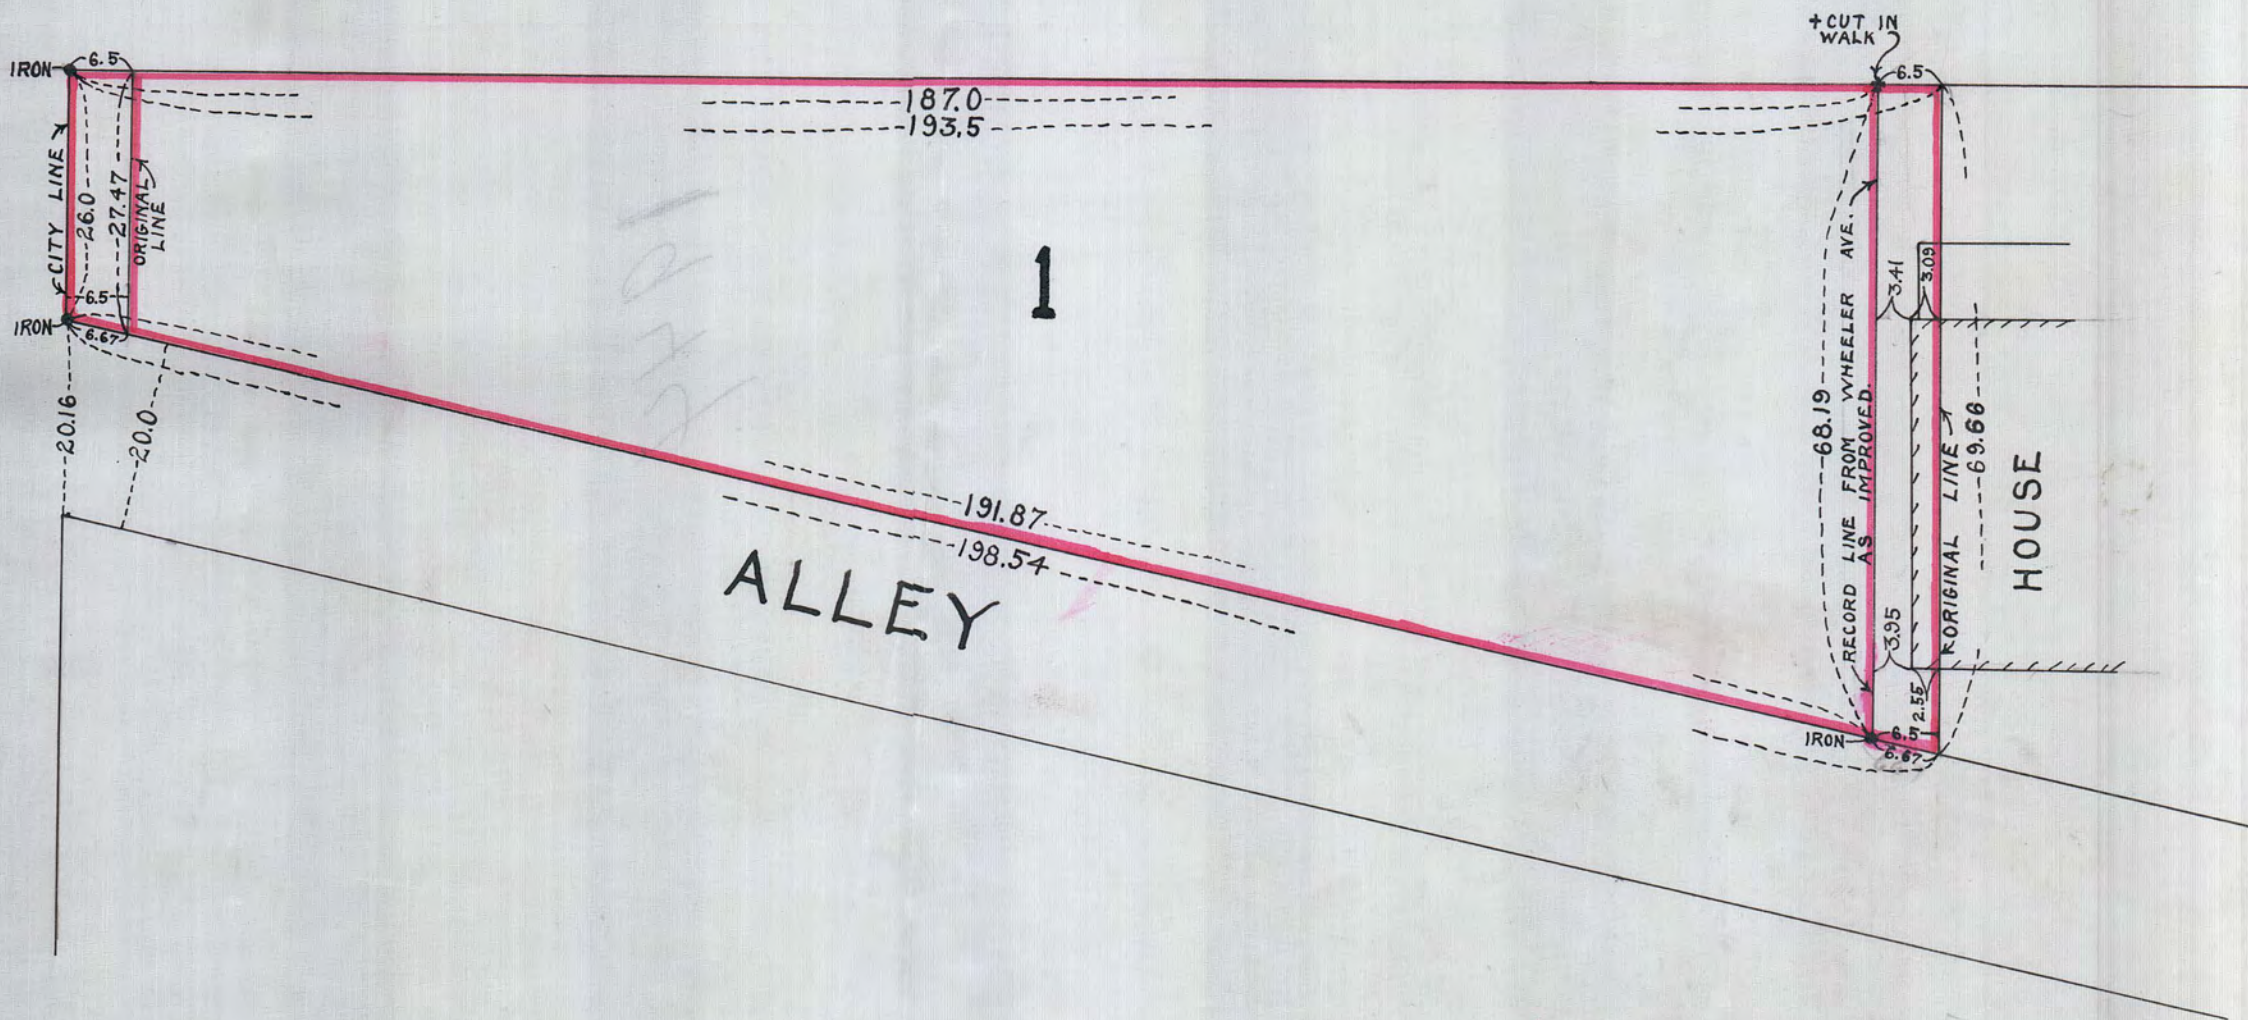

1944