

S-EASTERLY 1/2 LOTS 1 & 2 LOT 3 BLOCK 32


RICE & IRVINES ADD.

SCALE 20 FT PER INCH.

FEB 26-1916

E. R. SCHAFER,
SURVEYOR.

EXCHANGE ST.

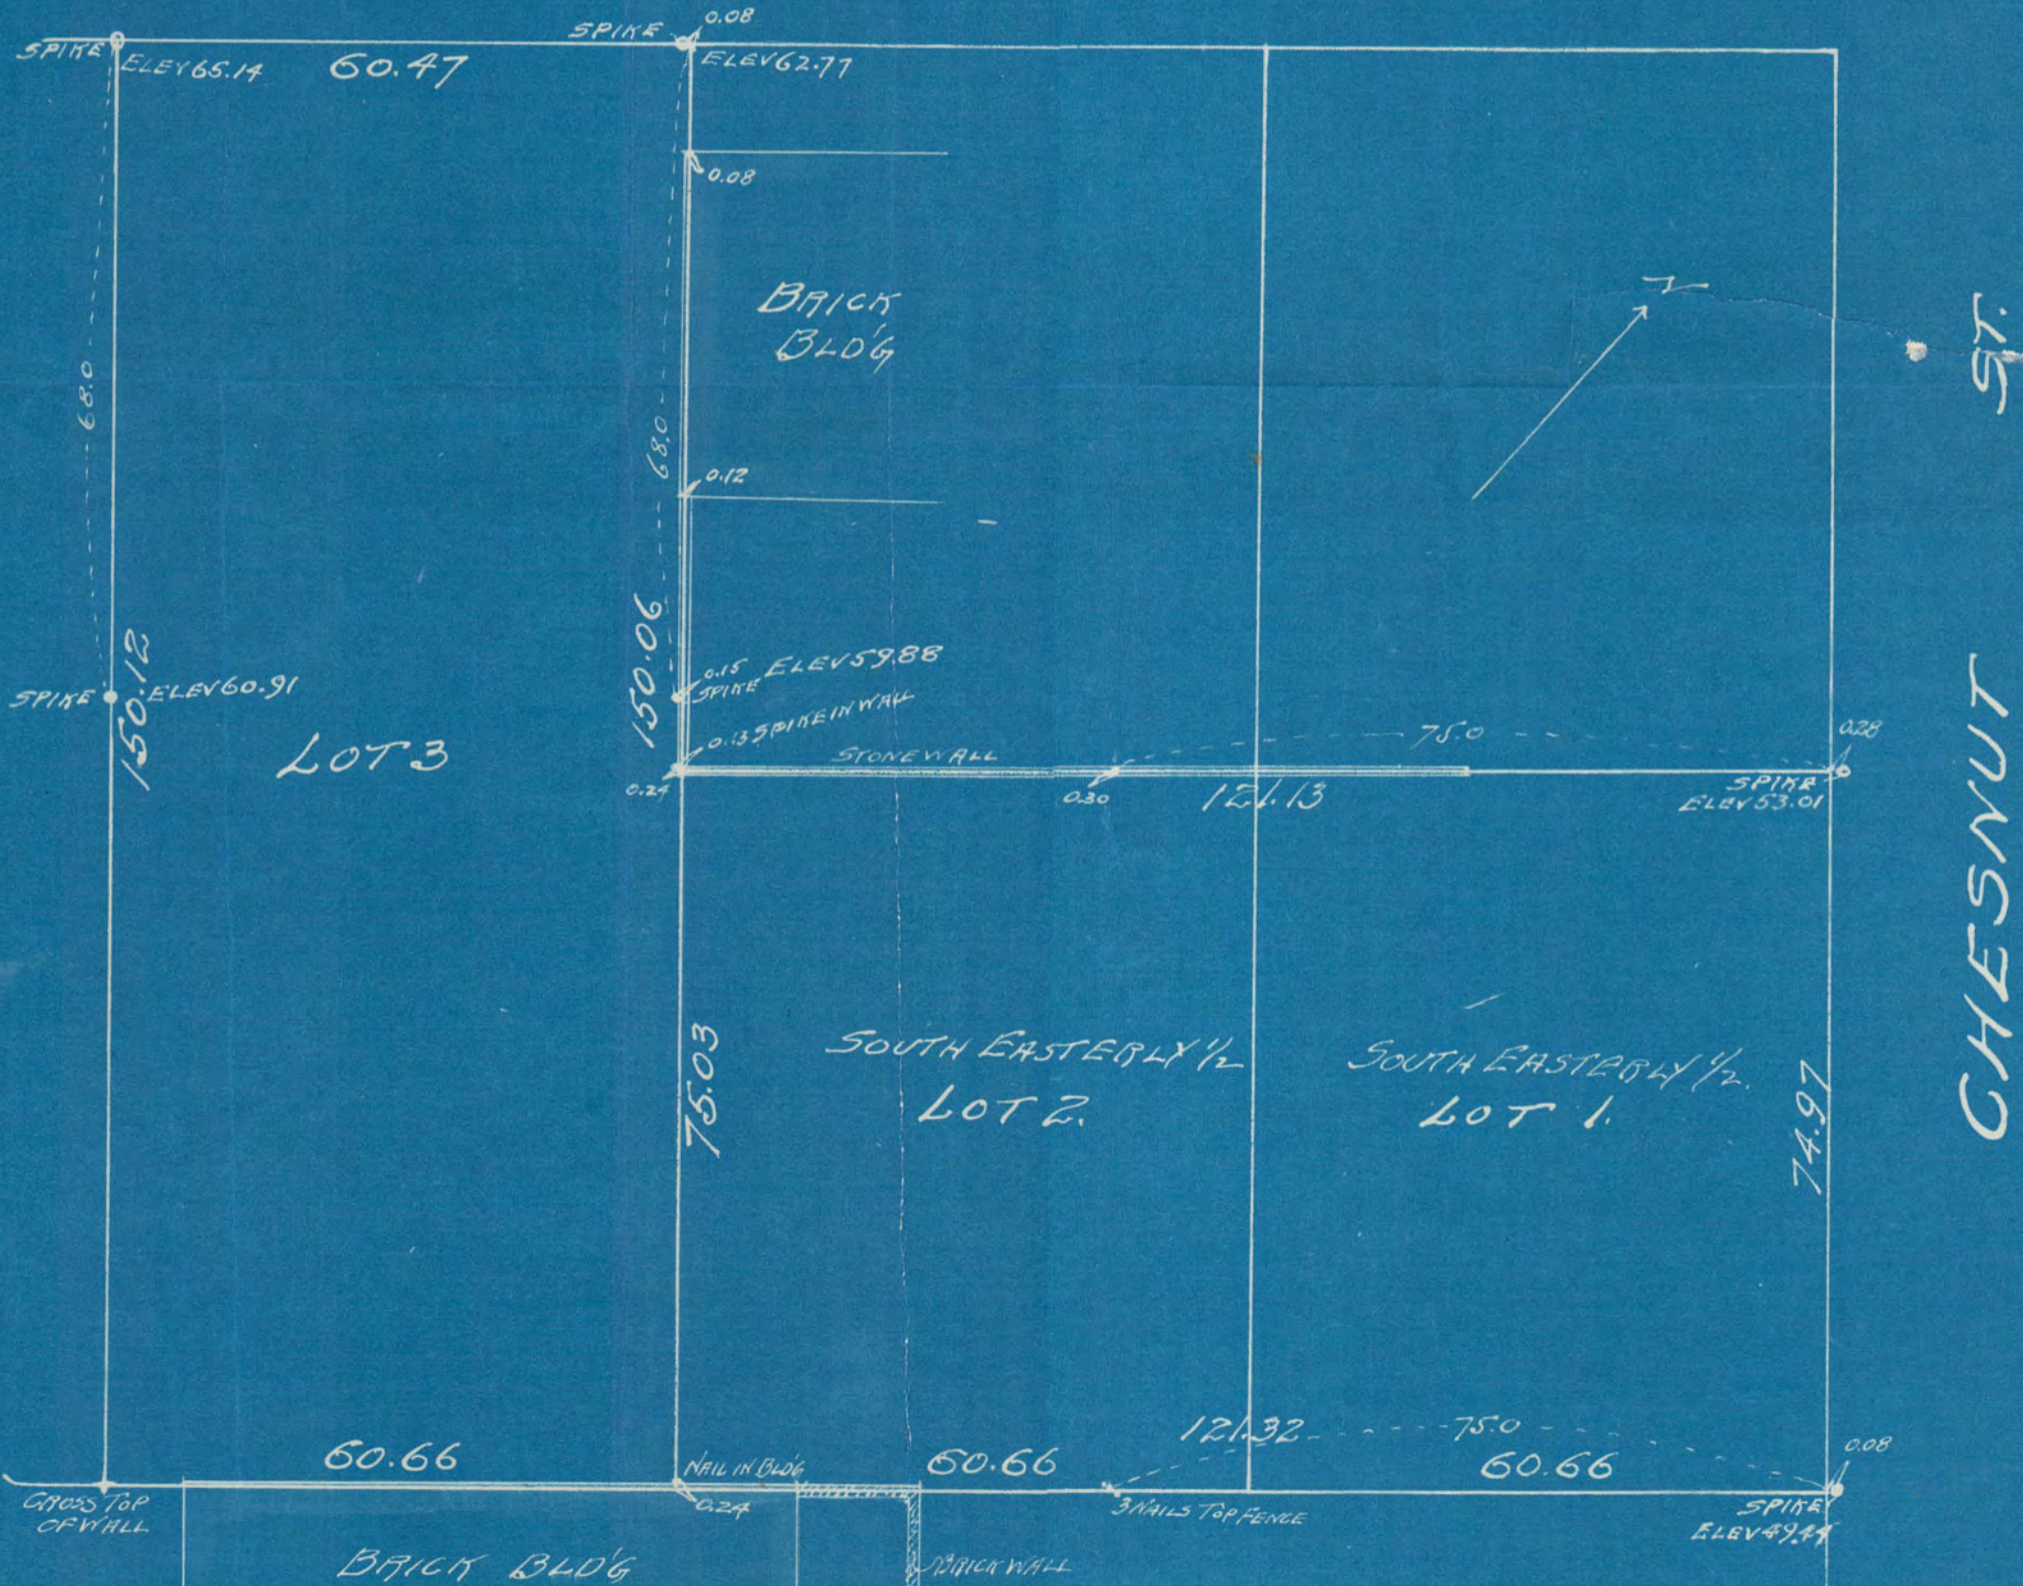

1962

1962