


SURVEY OF THE EAST 65 FT. LOT 6 BLOCK 1 COLLEGE PARK
TAYLORS DIVISION.

MARCH - 1916

Scale 1" = 10'

D. W. T. Survey
Civil Engt.

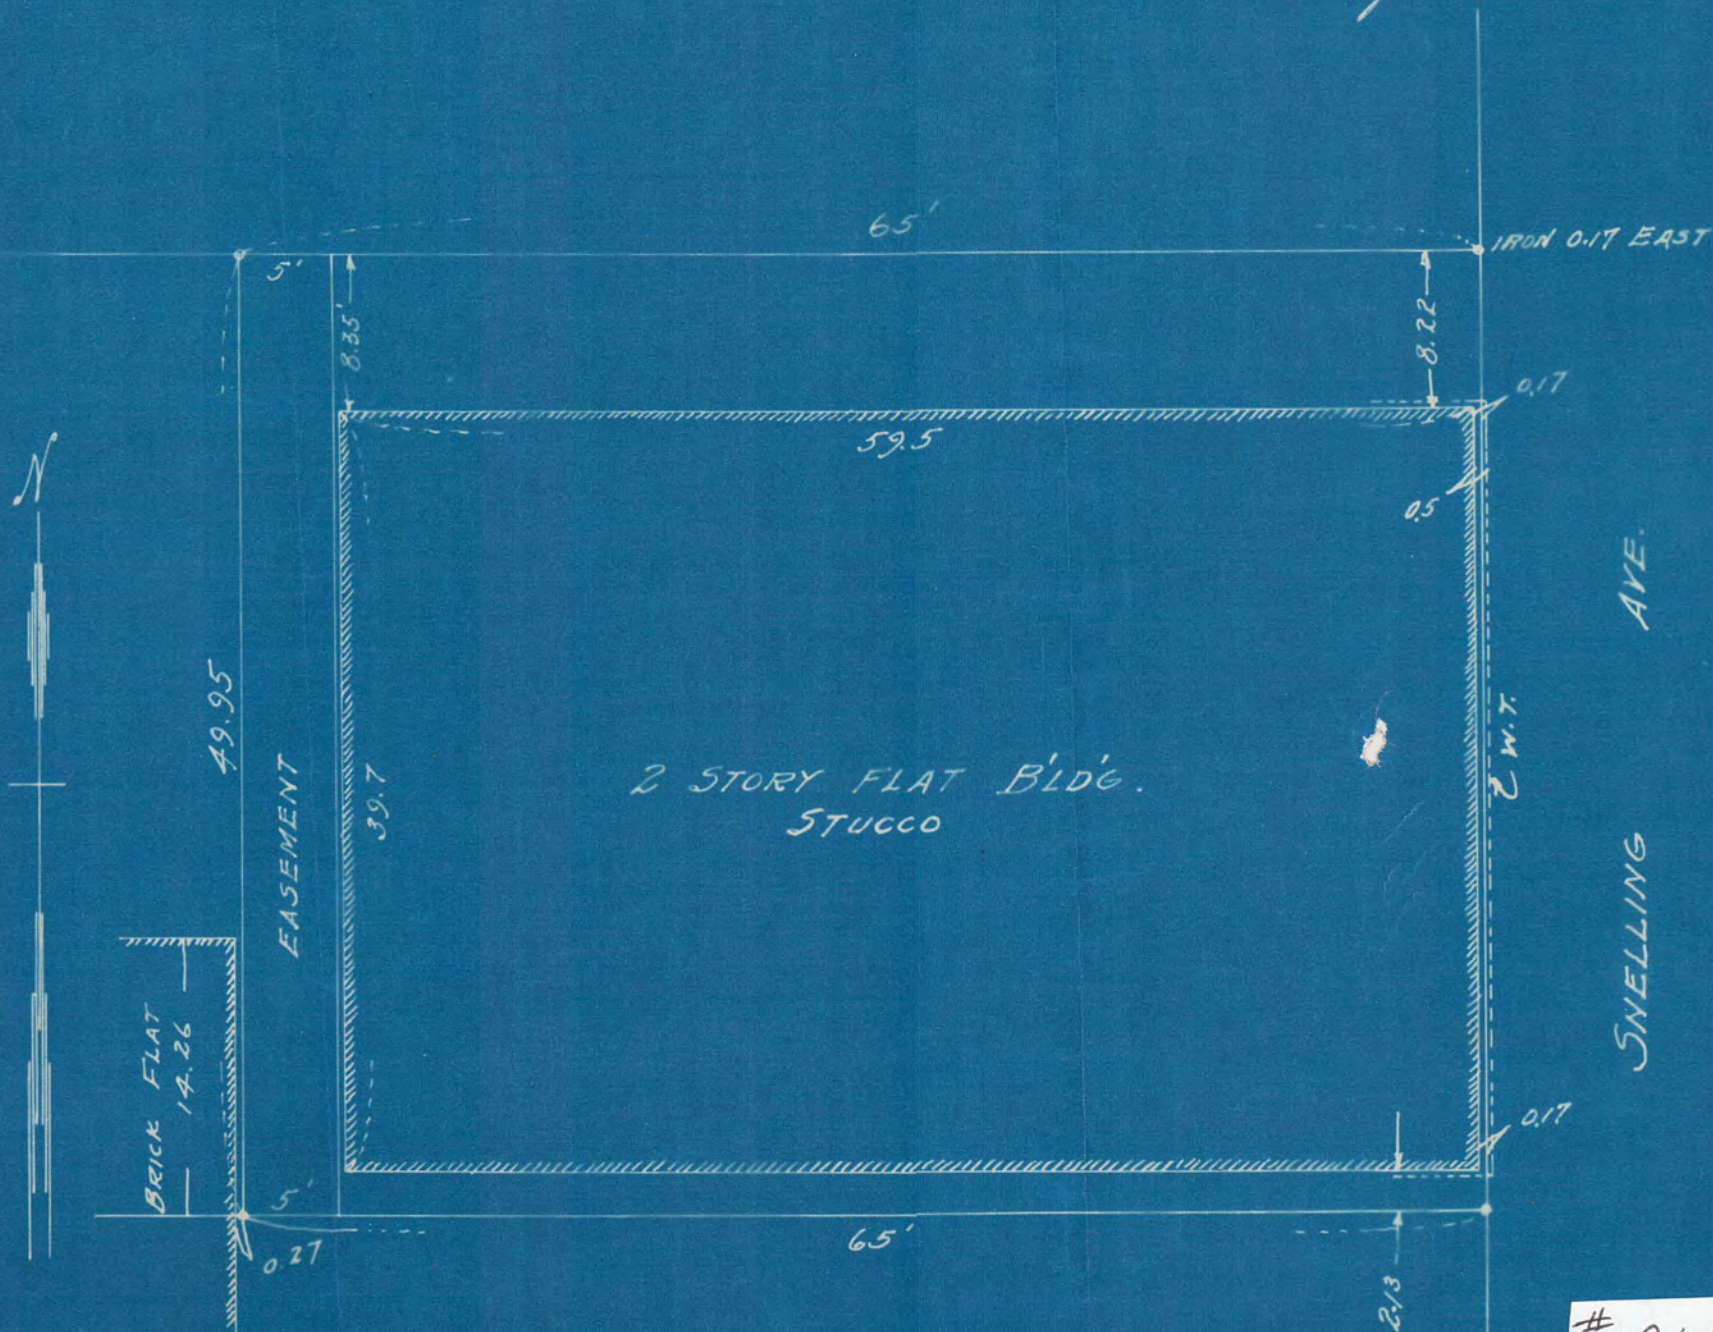

1963

1963

ABSTRACT OF TITLE

Prepared by The St. Paul Abstract Company

No. 1

To East 60 feet of lot 7 and East 65 feet of lot 6 block 1,
College Place Taylors Division.

State of Minnesota }
County of Ramsey

The St. Paul Abstract Company does hereby certify that the following exhibit, consisting of 9 sheets, from 1 to 9 inclusive (each of which bears its Corporate Seal), and 60 entries from 1 to 60 inclusive, is a true and complete Abstract of Title to the real estate described in No. 1 hereof, as shown by the records in the office of the Register of Deeds in and for said County and State, up to this 21st. day of October 1914 at 8 o'clock A. M.

THE ST. PAUL ABSTRACT COMPANY
ABSTRACTERS.

J. J. Suchman
VICE-PRESIDENT

- 2 -

1963

