

SUMMIT VIEW ADD.

SURVEY OF

LOT 20

BLK. 4

APRIL 17, 1916.

JENS PEDERSEN

SURV.


SCALE 20'-1"

1967

Exhibit A

20

ALLEY

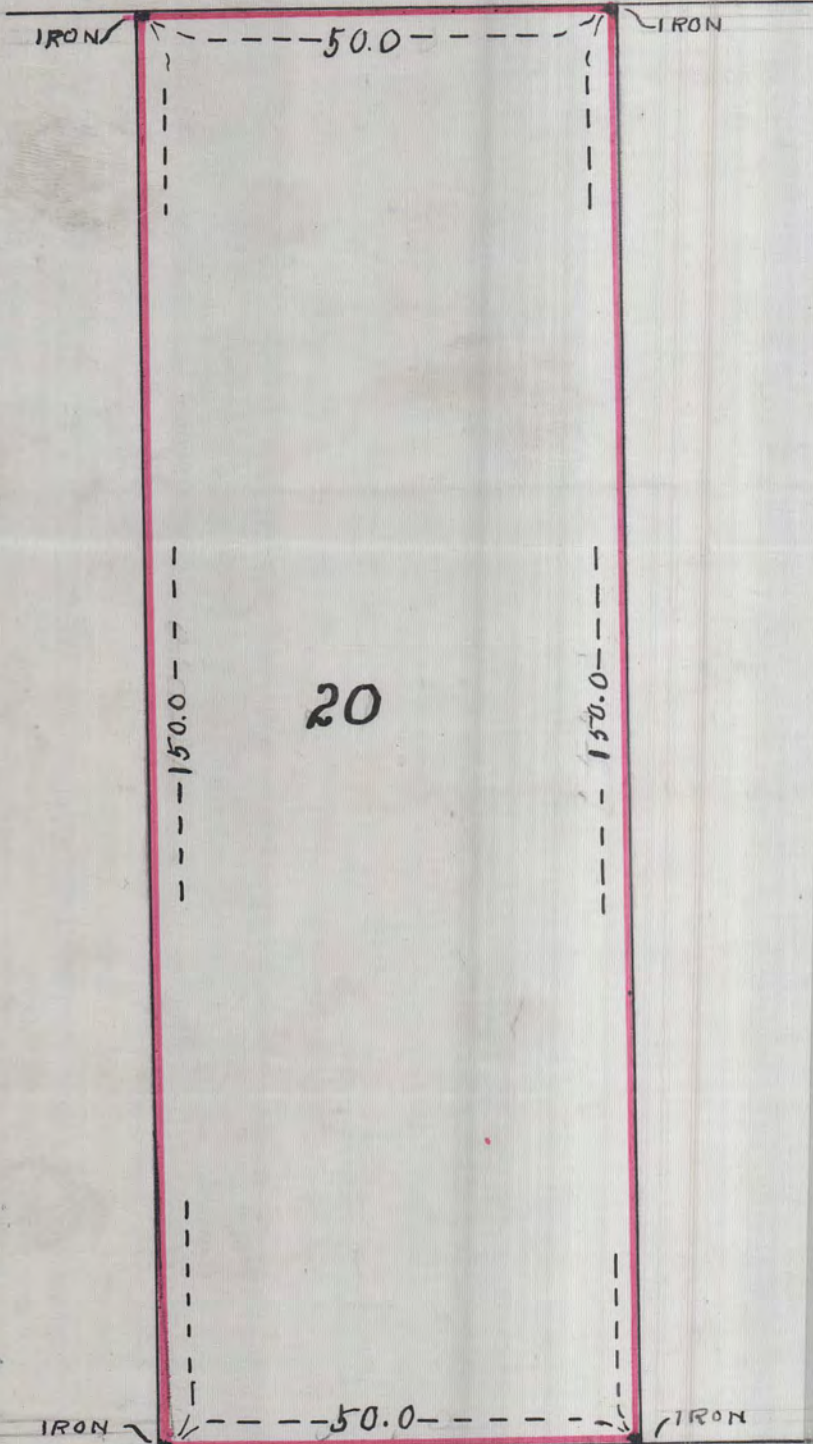

66 LINCOLN AVE.

1967