

LOTS 44, 46, 47 & 48  
 A. VANCE BROWN'S SUBN.  
 BLOCK 9.


STINSON, BROWN & RAMSEY'S ADD.

JOHN B. IRVINE, SURVEYOR.

ST. PAUL,

SEPT. 19-1916.

Scale. 20ft. per inch.

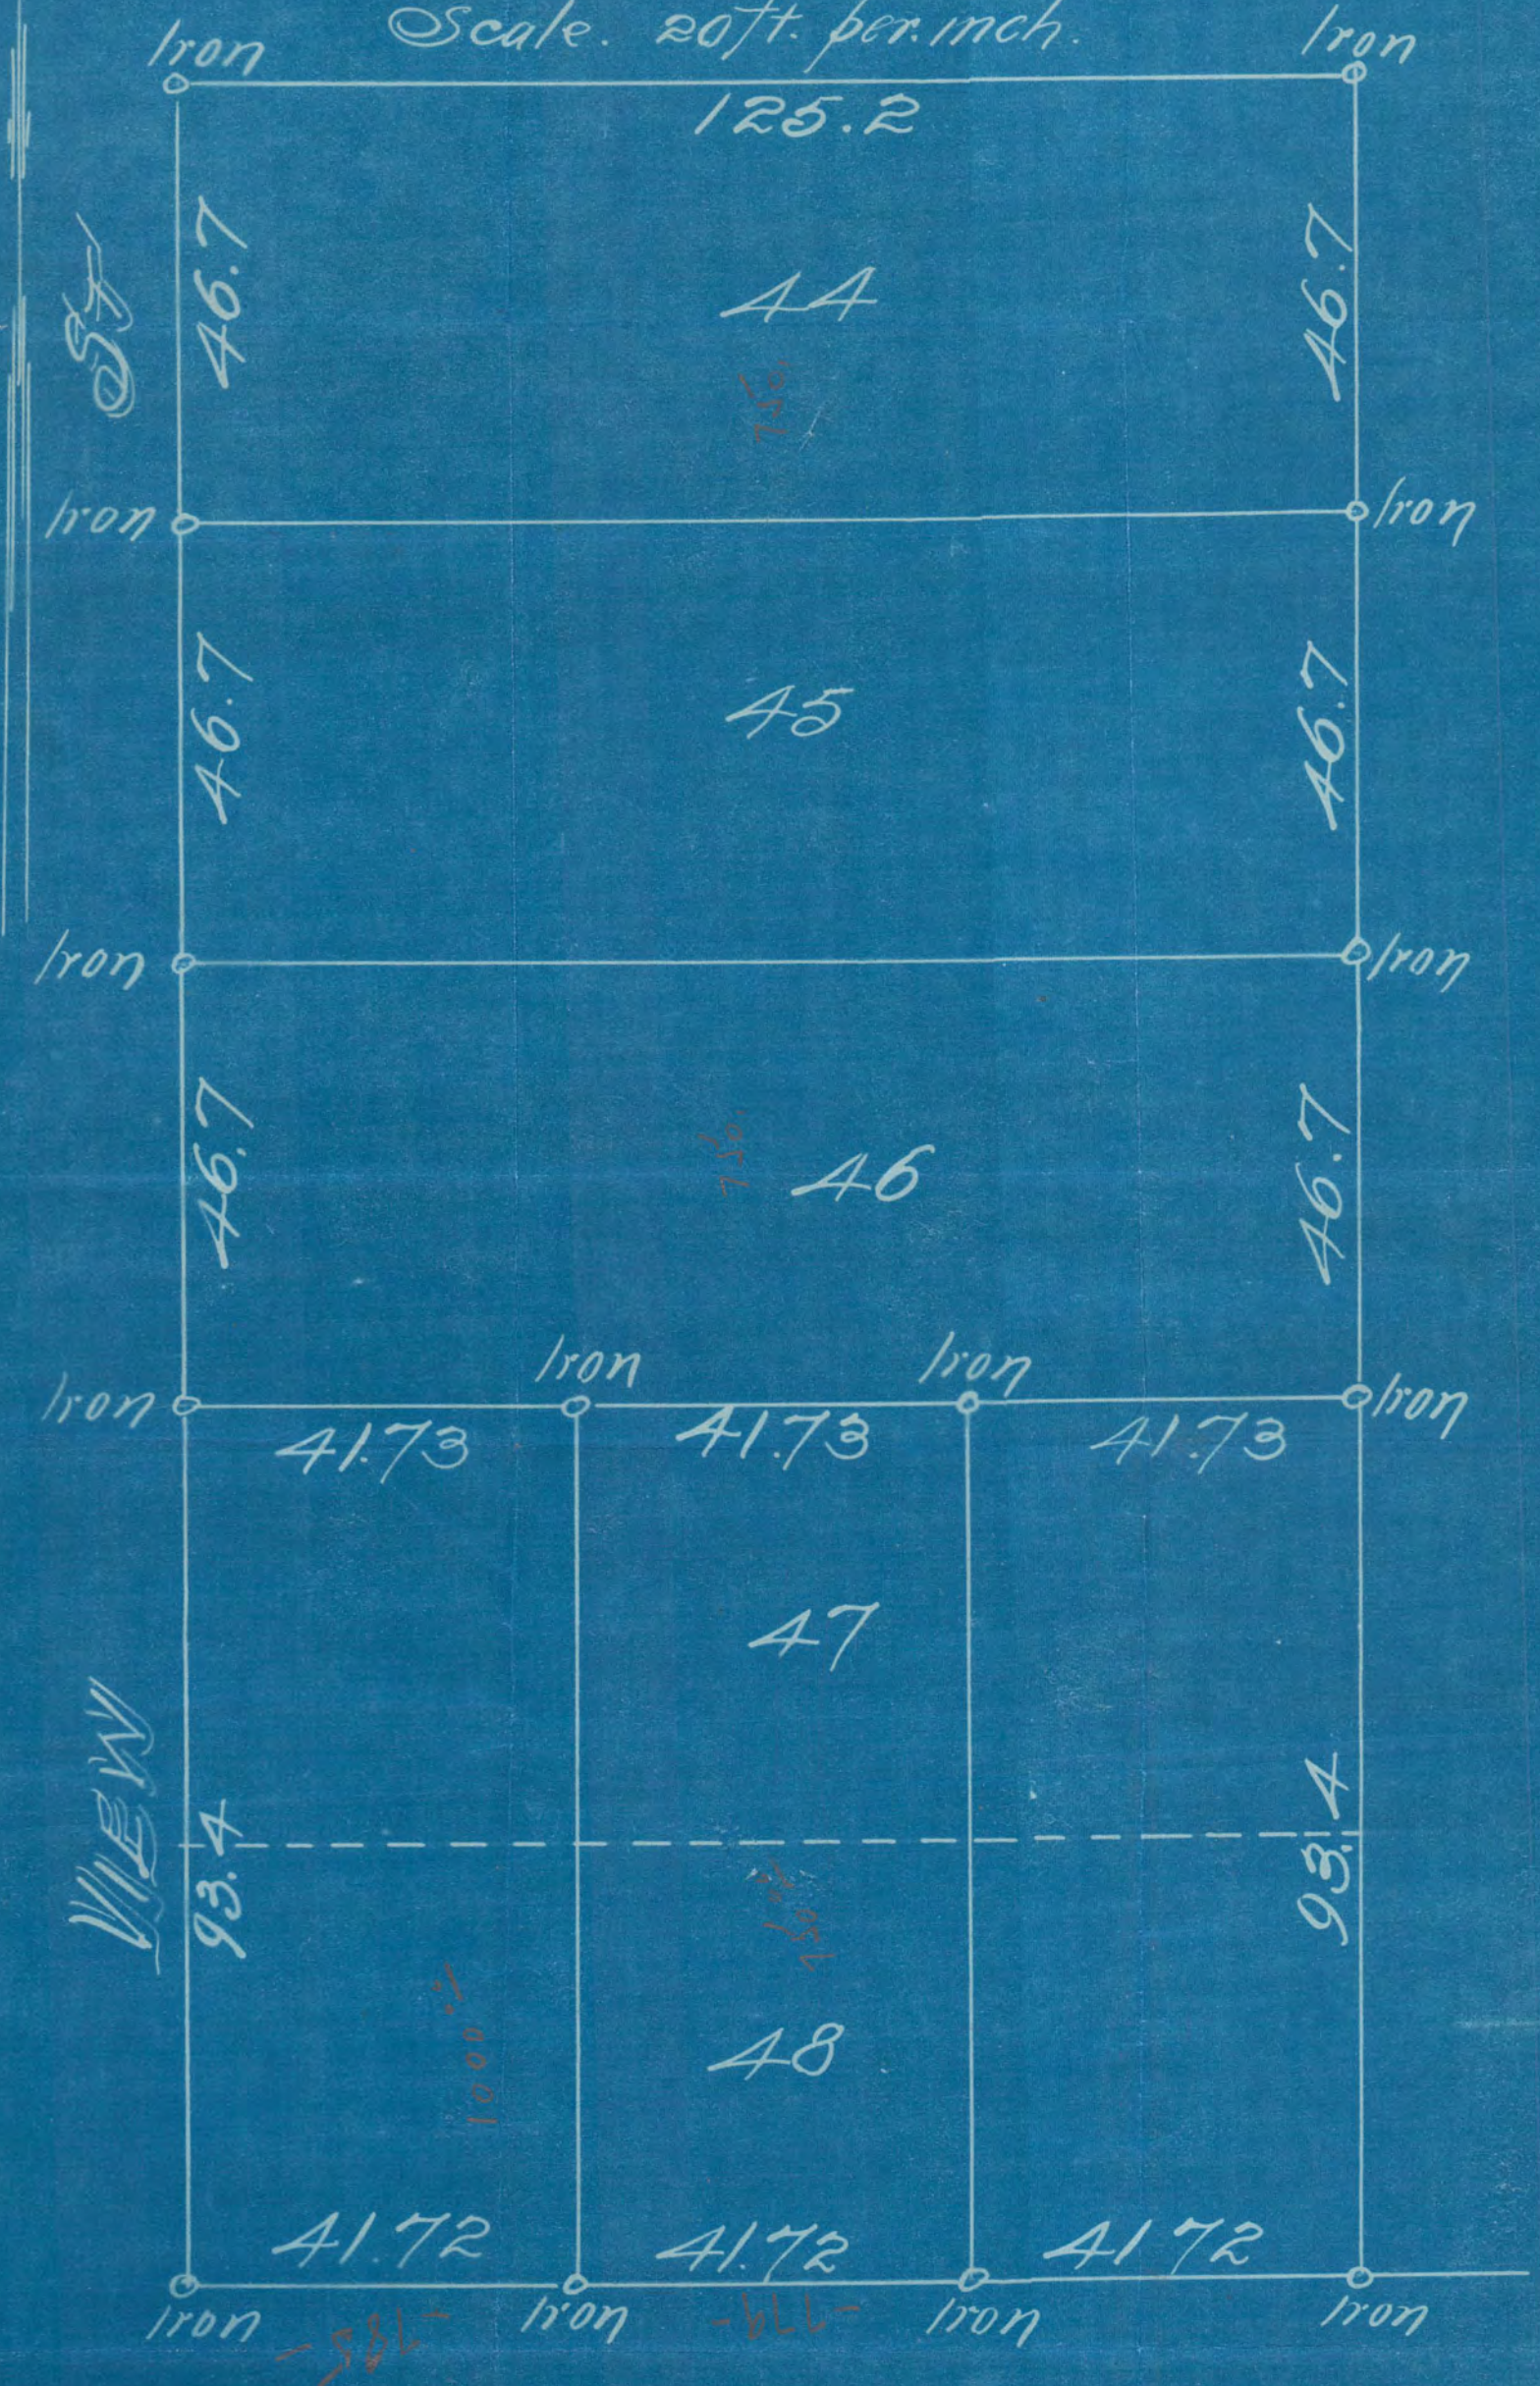

JEFFERSON AVE.