


SURVEY OF LOT 8, BLOCK 34
RICE AND IRVINES ADDN.

Scale 10 ft. per inch

Feb. 1917

J. L. Anthony
Surveyor

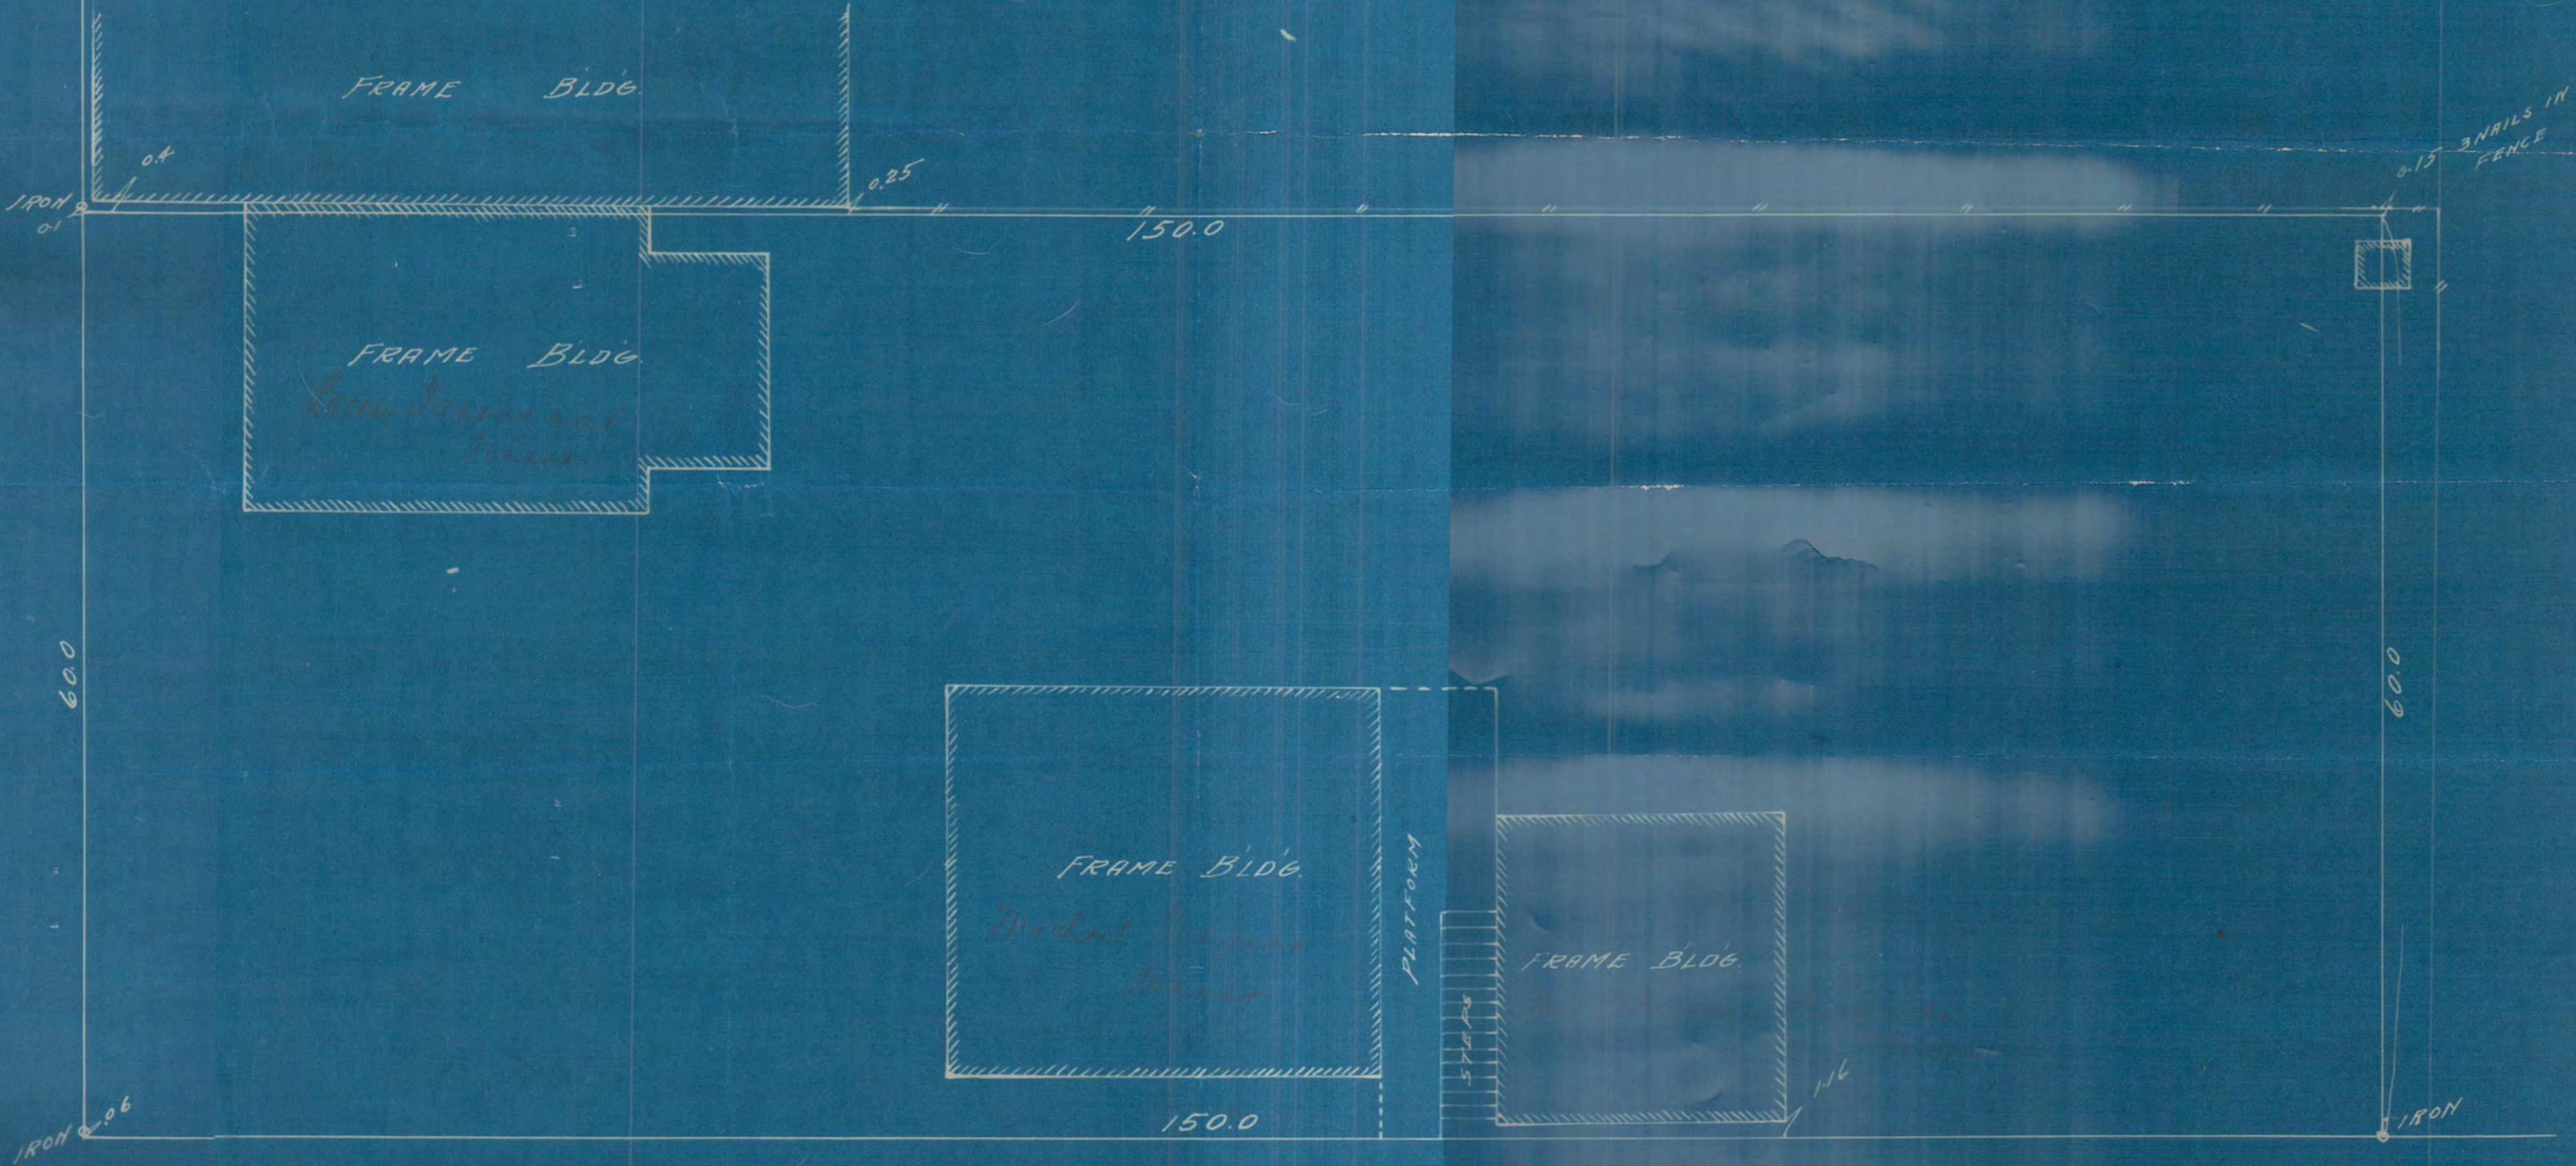

FRANKLIN ST.

FRANKLIN ST.

CHESTNUT ST.

CHESTNUT ST.

2085