

2088

2088

# Mc KENTY'S OUT LOTS

SURVEY OF

LOT 15,  
FEB., 21, 1917.


BLK. 3.

JENS PEDERSEN  
SURVEYOR & CIVIL ENGINEER.

SCALE 1"=10'

MILFORD

ST.

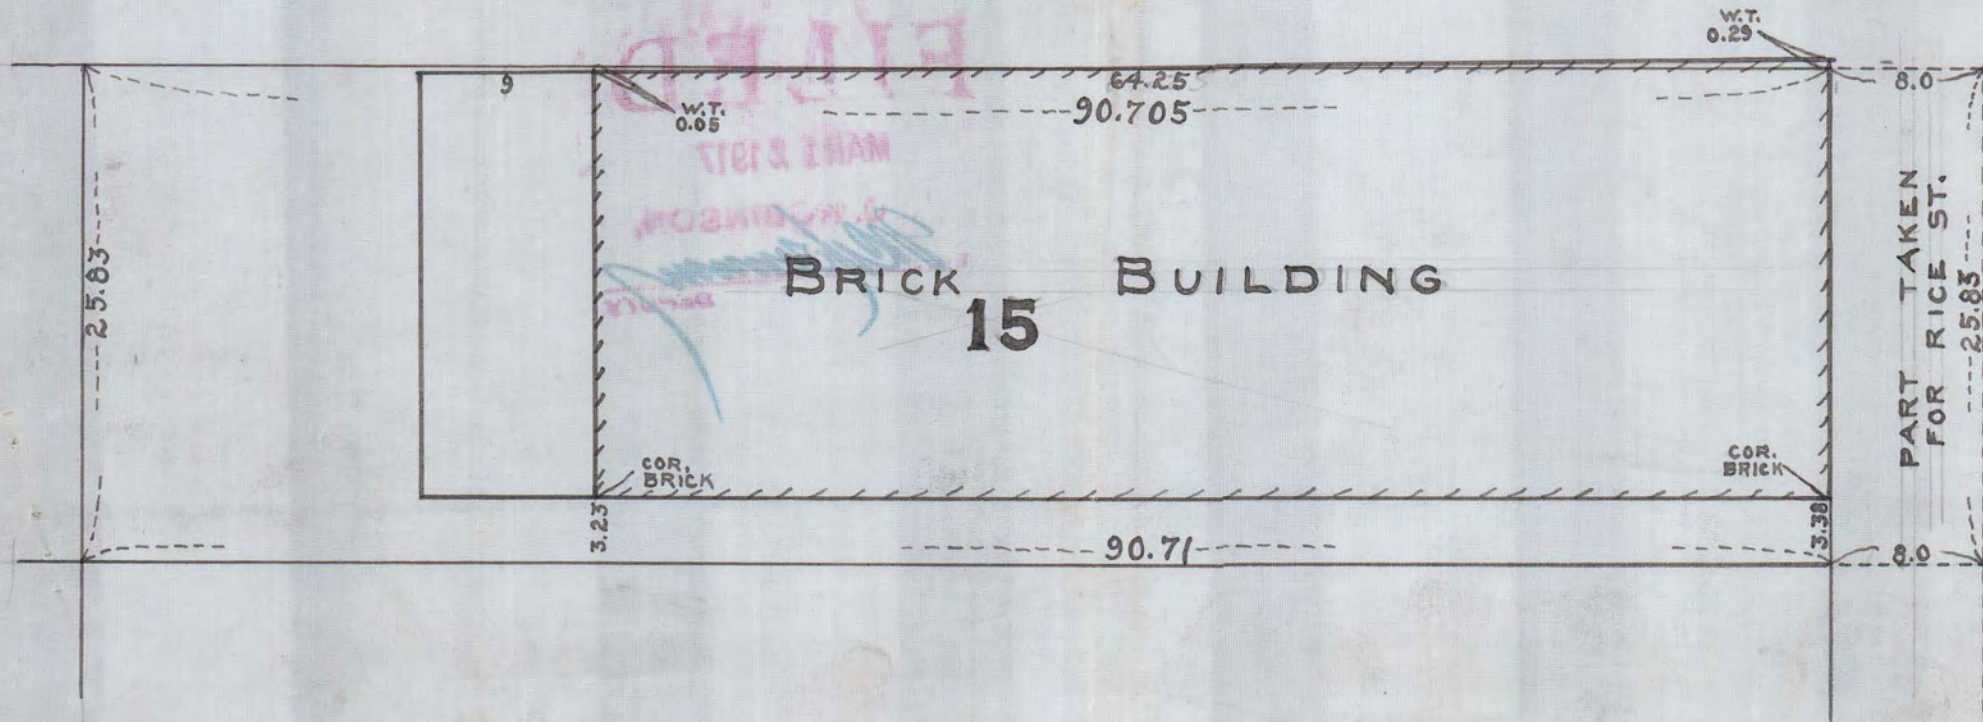

FILED  
MAY 18 1917  
J. W. BISHOP  
REGISTERED

RICE ST.

# 2088