


PART OF LOT 4 BLOCK 53
WEST ST. PAUL PROPER.

JOHN B. IRVINE, SURVEYOR.
ST. PAUL, MINN.
DEC. 1-1917.

Scale 20 ft. per inch.

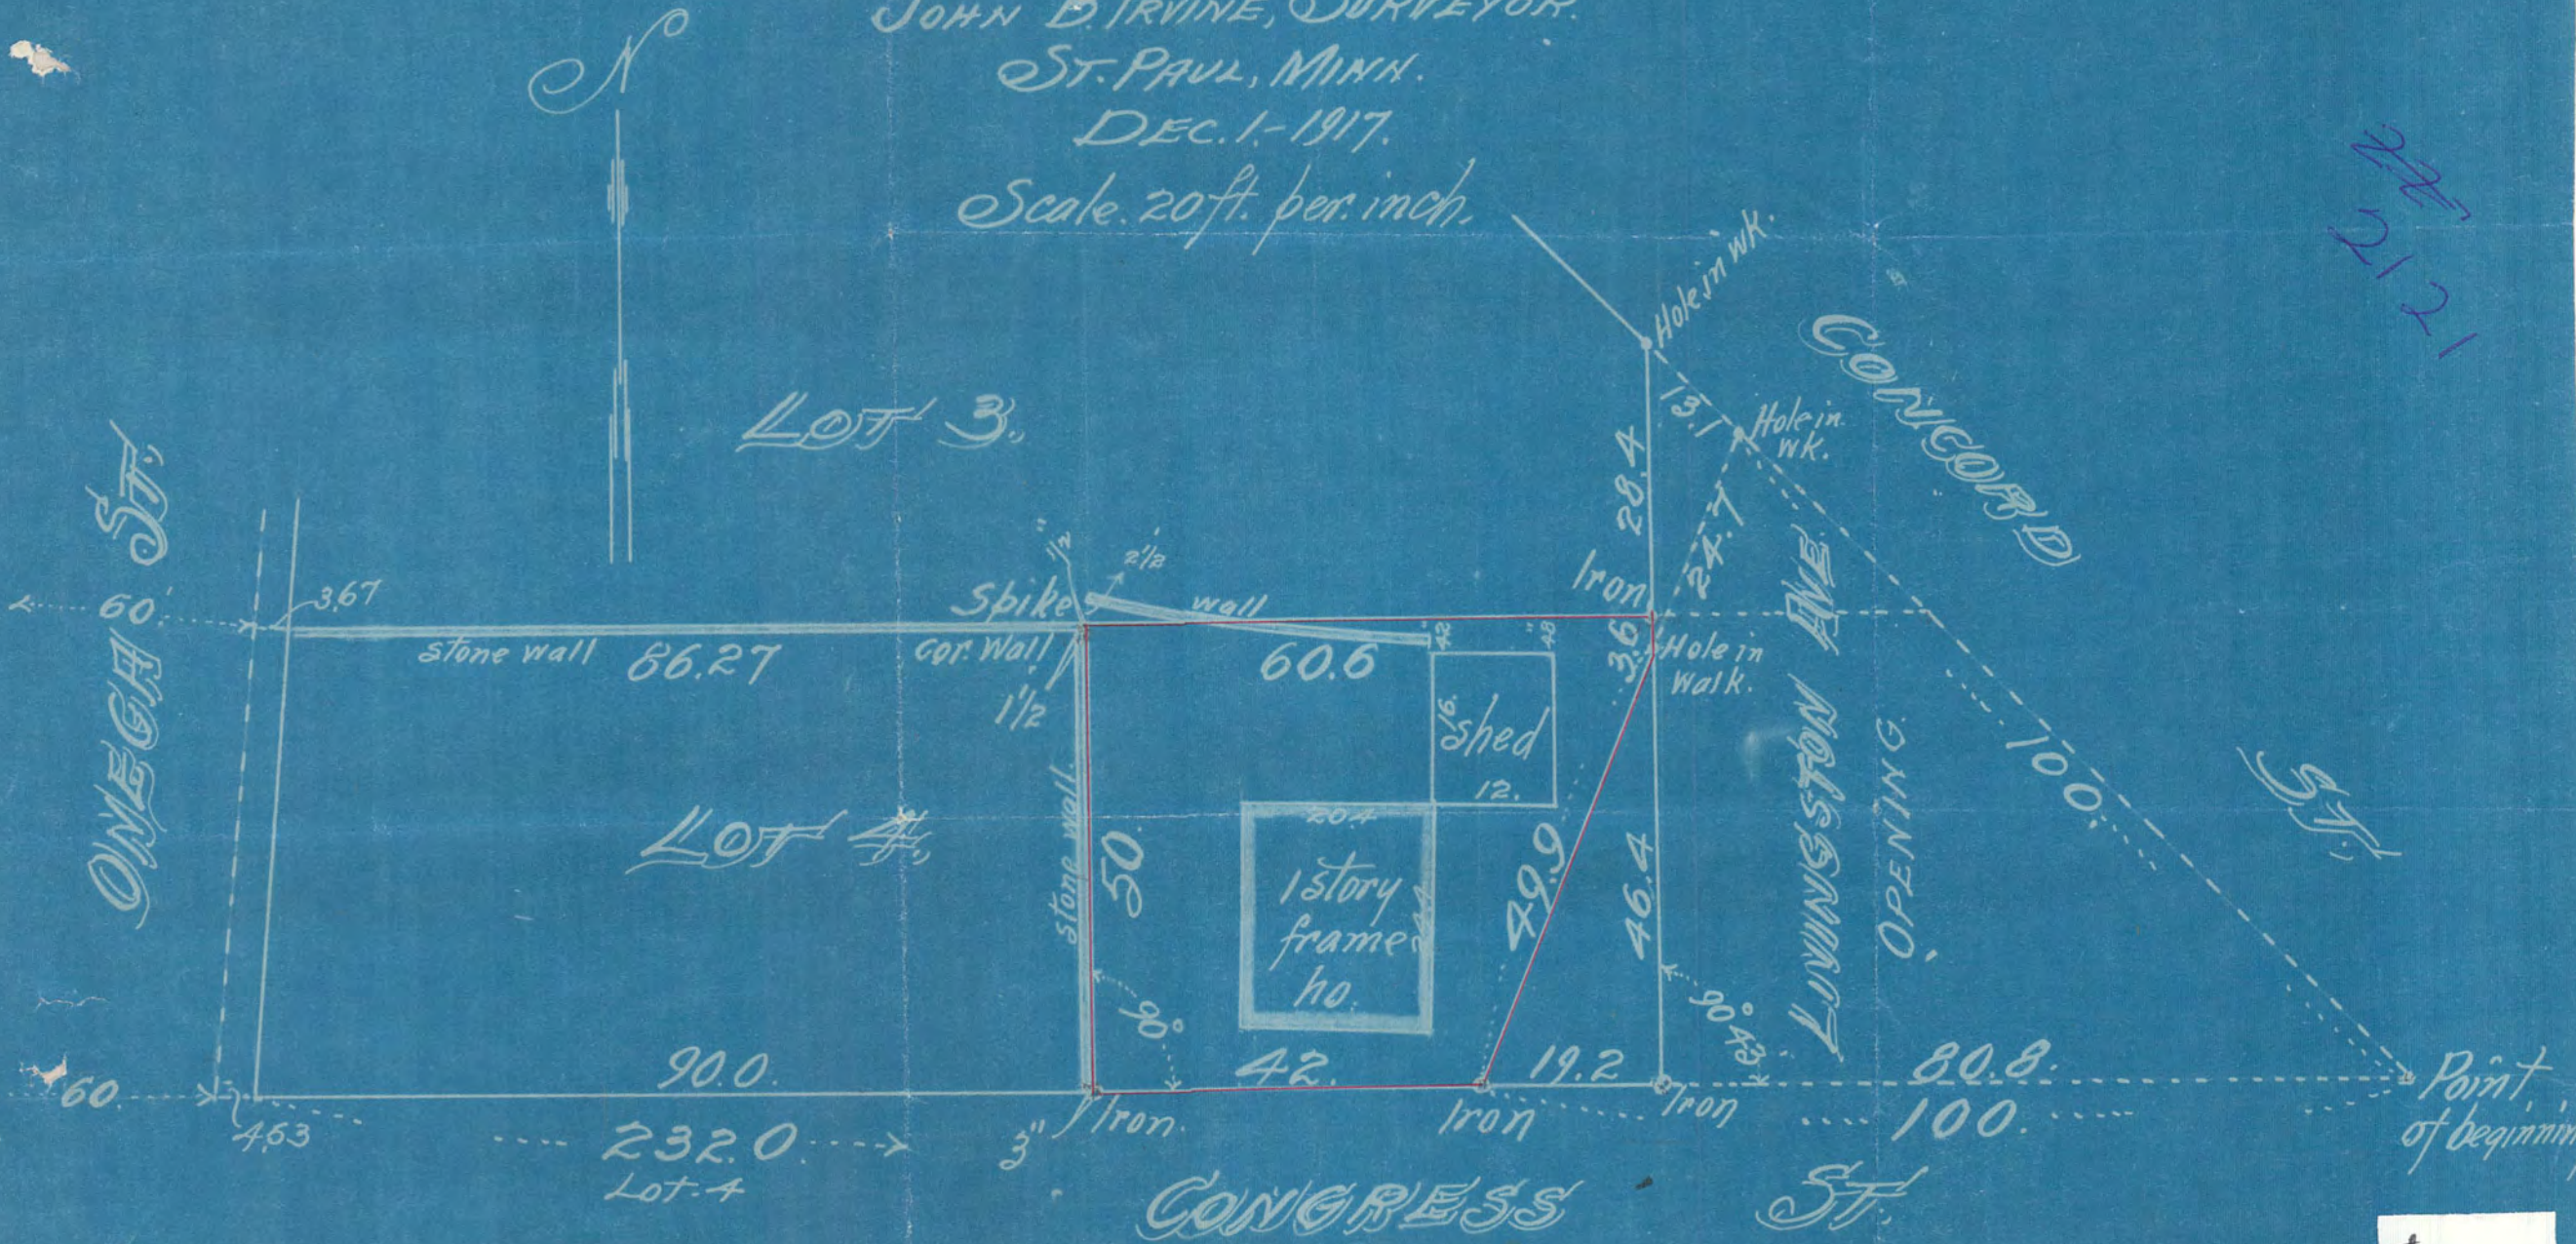

2121

2121